

W 238 S 3712 BIG BEND ROAD
WAUKESHA, WIS. 53186


TELEPHONE
542-5616

RONALD H. ZIMMERMAN
REGISTERED LAND SURVEYOR

PLAT OF SURVEY

FOR

WAUKESHA SAVINGS & LOAN

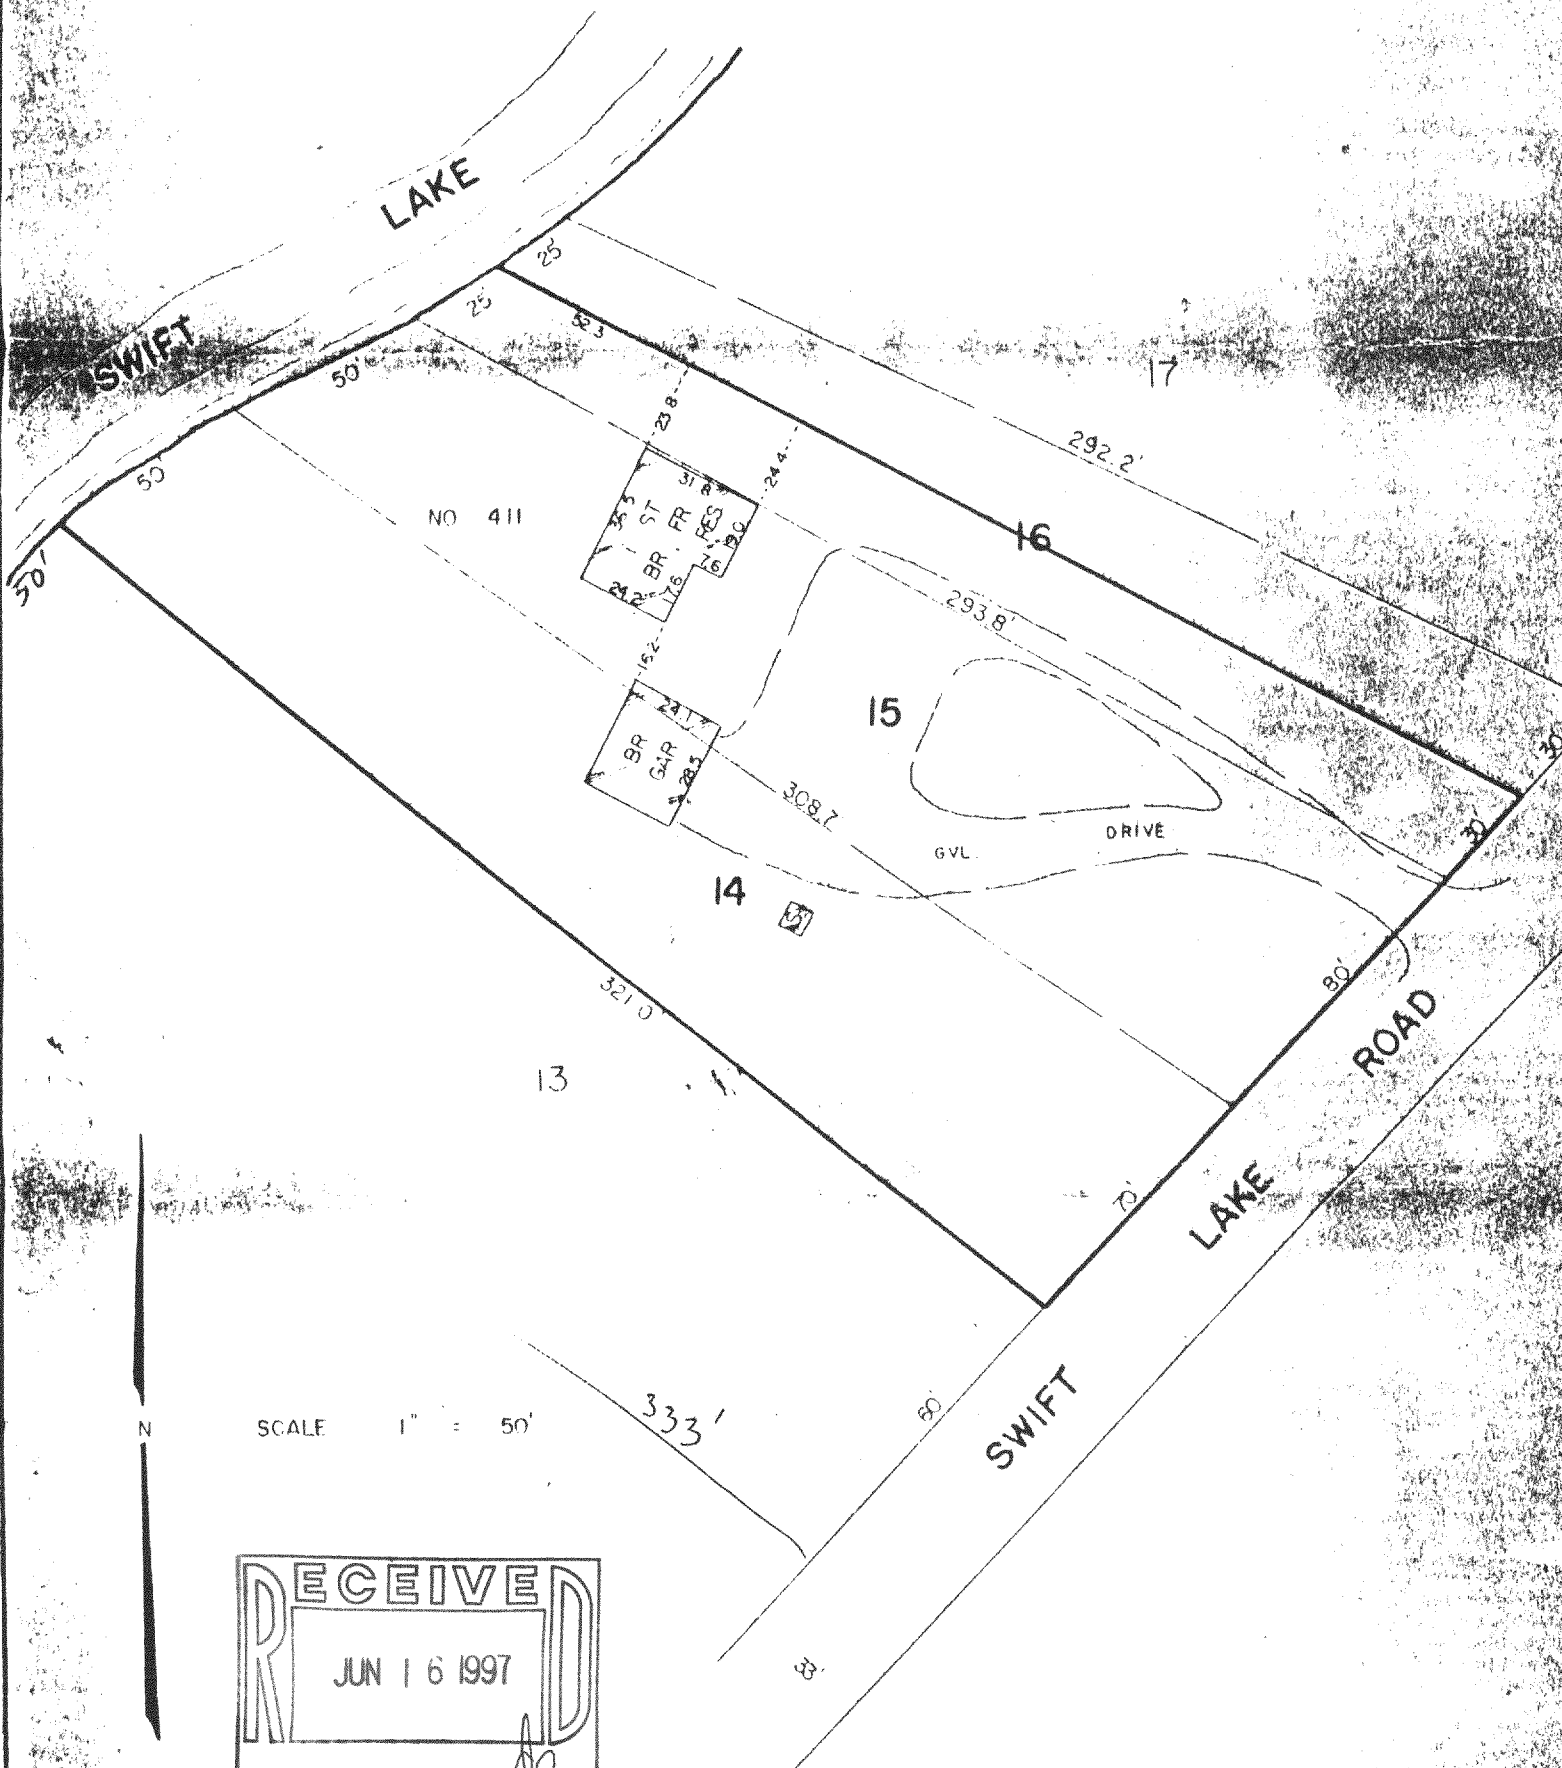

CERTIFICATION

STATE OF WISCONSIN)
COUNTY OF WAUKESHA) SS

I, RONALD H. ZIMMERMAN, REGISTERED LAND SURVEYOR, DO HEREBY CERTIFY THAT I HAVE MADE A SURVEY
OF LOTS 14, 15 & 16, BLK 2, SWIFT LAKE SUB'D, TOWN OF TROY
AND THE EXISTING BUILDING AND IMPROVEMENTS LOCATED THEREON AND THAT THE PLAT HEREWITH DRAWN
IS A CORRECT REPRESENTATION OF SAID SURVEY.

DATE NOV. 20, 19 72.

LSL-18
LSL-19

417-500

RONALD H. ZIMMERMAN

S - 868

