

PLAT OF SURVEY


PARCEL 2, OF CERTIFIED SURVEY MAP NO. 783,
BEING A PART OF THE SOUTHWEST 1/4 OF SECTION
11, TOWN 4 NORTH, RANGE 17 EAST, TOWN OF IRON,
WALNORTH COUNTY, WISCONSIN.

LAND TO BE PURCHASED

THAT PART OF THE SOUTHWEST 1/4 OF
SECTION 11, TOWN 4 NORTH, RANGE 17 EAST,
IN THE TOWN OF IRON, WALNORTH COUNTY,
WISCONSIN, DESCRIBED AS FOLLOWS:
COMMENCING AT THE NORTHEAST CORNER
OF SAID SOUTHWEST 1/4, THENCE
NORTH 89°46'25" WEST ALONG THE
NORTH LINE OF SAID SOUTHWEST 1/4,
300.00 FEET TO THE PLACE OF BEGINNING;
THENCE SOUTH ALONG THE WEST LINE OF
PARCEL 2 OF CERTIFIED SURVEY MAP NO.
783, 384.52 FEET; THENCE WEST ALONG
THE NORTH LINE OF PARCEL NO. 1 OF SAID C.S.M., 300.00
FEET; THENCE NORTH 385.71' FEET TO THE
NORTH LINE OF SAID SOUTHWEST 1/4; THENCE
SOUTH 89°46'25" EAST ALONG THE NORTH
LINE OF SAID SOUTHWEST 1/4, 300.00 FEET
TO THE PLACE OF BEGINNING.

SURVEYED FOR: DAVID DUFEX

SCALE 1"=40'

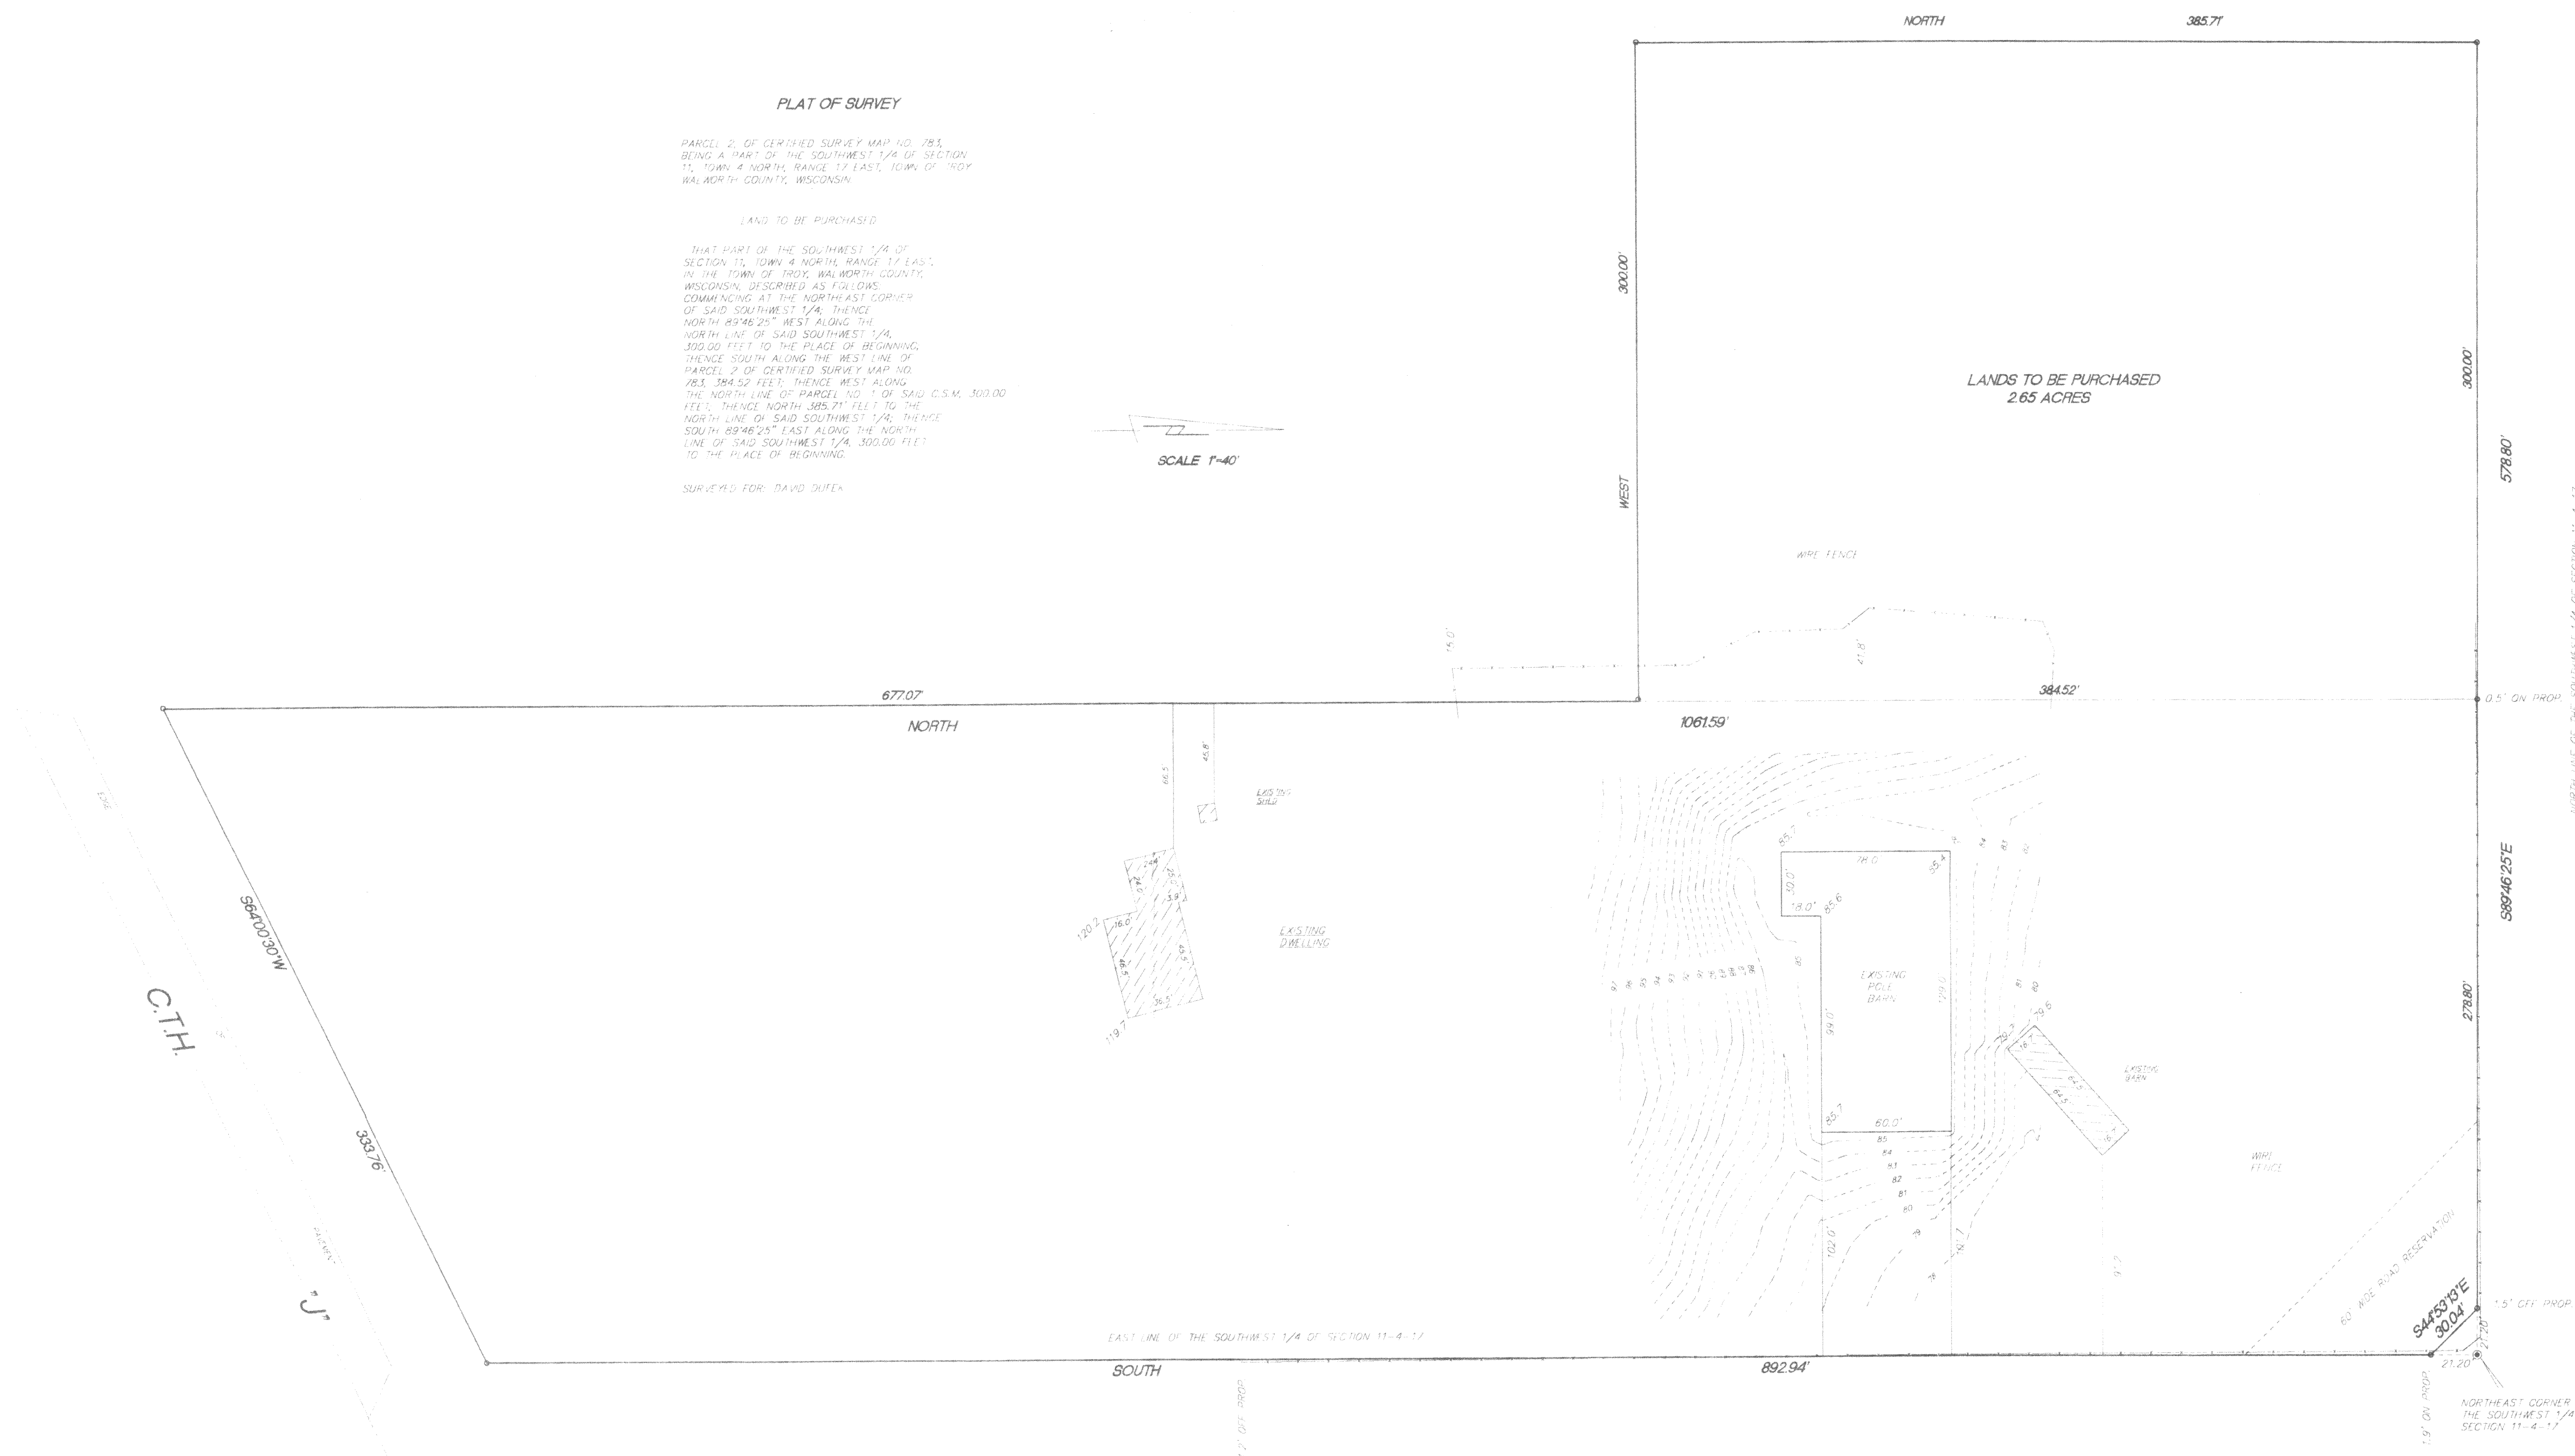

- FOUND 1" IRON PIPE
- FOUND 2" IRON PIPE
- 8.6 SPOT ELEVATIONS

I hereby certify that I have surveyed the above property and that the above map is a true representation thereof and shows the size and location of the property, exterior boundaries, the location of all visible structures and operations of all existing buildings thereon, boundary lines, adjacent easements, roadways and encroachments, if any.

This survey is made for the use of the present owners of the property, and also those who purchase, mortgage or otherwise acquire the title thereto within one year from date hereof.

DATE: 5/14/97
DRAWN BY: J.P.
JOB NUMBER: 92079

Kettle Moraine Surveying
W362 S10227 Lewin Lane
Eagle WI 53119
(414) 594-3484

THIS IS NOT AN ORIGINAL SURVEY UNLESS THE SEAL IS RED

