

ABERNATHY and ASSOCIATES


Kenneth B. Abernathy Jr.

Wisconsin Registered Land Surveyor S-1594

Rt. 3, Box 273
Elkhorn, Wisconsin 53121
Phone: (414) 723-4260 (office)
(414) 723-7209 (FAX)

PLAT OF SURVEY

LOT 11, BLOCK 2, SWIFT LAKE SUBDIVISION, LOCATED IN
THE SE 1/4 OF SECTION 8, TOWN 4 NORTH, RANGE 17 EAST,
TROY TOWNSHIP, WALWORTH COUNTY, WISCONSIN.

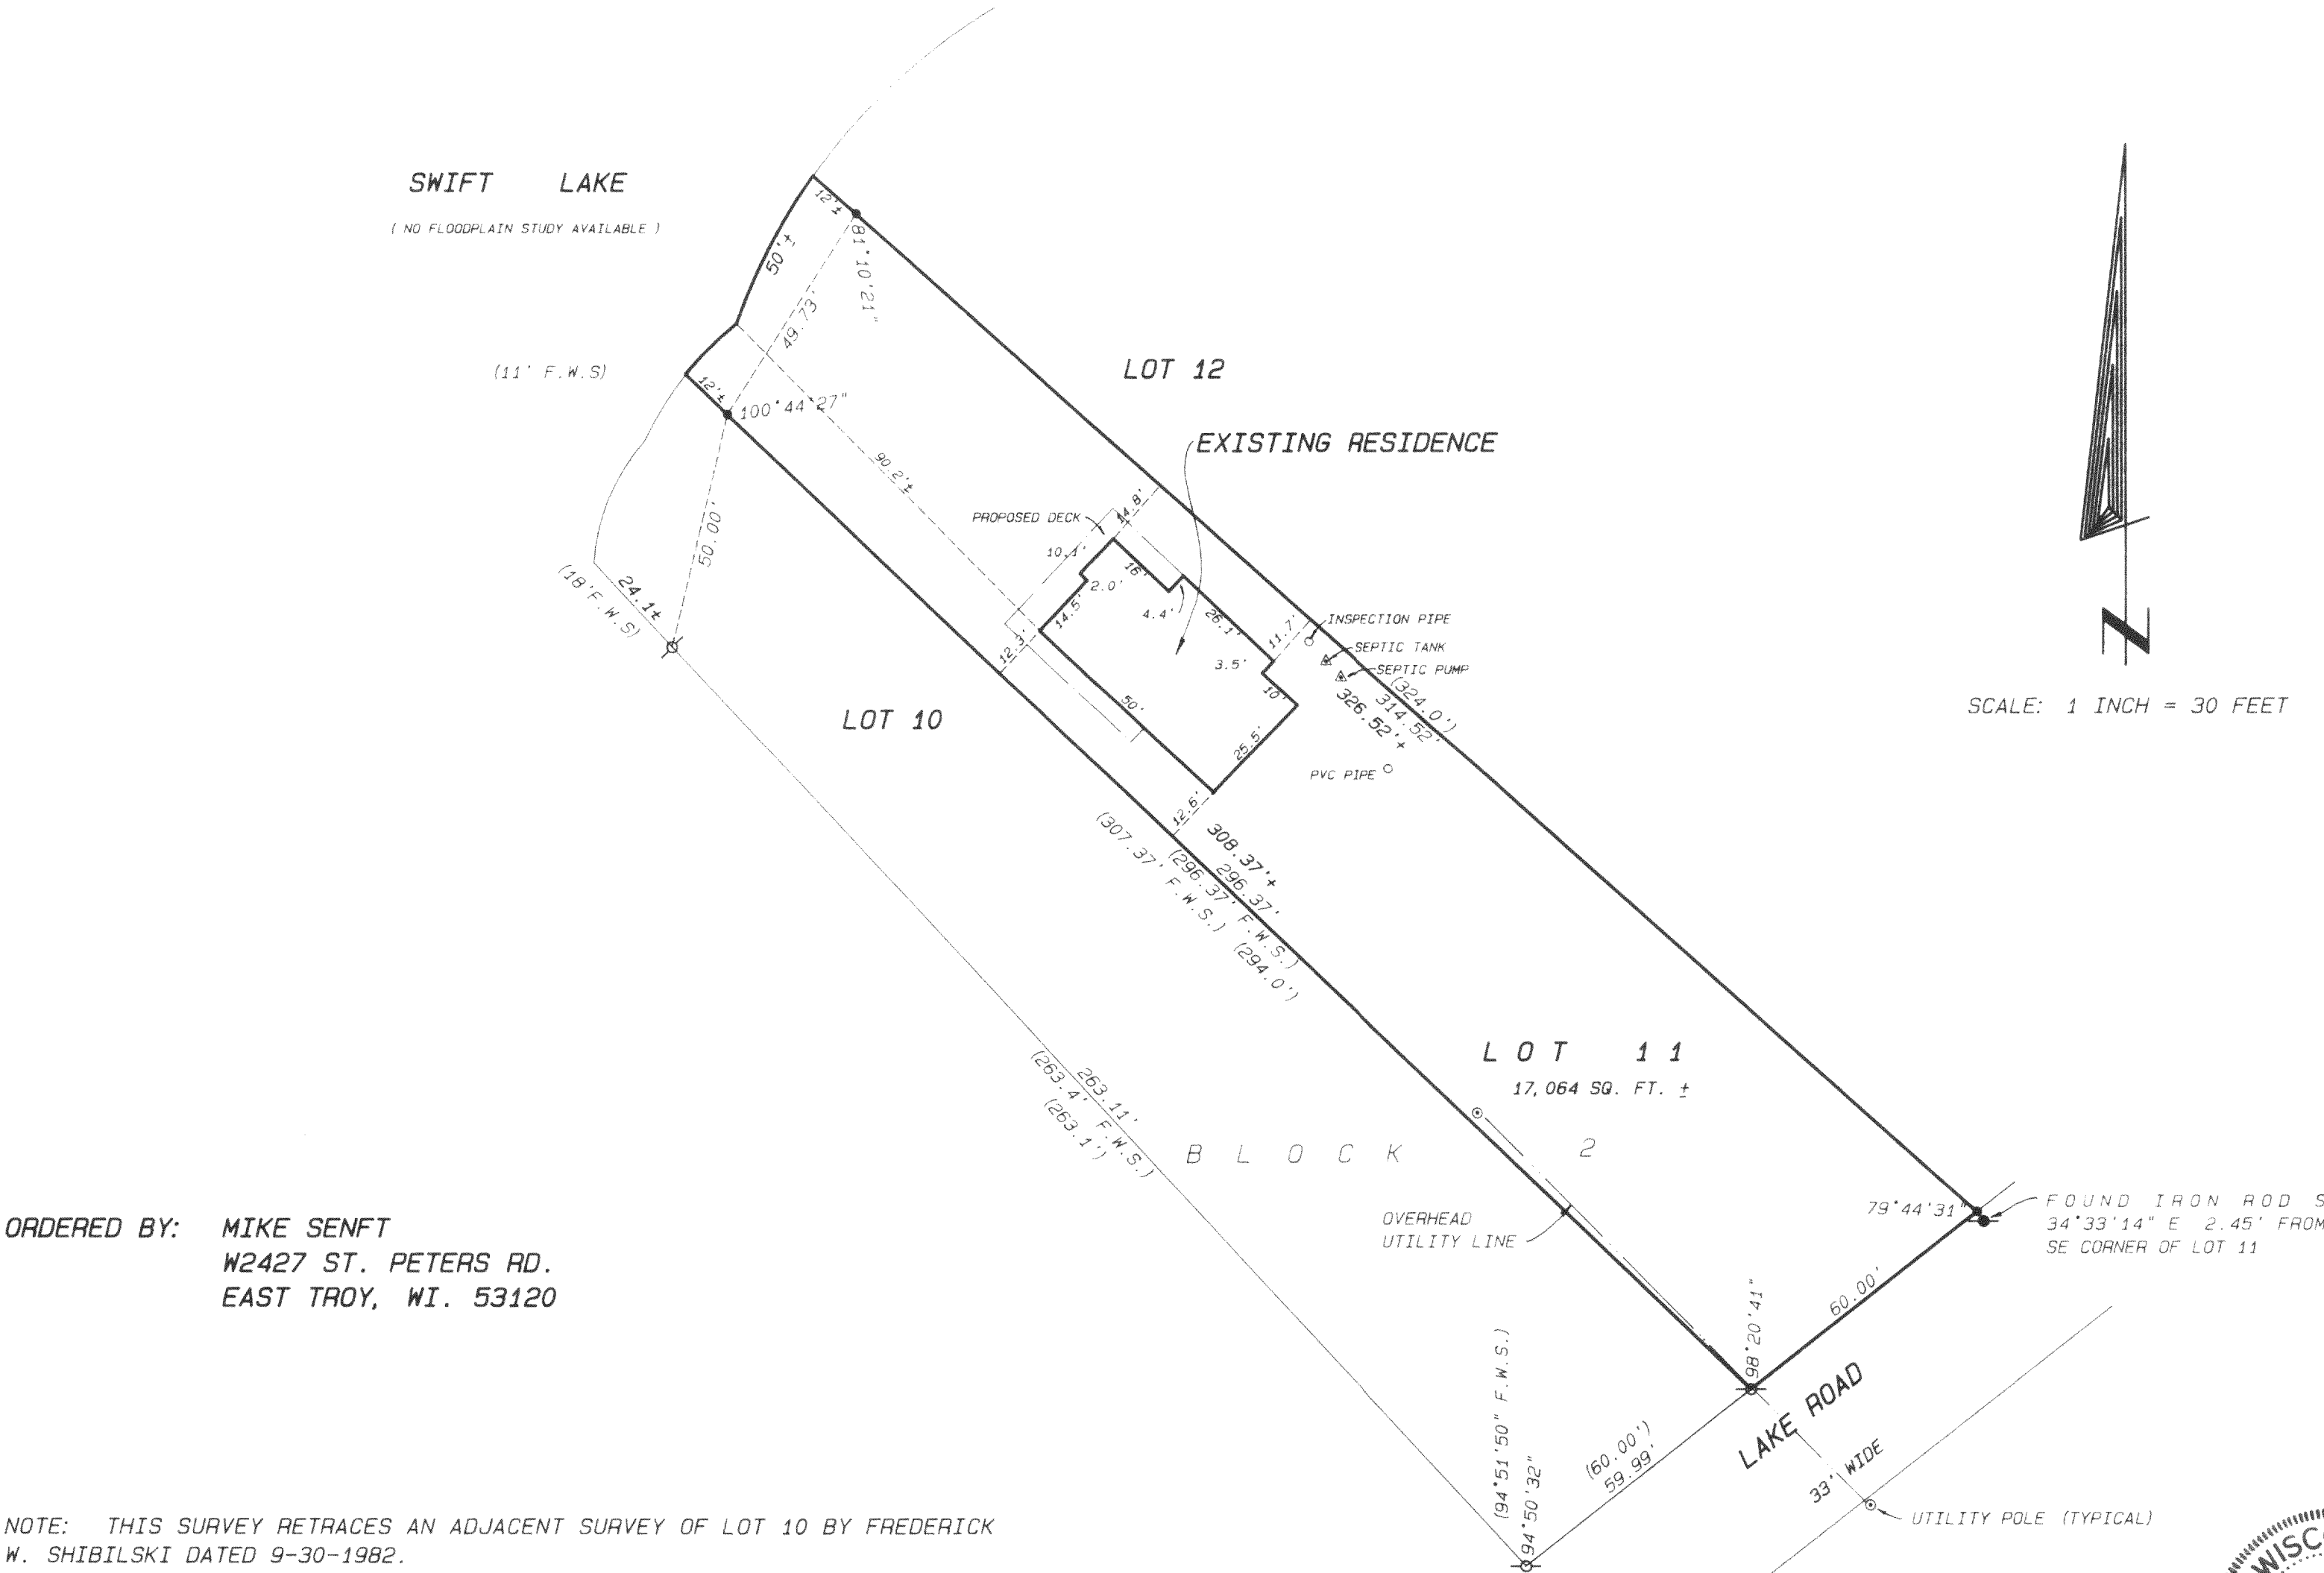

ORDERED BY: MIKE SENFT
W2427 ST. PETERS RD.
EAST TROY, WI. 53120

NOTE: THIS SURVEY RETRACES AN ADJACENT SURVEY OF LOT 10 BY FREDERICK
W. SHIBILSKI DATED 9-30-1982.

REVISED 9/9/97 TO SHOW PROPOSED RESIDENCE AND DECK
REVISED 11/4/97 TO SHOW "AS BUILT RESIDENCE"

KENNETH B. ABERNATHY, JR.,
WISCONSIN REGISTERED LAND SURVEYOR,
S-1594

Date: JANUARY 31, 1997 Job No. 97.110

DESIGN PRODUCTS 082-001

417-515
LSC-15