

REGIONAL CONSULTING ENGINEERS, INC.





PROFESSIONAL ENGINEERS AND SURVEYORS

MILWAUKEE, WISCONSIN

PHONE 464-4638


4842 NO. 88TH ST.

PLAT OF SURVEY

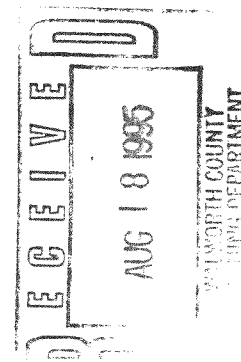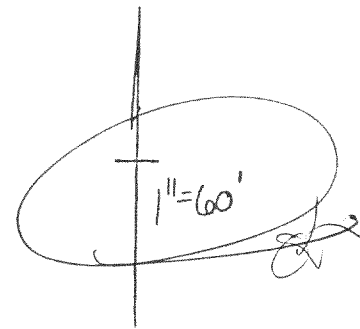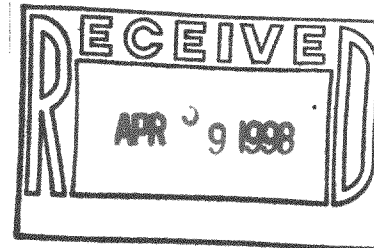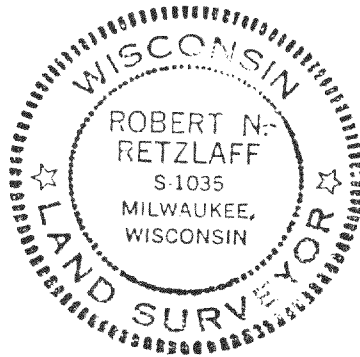

LH-2

DESCRIPTION: Lot 3 of PLAT OF HULTQUIST'S SUBDIVISION, being a part of the Northeast 1/4 of Section 24, Township 4 North, Range 17 East, in the Town of Troy, Walworth County, State of Wisconsin.
OWNER: Wolf-3496 Booth Lake Heights Road
REQUESTED BY: North Shore Savings and Loan Assoc. and/or its assigns
ATTEN: Patsy

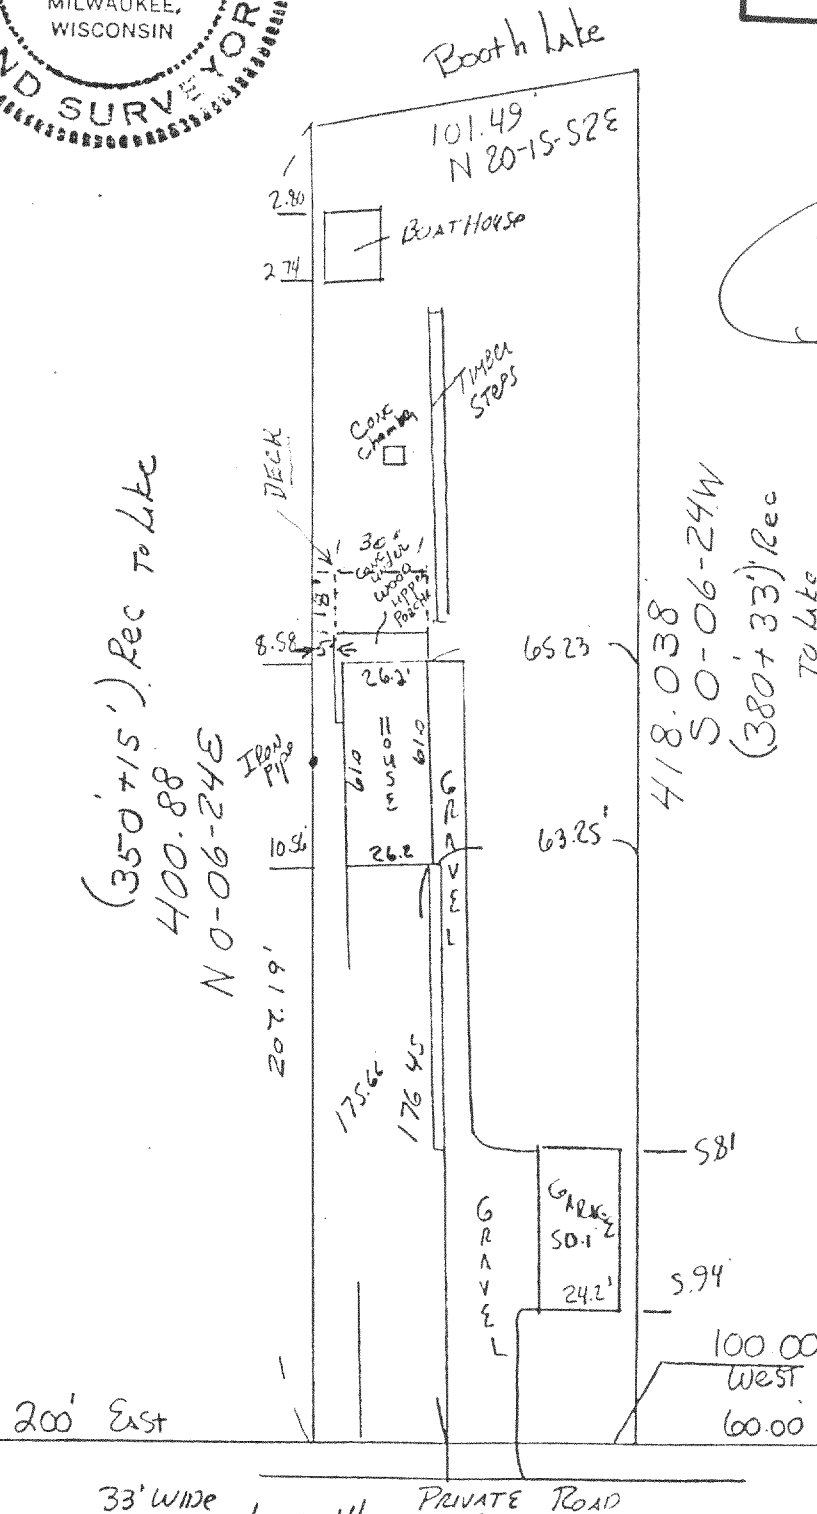

EXIST IP

417-522

UNLOCKED
STEEL GATE
ACROSS ROAD