

Wisconsin Registered Land Surveyor S-1594

Rt. 3, Box 273
Elkhorn, Wisconsin 53121
Phone: (414) 723-4260 (office)
(414) 723-4813 (residence)

PLAT OF SURVEY


LOT 8 OF APPLE WOOD ESTATES, BEING A SUBDIVISION
IN THE NORTHWEST 1/4 OF THE NORTHEAST 1/4 OF
SECTION 25, TOWN 4 NORTH, RANGE 17 EAST, TROY
TOWNSHIP, WALWORTH COUNTY, WISCONSIN.

BUILDERS: KAISER BUILDING AND DESIGN, INC.
P.O. BOX 1166
JANESVILLE, WI. 53547-1166

LOT 7

OWNERS: CHRISTOPHER AND SUSAN PECK
820 HAZEL RIDGE RD. # 604
ELKHORN, WI. 53121

SUBJECT PROPERTY: N8043 NICKY CT.
EAST TROY, WI.

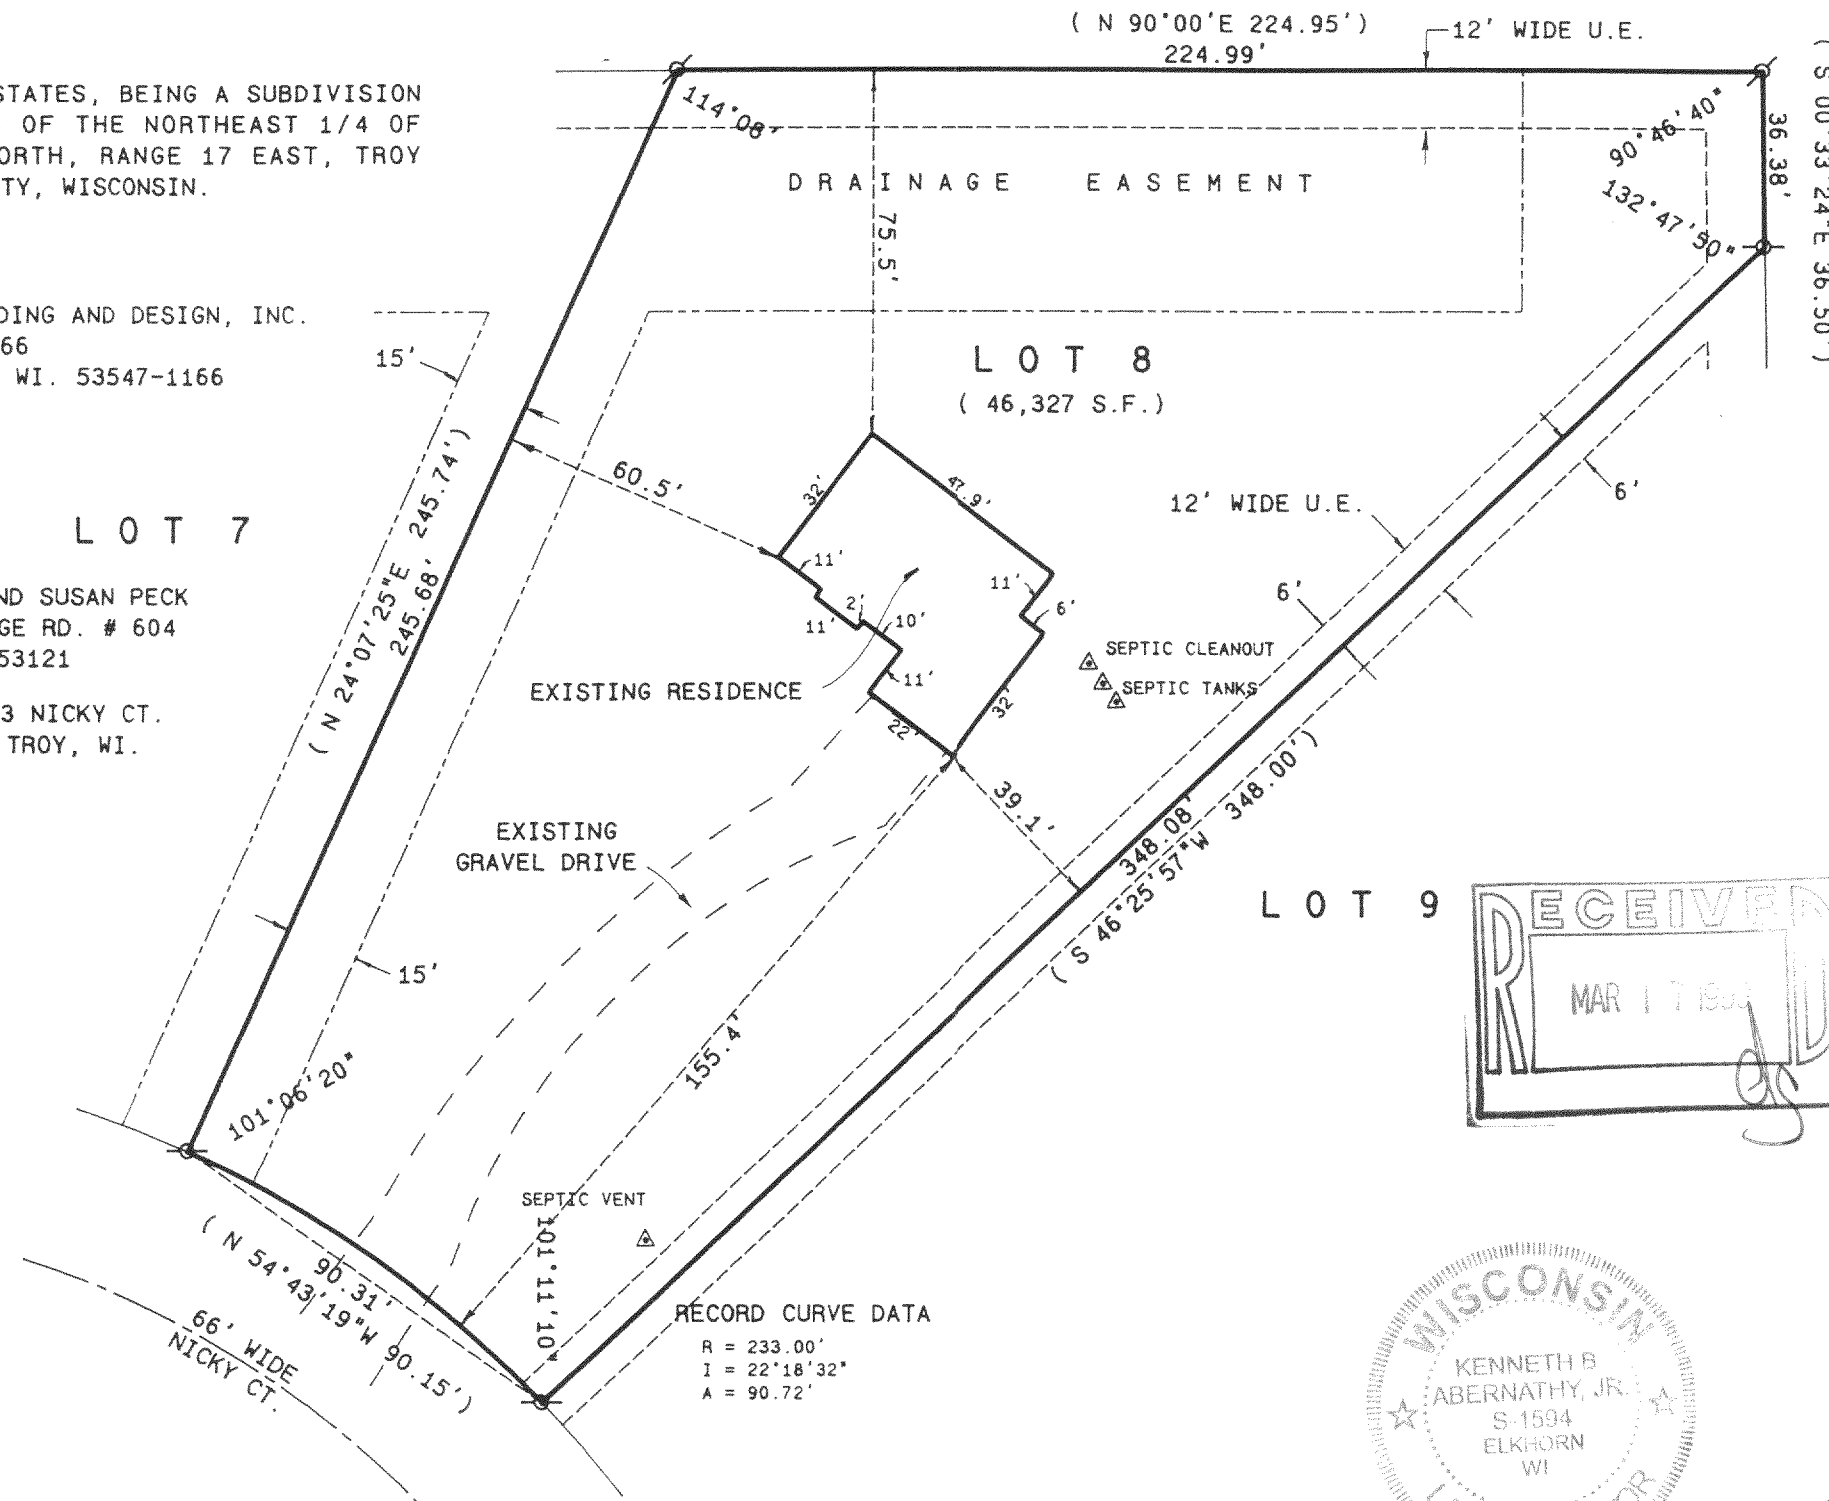

SCALE: 1" = 40 FEET

Legend

-  FOUND IRON PIPE
 FOUND IRON ROD
 FOUND BRASS CAPPED MONUMENT
 FOUND CONCRETE MONUMENT
 CHISEL CUT IN CONCRETE
 SET IRON ROD, 24" LONG, WEIGHING
1.5 LBS./LINEAL FT., 3/4" DIA.
 SET IRON ROD, 30" LONG, WEIGHING
4.5 LBS./LINEAL FT., 1-11/16" DIA.
(x x) RECORDED AS DIMENSION
— x — x — EXISTING FENCE

"I hereby certify that I have surveyed the above described property and that the above map is a true representation thereof and shows the size and location of the property, its exterior boundaries, the location of all visible structures and dimensions of all principal buildings thereon, boundary fences, apparent easements, roadways and visible encroachments, if any."

"This survey is made for the use of the present owners of the property, and also those who purchase, mortgage, or guarantee the title thereto within one year from date hereof."

Kenneth B. Abernathy

KENNETH B. ABERNATHY, JR.
WISCONSIN REGISTERED LAND SURVEYOR,
S-1594

Date: DECEMBER 21, 1998 Job No. 98.1208

LAP-8

417-551