

Plat of Survey

of


Lot 1 of Certified Survey Map No. 3048,

recorded in Vol. 16 of Certified Survey Maps of Walworth County on Page 183 being a redivision of Lot 1 of Certified Survey Map No. 3048 and Lot 5 of Avo Sunset Park, located in the Southeast 1/4 of Section 13, Town 4 North, Range 17 East, Town of Troy, Walworth County, Wisconsin.


Surveyed for: **Rick & Susan Strieter**
N8605 Town Line Road
East Troy, Wisconsin. 53120

Note: The proposed garage addition is shown as instructed by the owner. All setbacks must be approved by the Building Inspector PRIOR to construction.

Booth
Lake

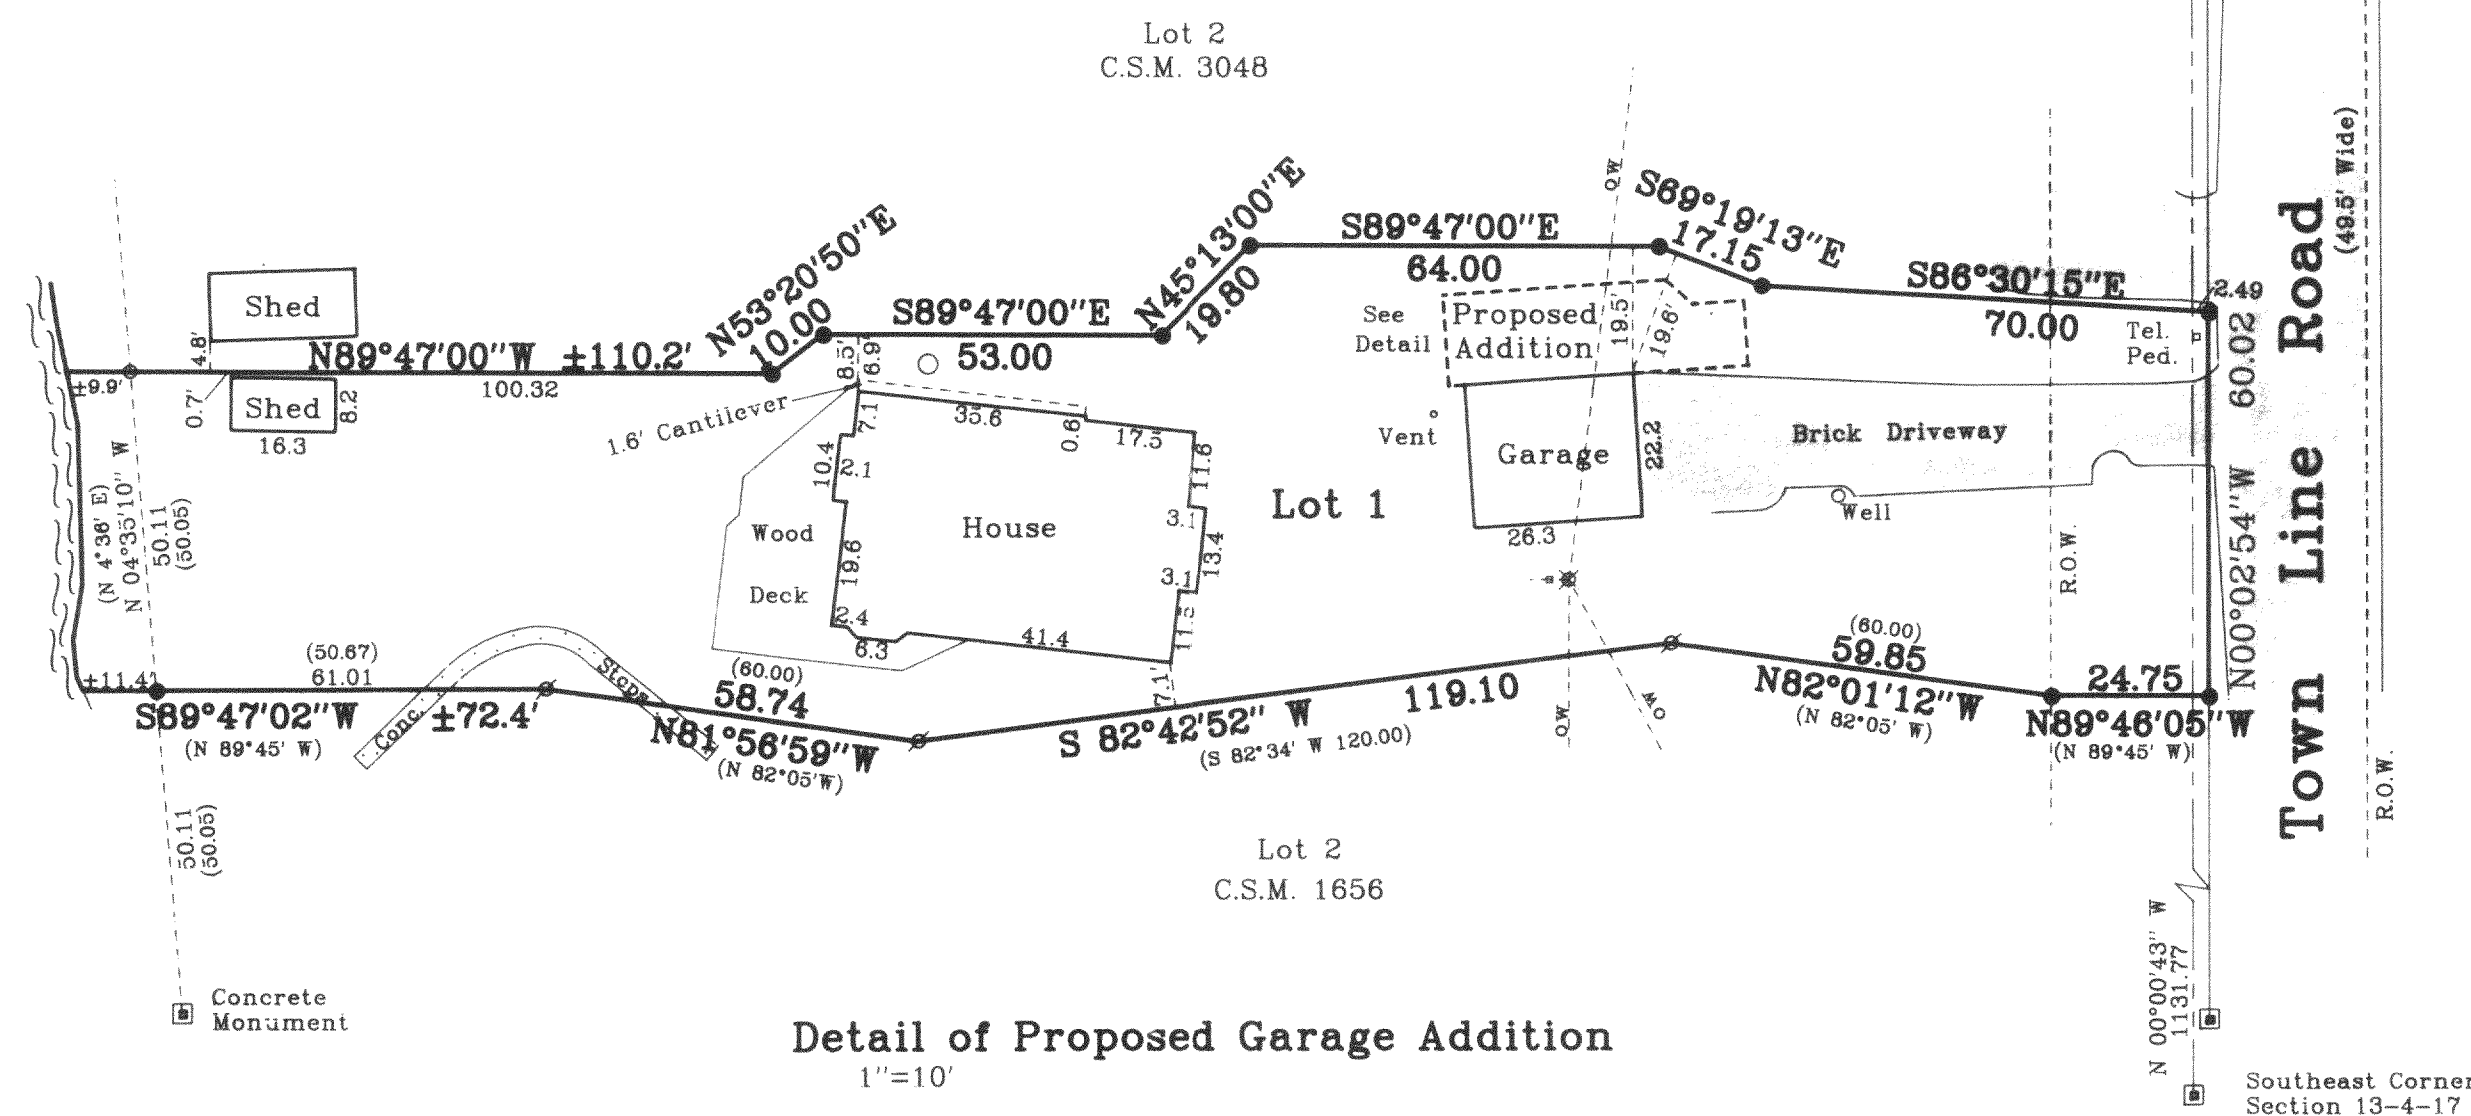

Detail of Proposed Garage Addition
1"=10'

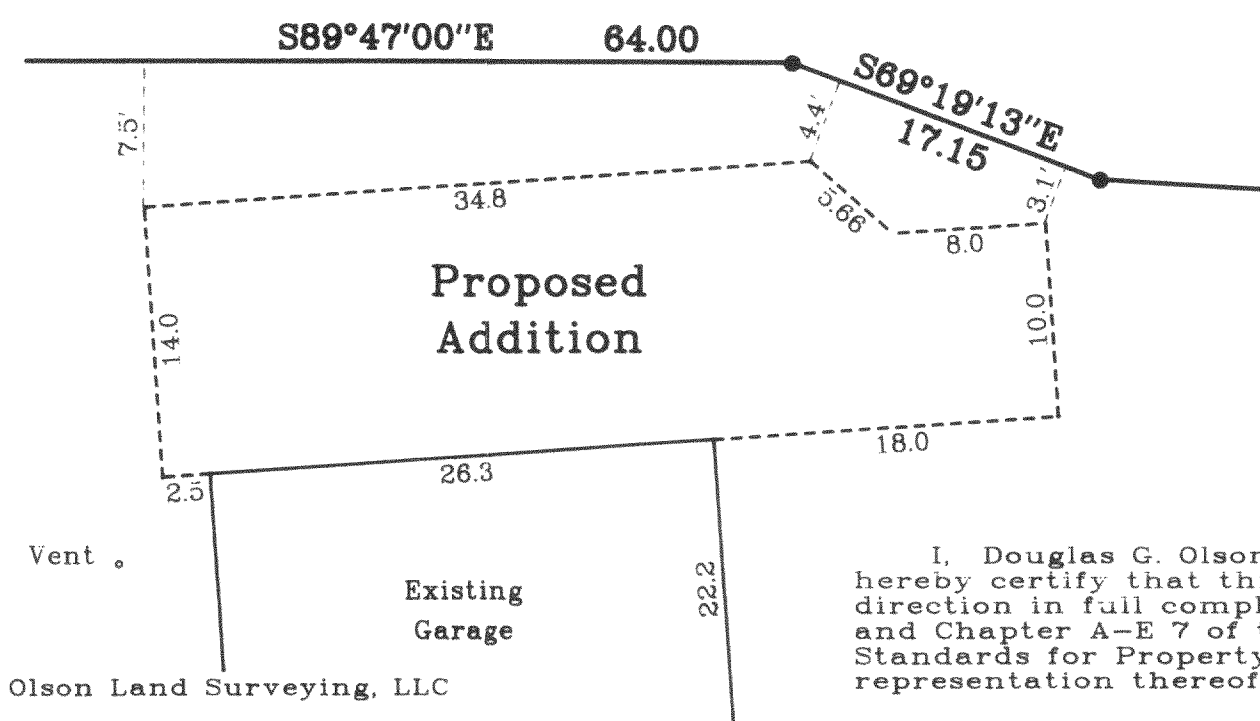

I, Douglas G. Olson, Wisconsin Registered Land Surveyor, do hereby certify that this survey was performed by me, or under my direction in full compliance with the owner's / agent's instructions and Chapter A-E 7 of the Wisconsin Administrative Code "Minimum Standards for Property Surveys"; and that this map is as accurate representation thereof to the best of my knowledge and belief.

Date: 5-5-99



Douglas G. Olson R.L.S. 2093

Note: This survey plat is not certified unless signed and sealed in red ink.

Note: This survey is subject to Wisconsin lien laws. This Plat of Survey is the notice of intent to file lien. Lien waiver required.

Copyright © 1999 by Jensen & Olson Land Surveying, LLC

All rights reserved. No part of this survey plat may be reproduced or transmitted in any form by any means - graphic, electronic, or mechanical, including photocopying, tracing, or information storage and retrieval systems - without permission in writing from Douglas G. Olson, Jensen & Olson Land Surveying, LLC.

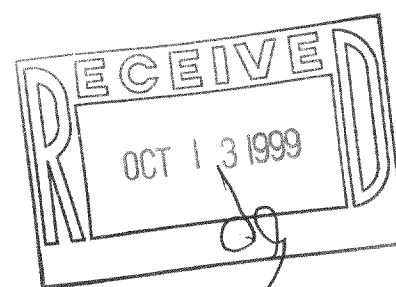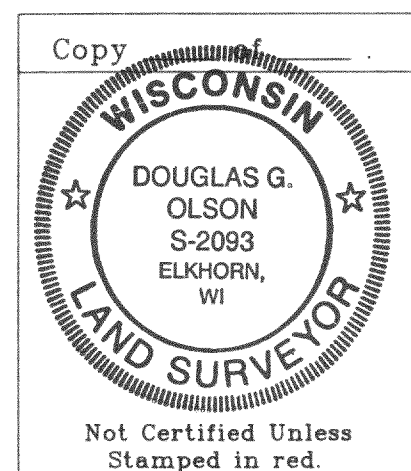

Mapping date: May 5, 1999.

Revisions:

Scale in Feet
1"= 30'



Jensen & Olson Land Surveying, LLC

45 South Wisconsin Street P.O. Box 322

Elkhorn, Wisconsin. 53121

Telephone: (414) 723-3434

Facsimile: (414) 723-8044

Legend

- Found County Section Corner
- Found Iron Pipe
- Found Iron Rod
- Set Iron Rod 3/4" dia.
- Found Information
- Utility Pole
- Concrete Surface
- Asphalt Surface

Sheet 1 of 1 Sheets.

Job Reference Number
1999.050

1999.050

LA-3048-1
417-571