

ABERNATHY and ASSOCIATES

Kenneth B. Abernathy Jr.

Wisconsin Registered Land Surveyor S-1594

Rt. 3, Box 273
Elkhorn, Wisconsin 53121
Phone: (414) 723-4260 (office)
(414) 723 7209 (FAX)

PLAT OF SURVEY

LOT 3 OF CERTIFIED SURVEY MAP NO. 1936, AS RECORDED IN VOL. 9 OF CERTIFIED SURVEY MAPS AS PAGES 155 - 157 AS DOC. NO. 193690, LOCATED IN THE SE 1/4 OF THE NE 1/4 AND THE NE 1/4 OF THE SE 1/4 OF SECTION 26, TOWN 4 NORTH, RANGE 17 EAST, TOWN OF TROY, WALOWRTH COUNTY, WISCONSIN.

LOT 2

C.S.M. # 1936

LOT 3

40,016 SQ. FT.

FD. 2" STAINLESS PIPE
4.7 TALL 0.21" S. AND
0.04" E. OF CORNER.

SCALE 1" = 20 FEET

ORDERED BY: SCHAUDER BUILDING, INC.
4115 HIGHWAY 51 NORTH
JANESVILLE, WISCONSIN
53545-9674

CLIENT REFERENCE: CZARNECKI


GRAVEL DRIVEWAY

EXISTING
FOUNDATION


8-30-99

Legend

- FOUND IRON PIPE
- FOUND IRON ROD
- FOUND BRASS CAPPED MONUMENT
- FOUND CONCRETE MONUMENT
- CHISEL CUT IN CONCRETE
- SET IRON ROD, 24" LONG, WEIGHING 1.5 LBS./LINEAL FT., 3/4" DIA.
- SET IRON ROD, 30" LONG, WEIGHING 4.5 LBS./LINEAL FT., 1-11/16" DIA.
- (XX) RECORDED AS DIMENSION
- EXISTING FENCE

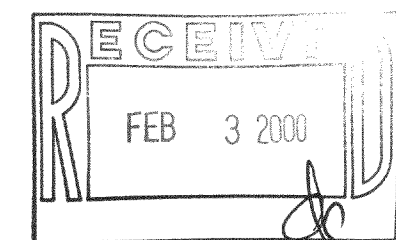

SCALE: 1" = 20 FEET

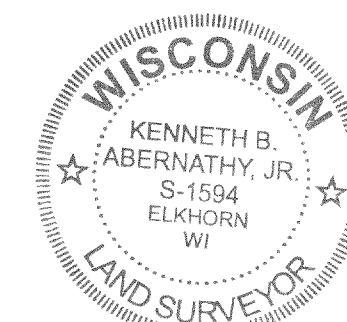

REVISED 8-31-99

"I hereby certify that the above described property has been surveyed by me or under my direction and that the above map is a true representation thereof and shows the size and location of the property, its exterior boundaries, the location of all visible structures and dimensions of all principal buildings thereon, boundary fences, apparent easements, roadways and visible encroachments, if any."
"This survey is made for the use of the present owners of the property, and also those who purchase, mortgage, or guarantee the title thereto within one year from date hereof."

KENNETH B. ABERNATHY, JR.
WISCONSIN REGISTERED LAND SURVEYOR,
S-1594

Date: 7-19-99 Job No. 99.701

417-584

LA-1936-3