
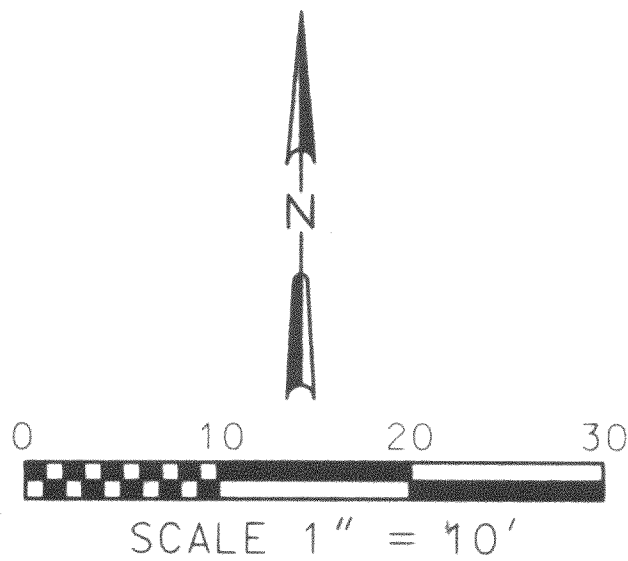
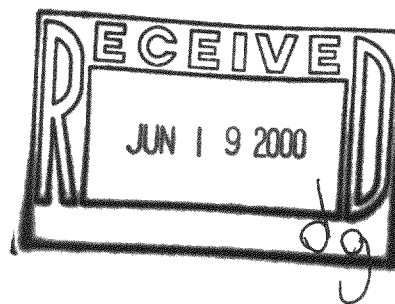


PLAT OF SURVEY

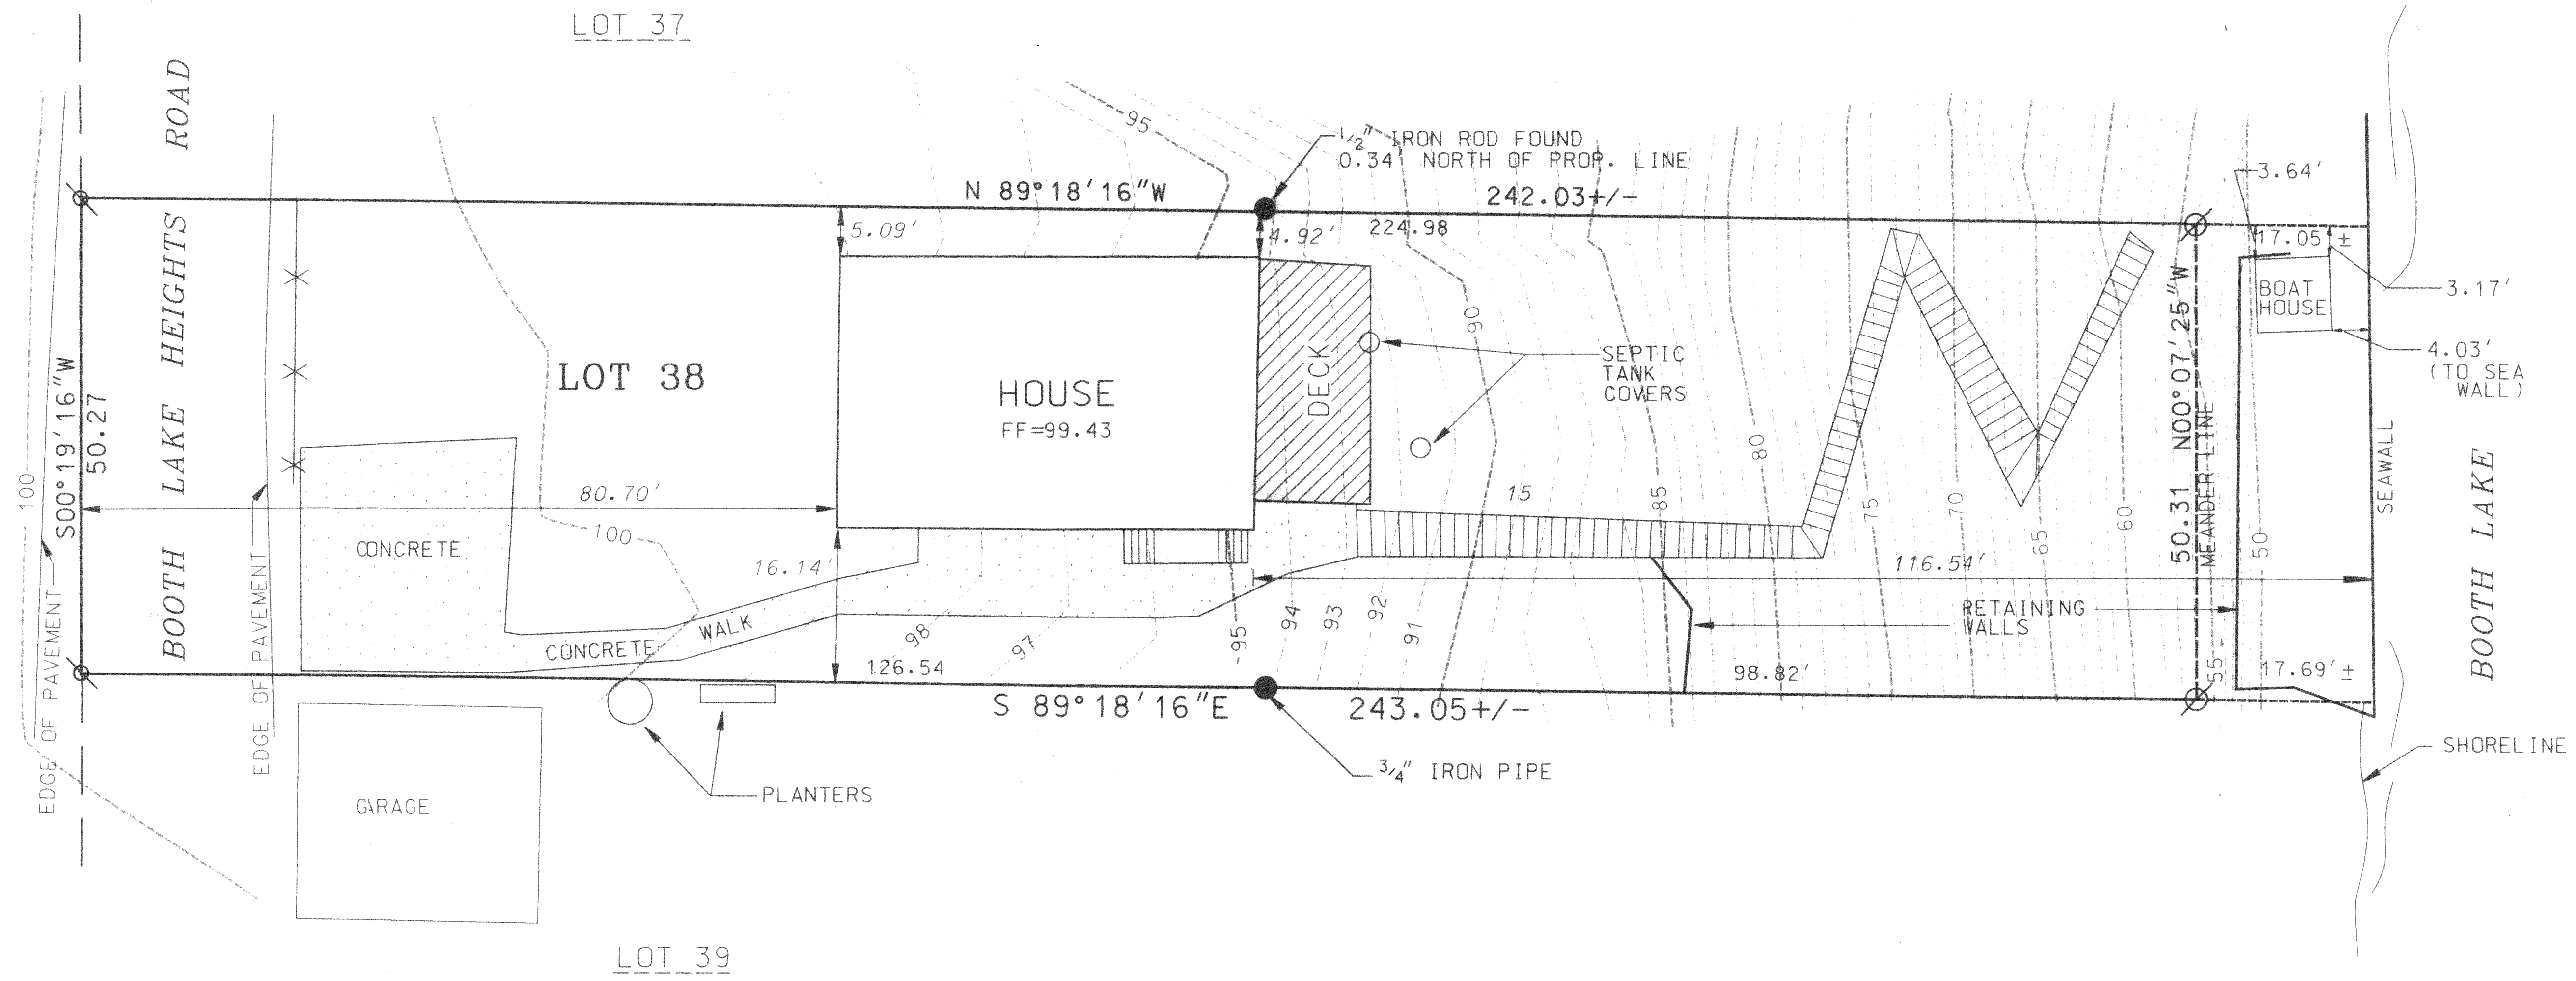

RSV ENGINEERING, INC

801 MAIN STREET, MUKWONAGO, WISCONSIN 53149 (262) 363-2004

INITIALS	DATE
DESIGN	
DRAWN JAS	6/6/00
CHECKED ES	
APPROVED	
REVISIONS	

LBL-32

417-596