



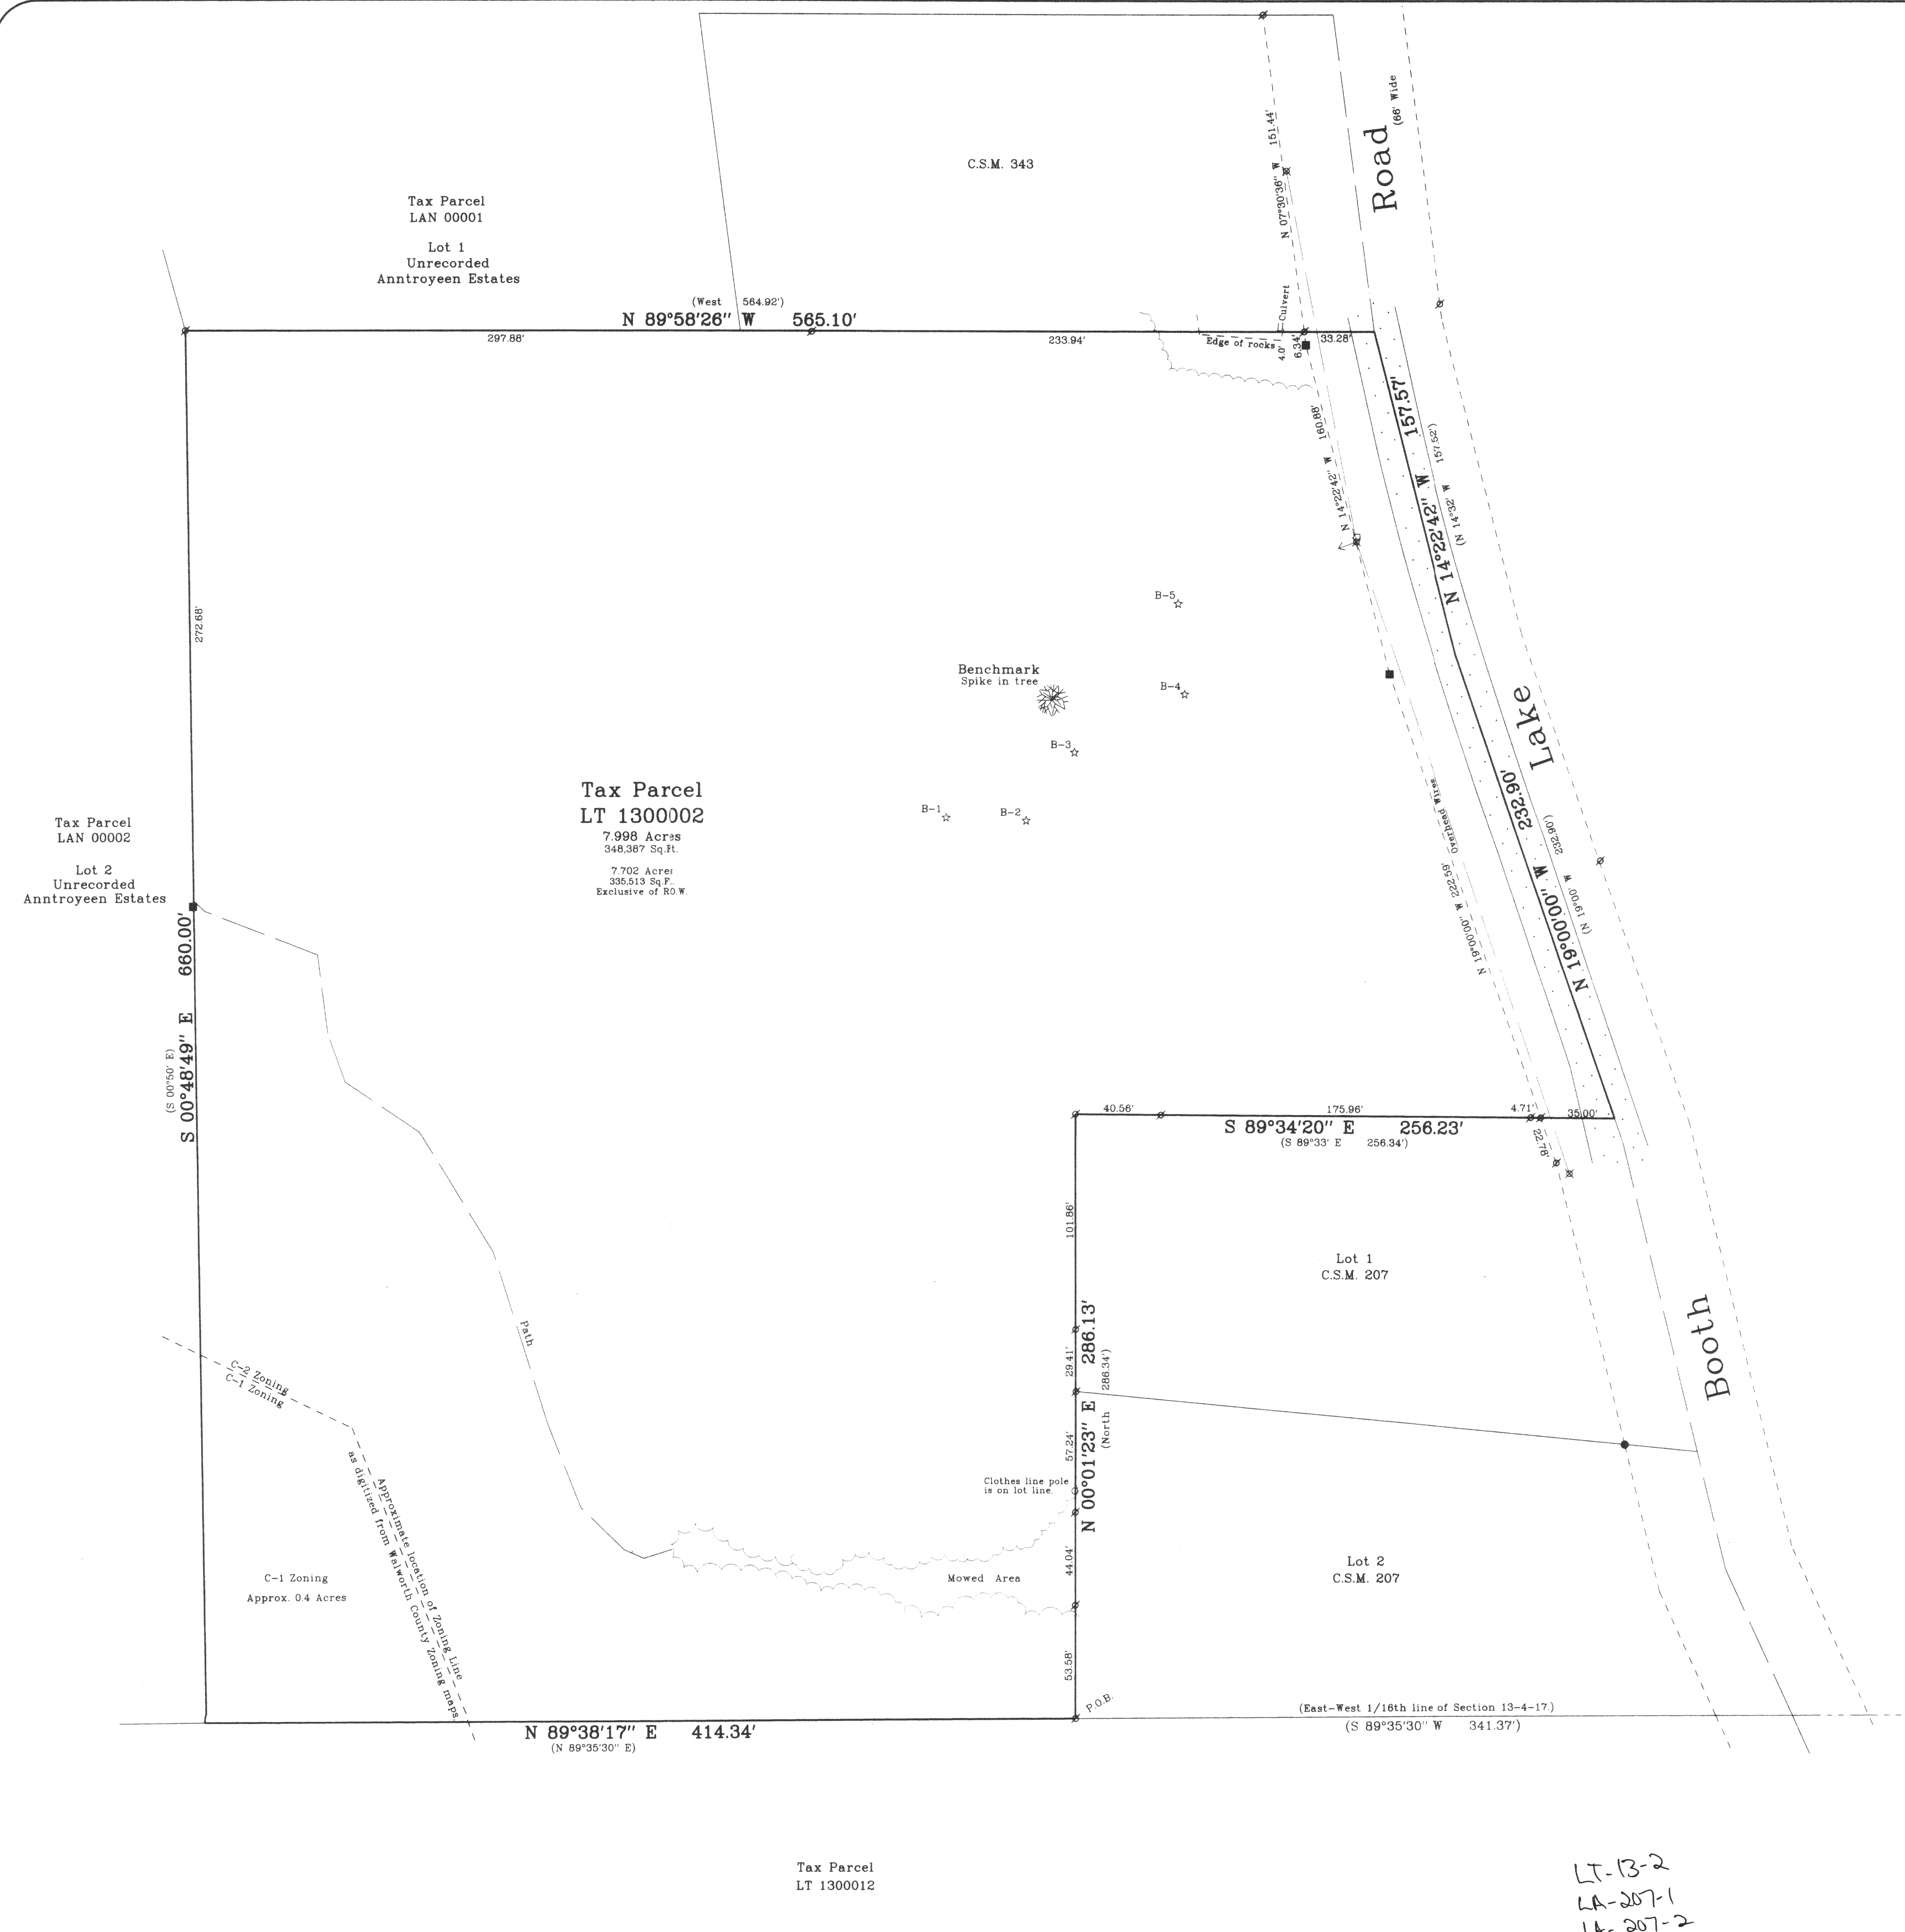


Plat of Survey


of

A parcel of land described as Parcel 2 in a Personal Representative's Deed recorded in Vol. 669 on Page 7159 as Document No. 437988 as follows: All that part of the Northeast 1/4 of Section 13, T 4 N, R 17 E, Walworth County, Wisconsin, described as follows: Commencing in the centerline of Booth Lake Road on the East-West 1/16th line of said Northeast 1/4 and run thence S 89°35'30" W, 341.37 feet to the point of beginning; thence run North 286.34 feet; thence S 89°33' E, 256.34 feet to the centerline of Booth Lake Road; thence N 19°00' W along said centerline 232.90 feet; thence N 14°32' W along said centerline 157.52 feet; thence West 564.92 feet; thence S 0°52' E, 660.00 feet; thence N 89°35'30" E, 414.34 feet to the point of beginning, containing 6.0 acres, in the Town of Troy, Walworth County. Subject to existing public highways.

Surveyed for: **Coldwell Banker, Leith & Associates**
102 North Wisconsin Street
Elkhorn, Wisconsin. 53121

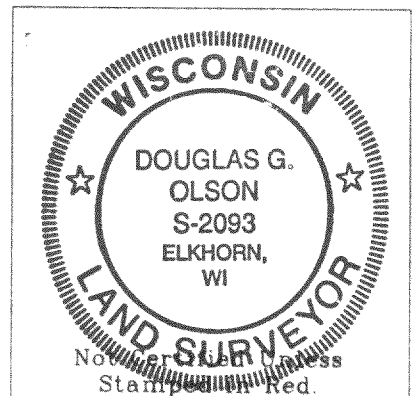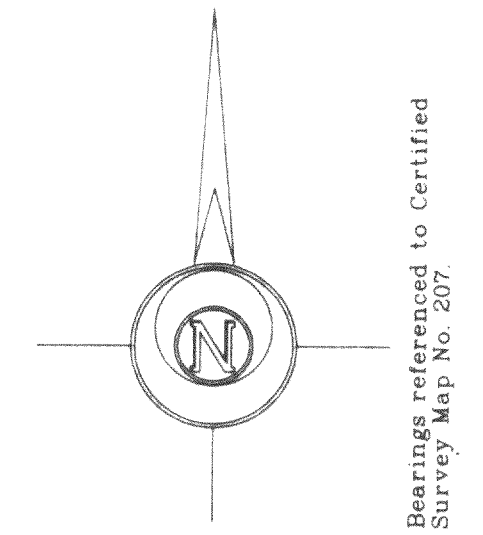

- Notes: 1) This survey plat is not certified unless signed and sealed in red ink.
- 2) This survey is subject to Wisconsin lien laws. This Plat of Survey is the notice of intent to file lien. Lien waiver required.

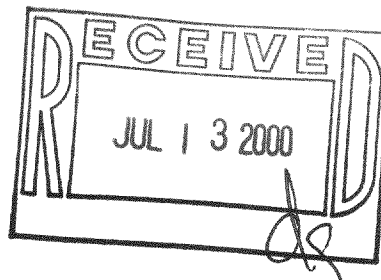

Copyright © 200 by Jensen & Olson Land Surveying, LLC.

All rights reserved. No part of this survey plat may be reproduced or transmitted in any form by any means - graphic, electronic, or mechanical, including photocopying, tracing, or information storage and retrieval systems - without permission in writing from Douglas G. Olson, Jensen & Olson Land Surveying, LLC.

I, Douglas G. Olson, Wisconsin Registered Land Surveyor, do hereby certify that this survey was performed by me or under my direction in full compliance with the owner's/agent's instructions and Chapter A-E7 of the Wisconsin Administrative Code "Minimum Standards for Property Surveying" and that this map is an accurate representation hereof to the best of my knowledge and belief.

Douglas G. Olson
Wisconsin Registered Land Surveyor - 2093

Survey date: June 3, 2000. Revisions:	
Scale in Feet 1" = 40' 0' 20' 40' 80' 120'	
Jensen & Olson Land Surveying, LLC 45 South Wisconsin Street P.O. Box 322 Elkhorn, Wisconsin. 53121 Telephone: (262) 723-3434 Facsimile: (262) 723-8044	
Sheet 1 of 1 Sheets.	Job Reference Number 2000.059
2000.059	