

Plat of Survey

of


Lot 4 of Certified Survey Map No. 1328,

recorded in Vol. 8 of Certified Survey Maps of Walworth County on Page 142 and located in the Northeast 1/4 of Section 8, Town 4 North, Range 17 East, Town of Troy, Walworth County, Wisconsin.

Surveyed for:


Jeff Jensen

S107 W34862 South Shore Drive
Mukwonago, Wisconsin. 53149

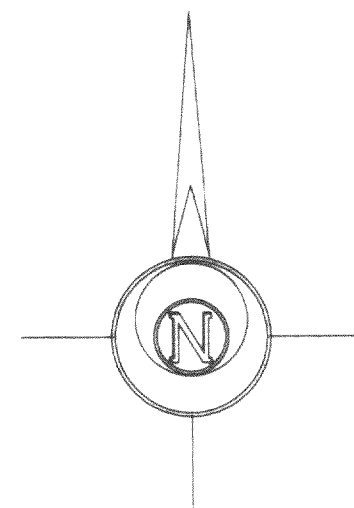

Bearings referenced to Certified
Survey Map No. 1328.

Note: Property boundary is shown based upon found Iron Pipes which appear to be original undisturbed monuments as shown on Certified Survey Map No. 1328. Pipe do not fit well with the South line of the Northeast 1/4 as shown on said C.S.M. No. 1328 or as shown on C.S.M. 2307. See area of Questionable Ownership.

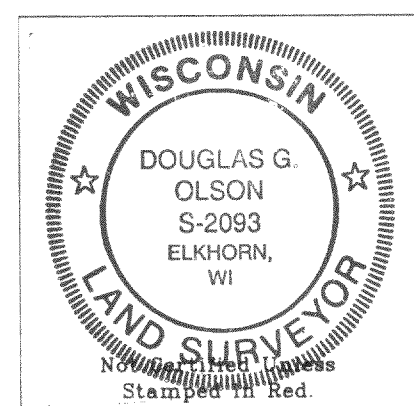

- Notes:** 1) This survey plat is not certified unless signed and sealed in red ink.
2) This survey is subject to Wisconsin lien laws. This Plat of Survey is the notice of intent to file lien. Lien waiver required.


Copyright © 2000 by Jensen & Olson Land Surveying, LLC.

All rights reserved. No part of this survey plat may be reproduced or transmitted in any form by any means - graphic, electronic, or mechanical, including photocopying, tracing, or information storage and retrieval systems - without permission in writing from Douglas G. Olson, Jensen & Olson Land Surveying, LLC.

I, Douglas G. Olson, Wisconsin Registered Land Surveyor, do hereby certify that this survey was performed by me or under my direction in full compliance with the owner's/agent's instructions and Chapter A-E 7 of the Wisconsin Administrative Code "Minimum Standards for Property Surveys", and that this map is an accurate representation thereof to the best of my knowledge and belief.

Douglas G. Olson
Wisconsin Registered Land Surveyor - 2093

LA-1328-4 4/7-599

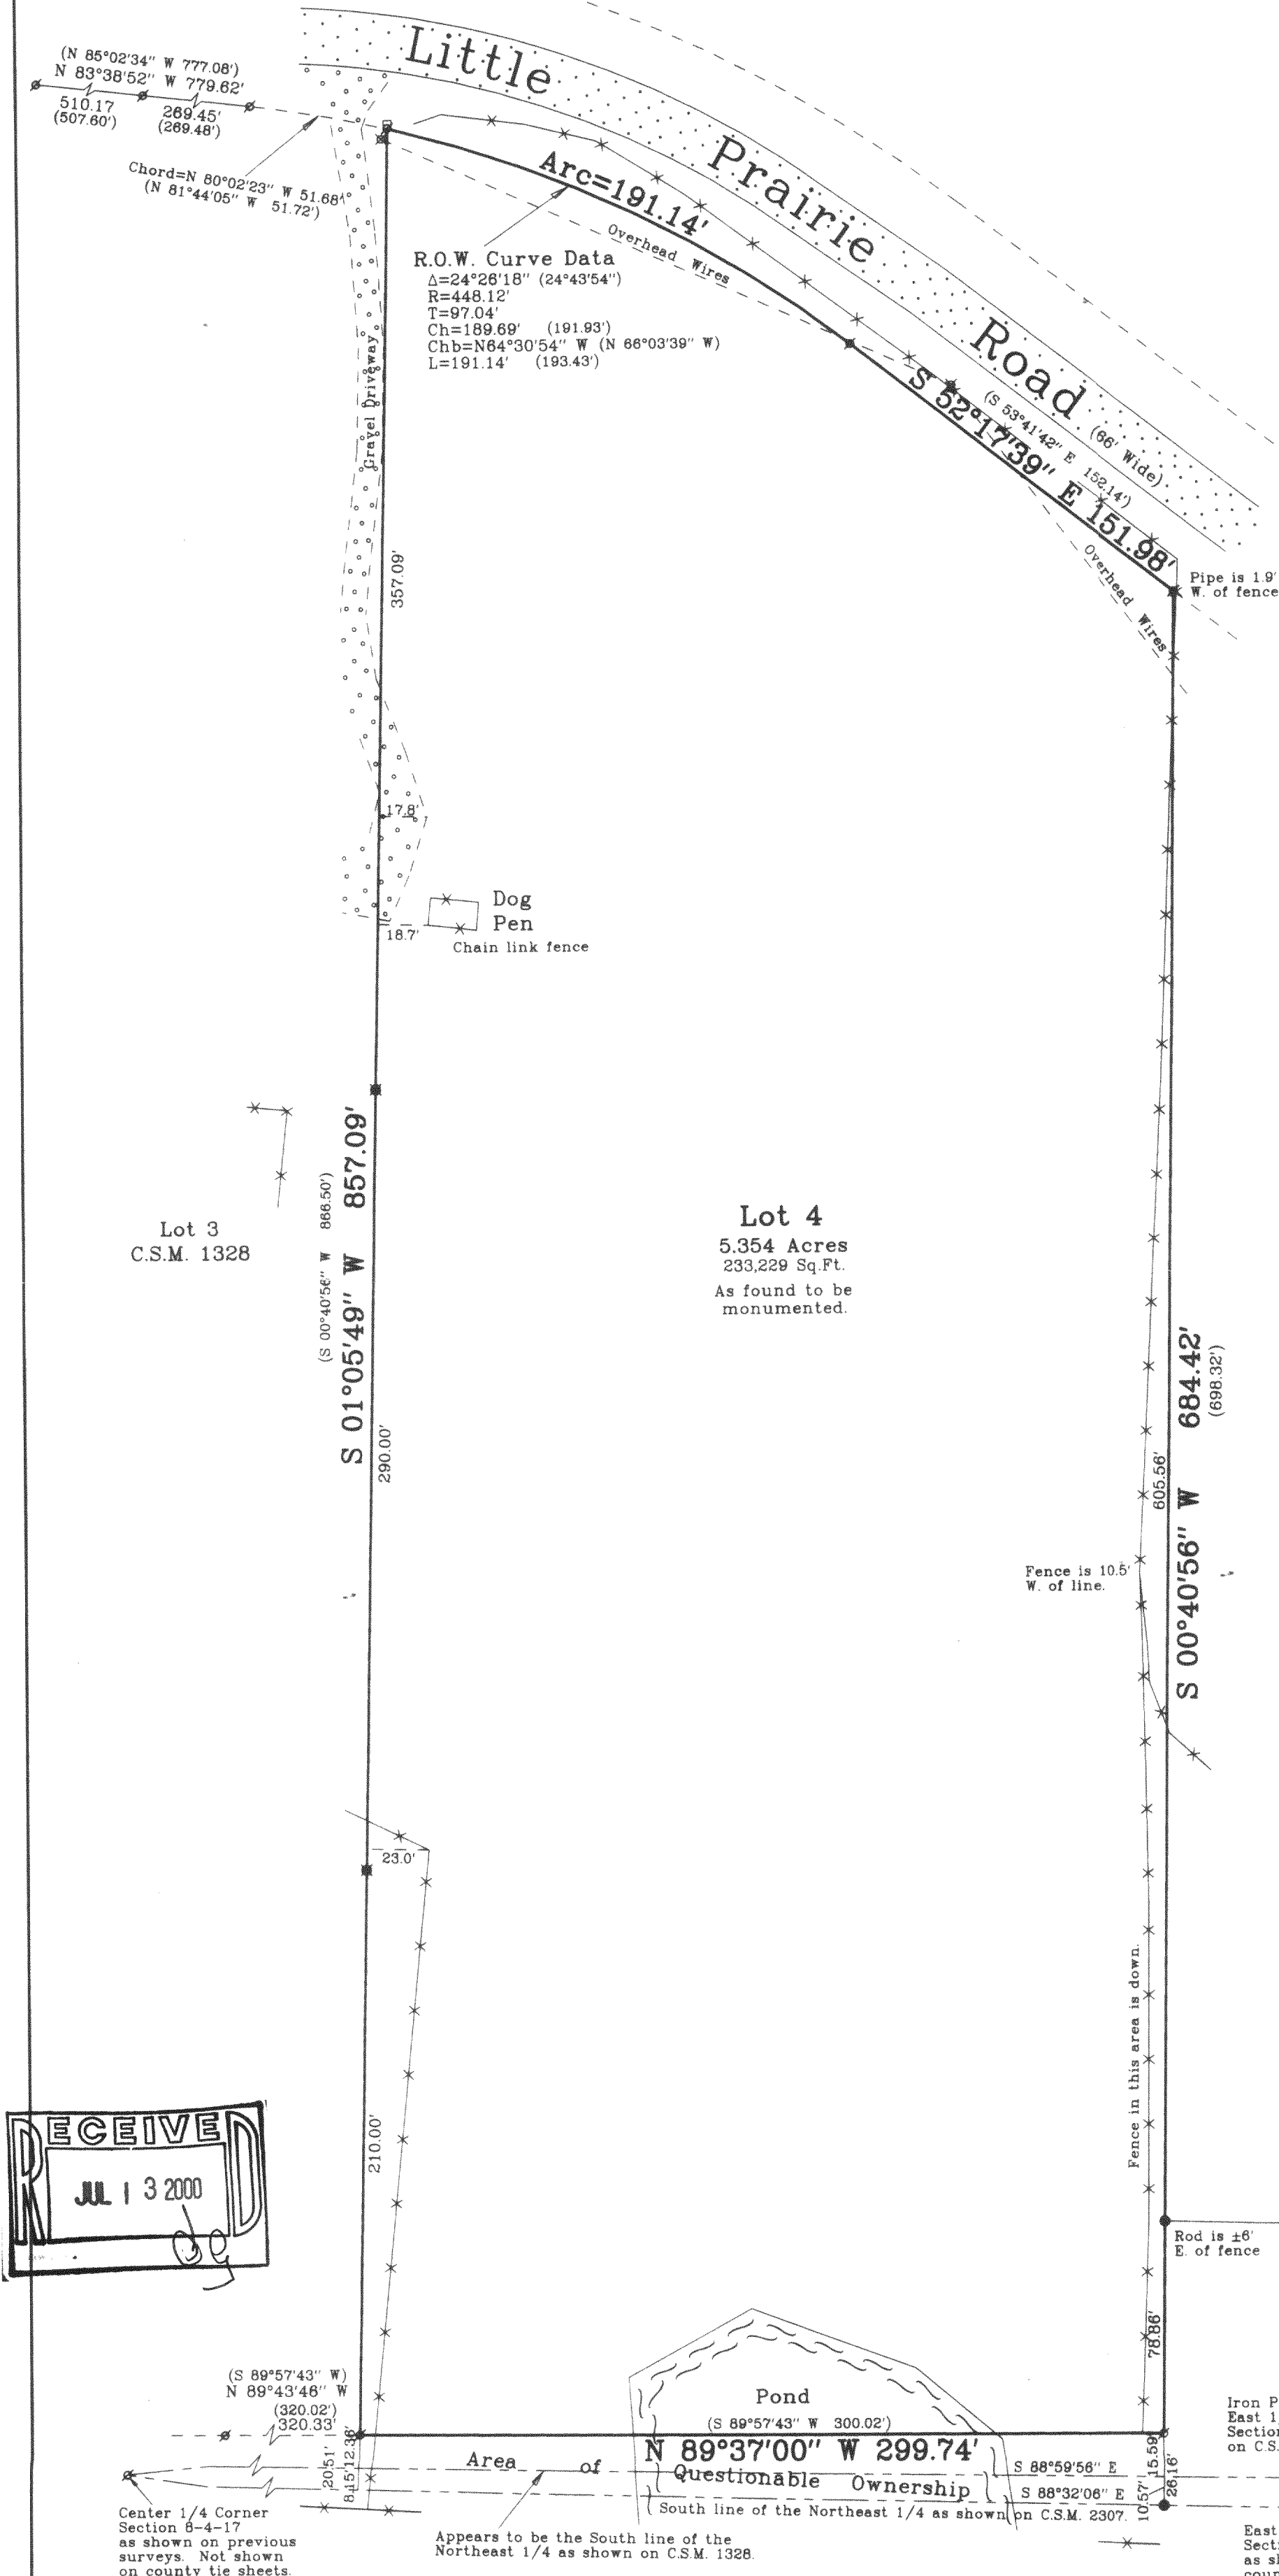

Iron Pipe used as
East 1/4 Corner
Section 8-4-17
on C.S.M. 1328

East 1/4 Corner
Section 8-4-17
as shown on
county tie sheets.

Sheet 1 of 1 Sheets

Job Reference Number

2000.018

Legend

- Walworth County Section Corner
- Found Iron Pipe
- Found Iron Rod
- Set Iron Rod, 3/4" dia.
- () Recorded Information
- Wire Fence
- Asphalt Surface
- Utility Pole
- Gravel Surface
- Utility Pedestal



Jensen & Olson Land Surveying, LLC

45 South Wisconsin Street P.O. Box 322

Elkhorn, Wisconsin. 53121

Telephone (262) 723-3434

Facsimile (262) 723-8044

Scale in Feet

1" = 50'



Survey Date: April 4, 2000.

Revisions: