
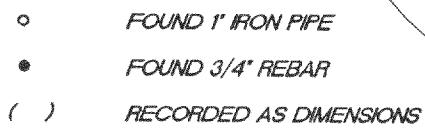


LOT 8, BLOCK 1, KETTLE MORaine ESTATES, located in the NW 1/4 of Section 4, T4N, R17E, Town of Troy, Walworth County, Wisconsin.

Survey address: N9536 Hilltop Dr.

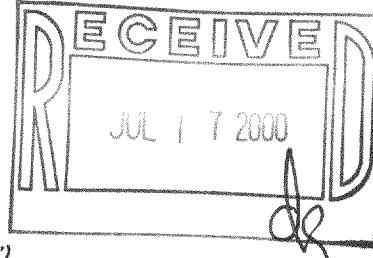

"This survey is made for the use of the present owners of the property, and also those who purchase, mortgage or guarantee the title thereto within one year from date hereof."

DEPARTMENT OF JUSTICE
NATIONAL BUREAU OF INVESTIGATION
RECEIVED
FEB 10 1964
FBI - NEW YORK

THIS IS NOT AN ORIGINAL SURVEY UNLESS THE SEAL IS RED.

00149

JOB NUMBER

417-601