
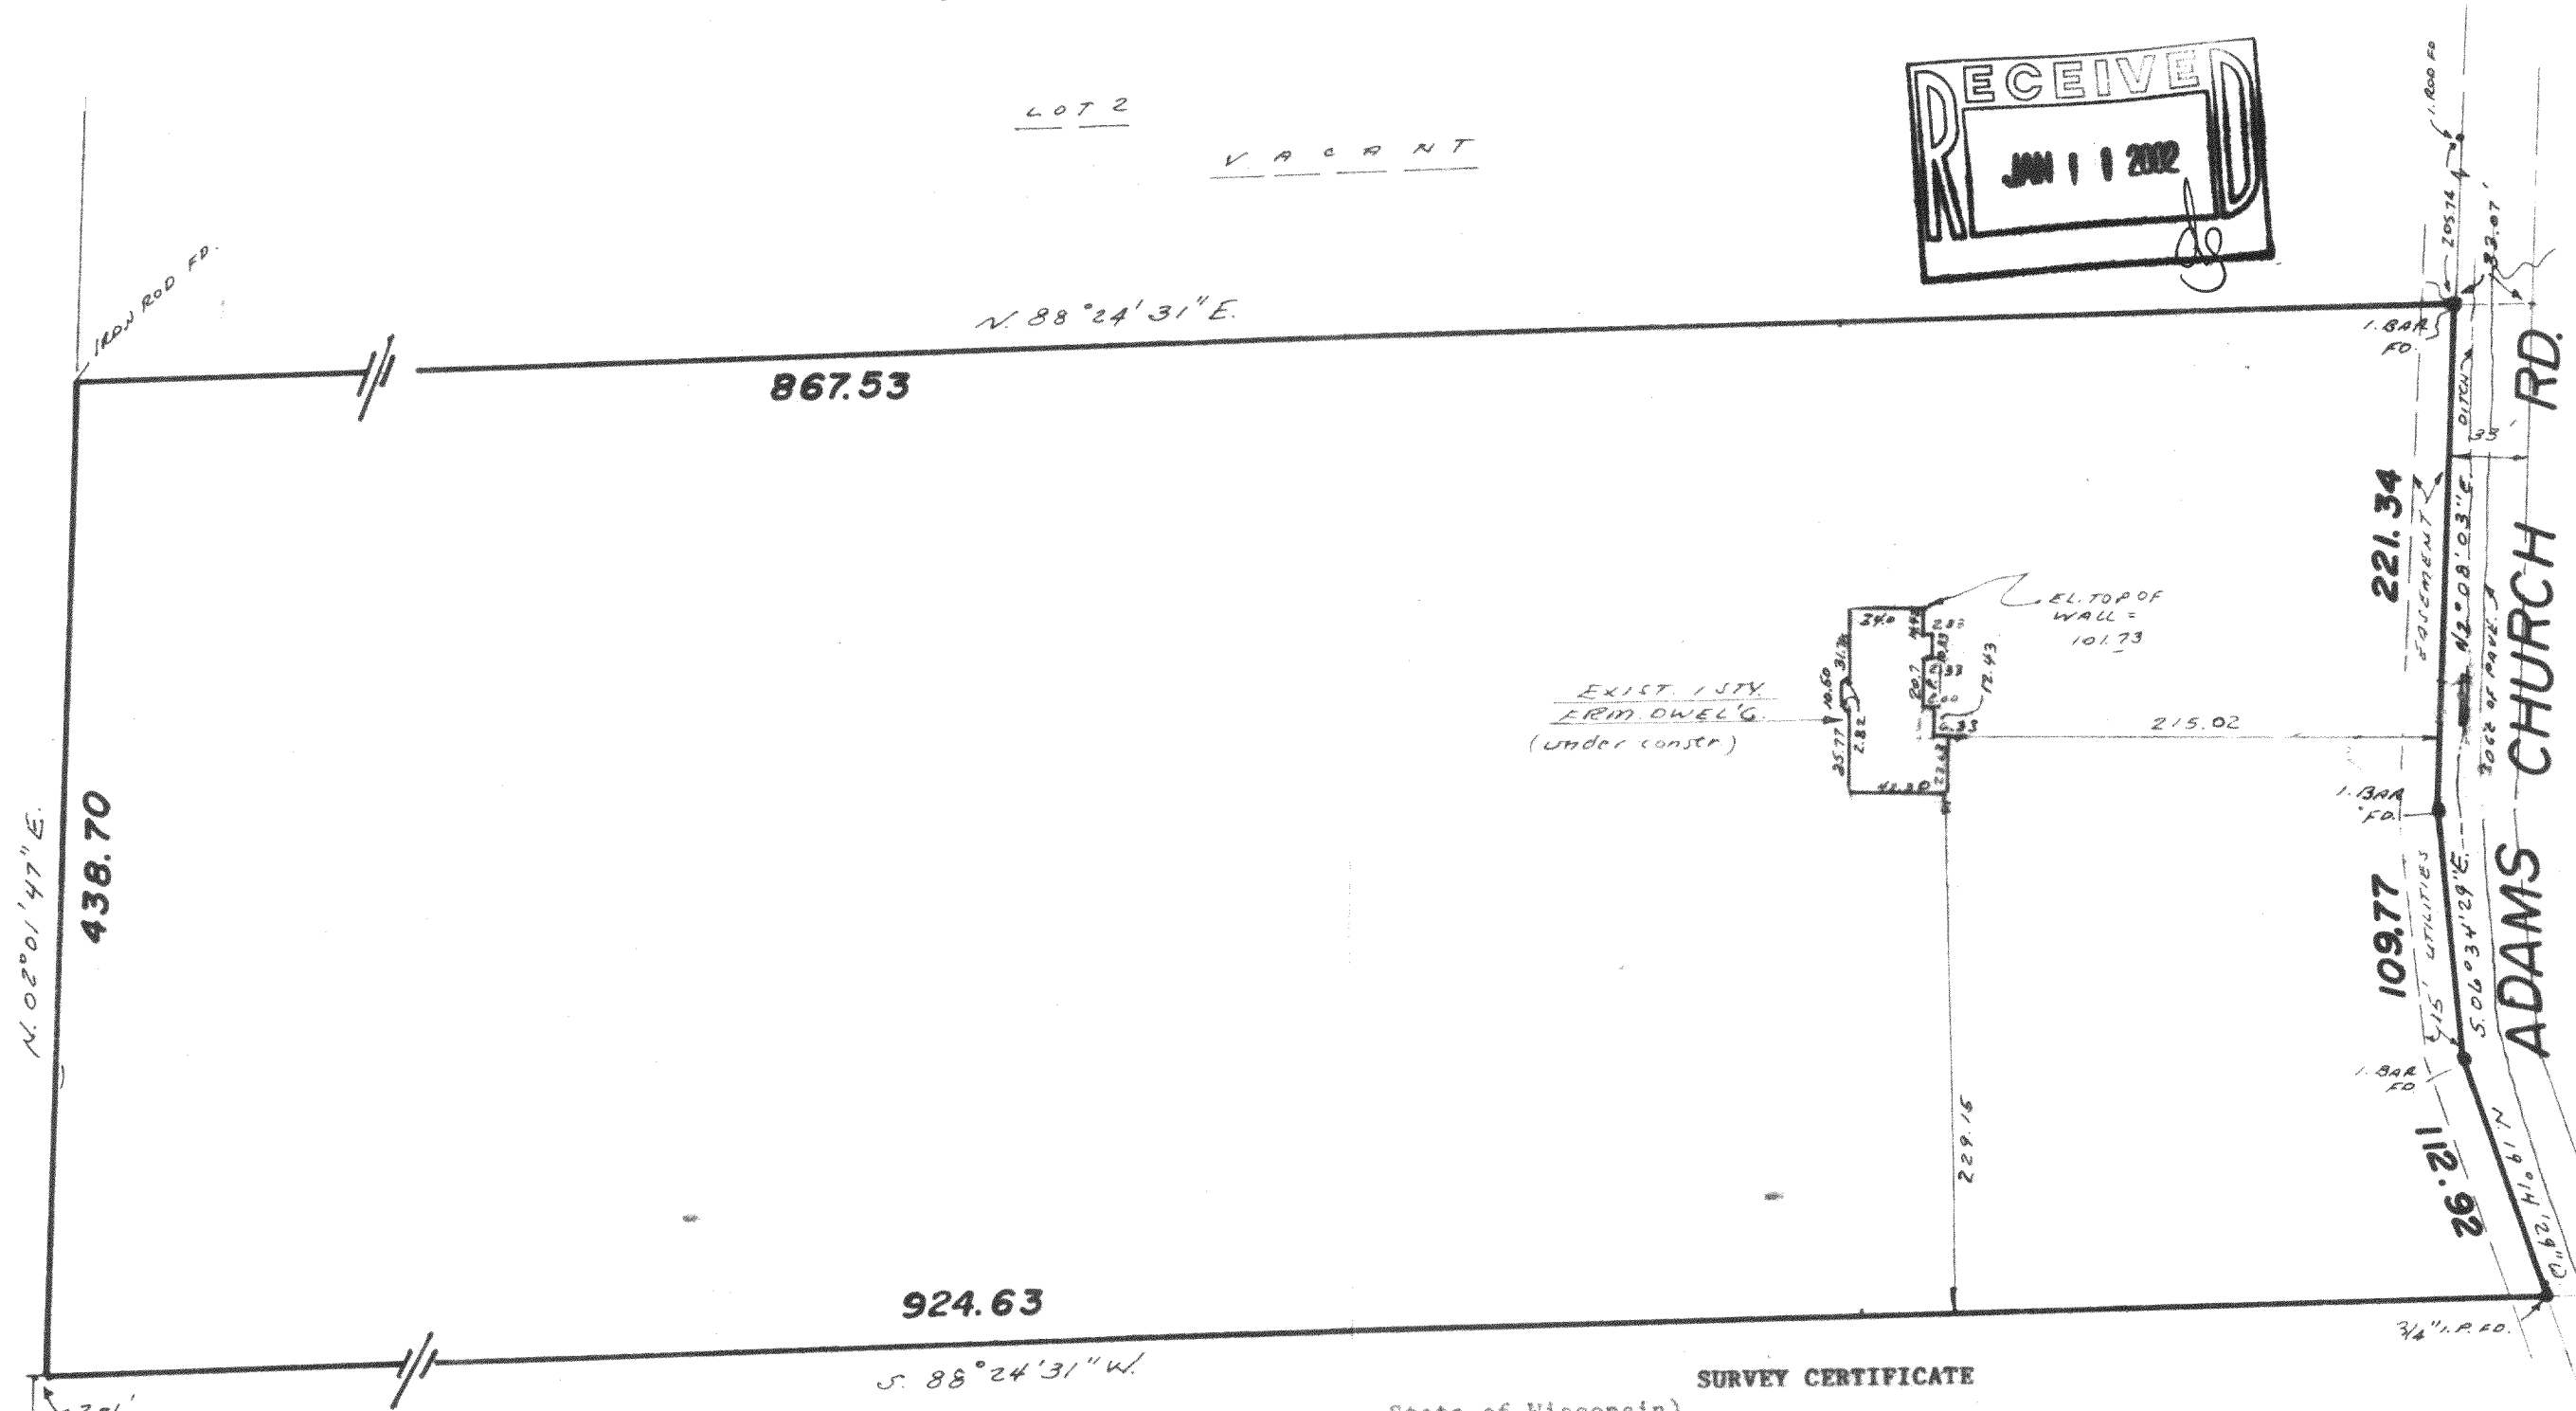


PLAT OF SURVEY

SURVEY FOR: WOLTER BROS. BUILDERS
LOCATION: N9421 ADAMS CHURCH ROAD

KUMITCH/STEPKE

DESCRIPTION: LOT 3 CERTIFIED SURVEY MAP NO. 3077, located in the N.E. 1/4 of the S.W. 1/4 of Section 6,
Town 4 North, Range 17 East, Walworth County, Wisconsin.

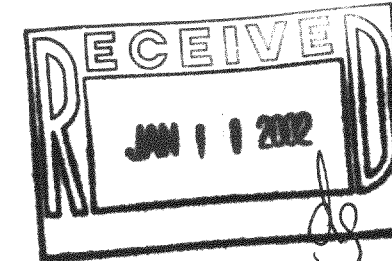


SURVEY CERTIFICATE

State of Wisconsin)
Milwaukee County)ss

We, Interline Survey Services, Inc., certify that we have surveyed the above describe property and the above map is a true representation thereof, and shows the size and location of the property, its exterior boundaries, the location and dimensions of all visible structures thereon, fences, apparent easements and roadways and visible encroachments, if any.

This survey is made for the exclusive use of the present owners of the Property, and also those who purchase, mortgage, or guarantee the title thereto, within one (1) year from date hereof.

Gary J. Smith
Wisconsin Registered Land Surveyor

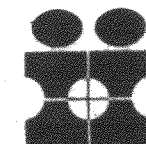

INTERLINE SURVEY
SERVICES, INC.
11221 W. FOREST HOME AVE
HALES CORNERS, WISCONSIN 53130
PHONE 425-2060

DATE: 5/18/00
JOB NO. 27574


417-651
LA-3077-3

PLAT OF SURVEY

SURVEY FOR: WOLTER BROS. BUILDERS
LOCATION: ADAMS CHURCH ROAD

KUMITCH/STEPKE

DESCRIPTION: LOT 3 CERTIFIED SURVEY MAP NO. 3077, located in the N.E. 1/4 of the S.W. 1/4 of Section 6,
 Town 4 North, Range 17 East, Walworth County, Wisconsin.

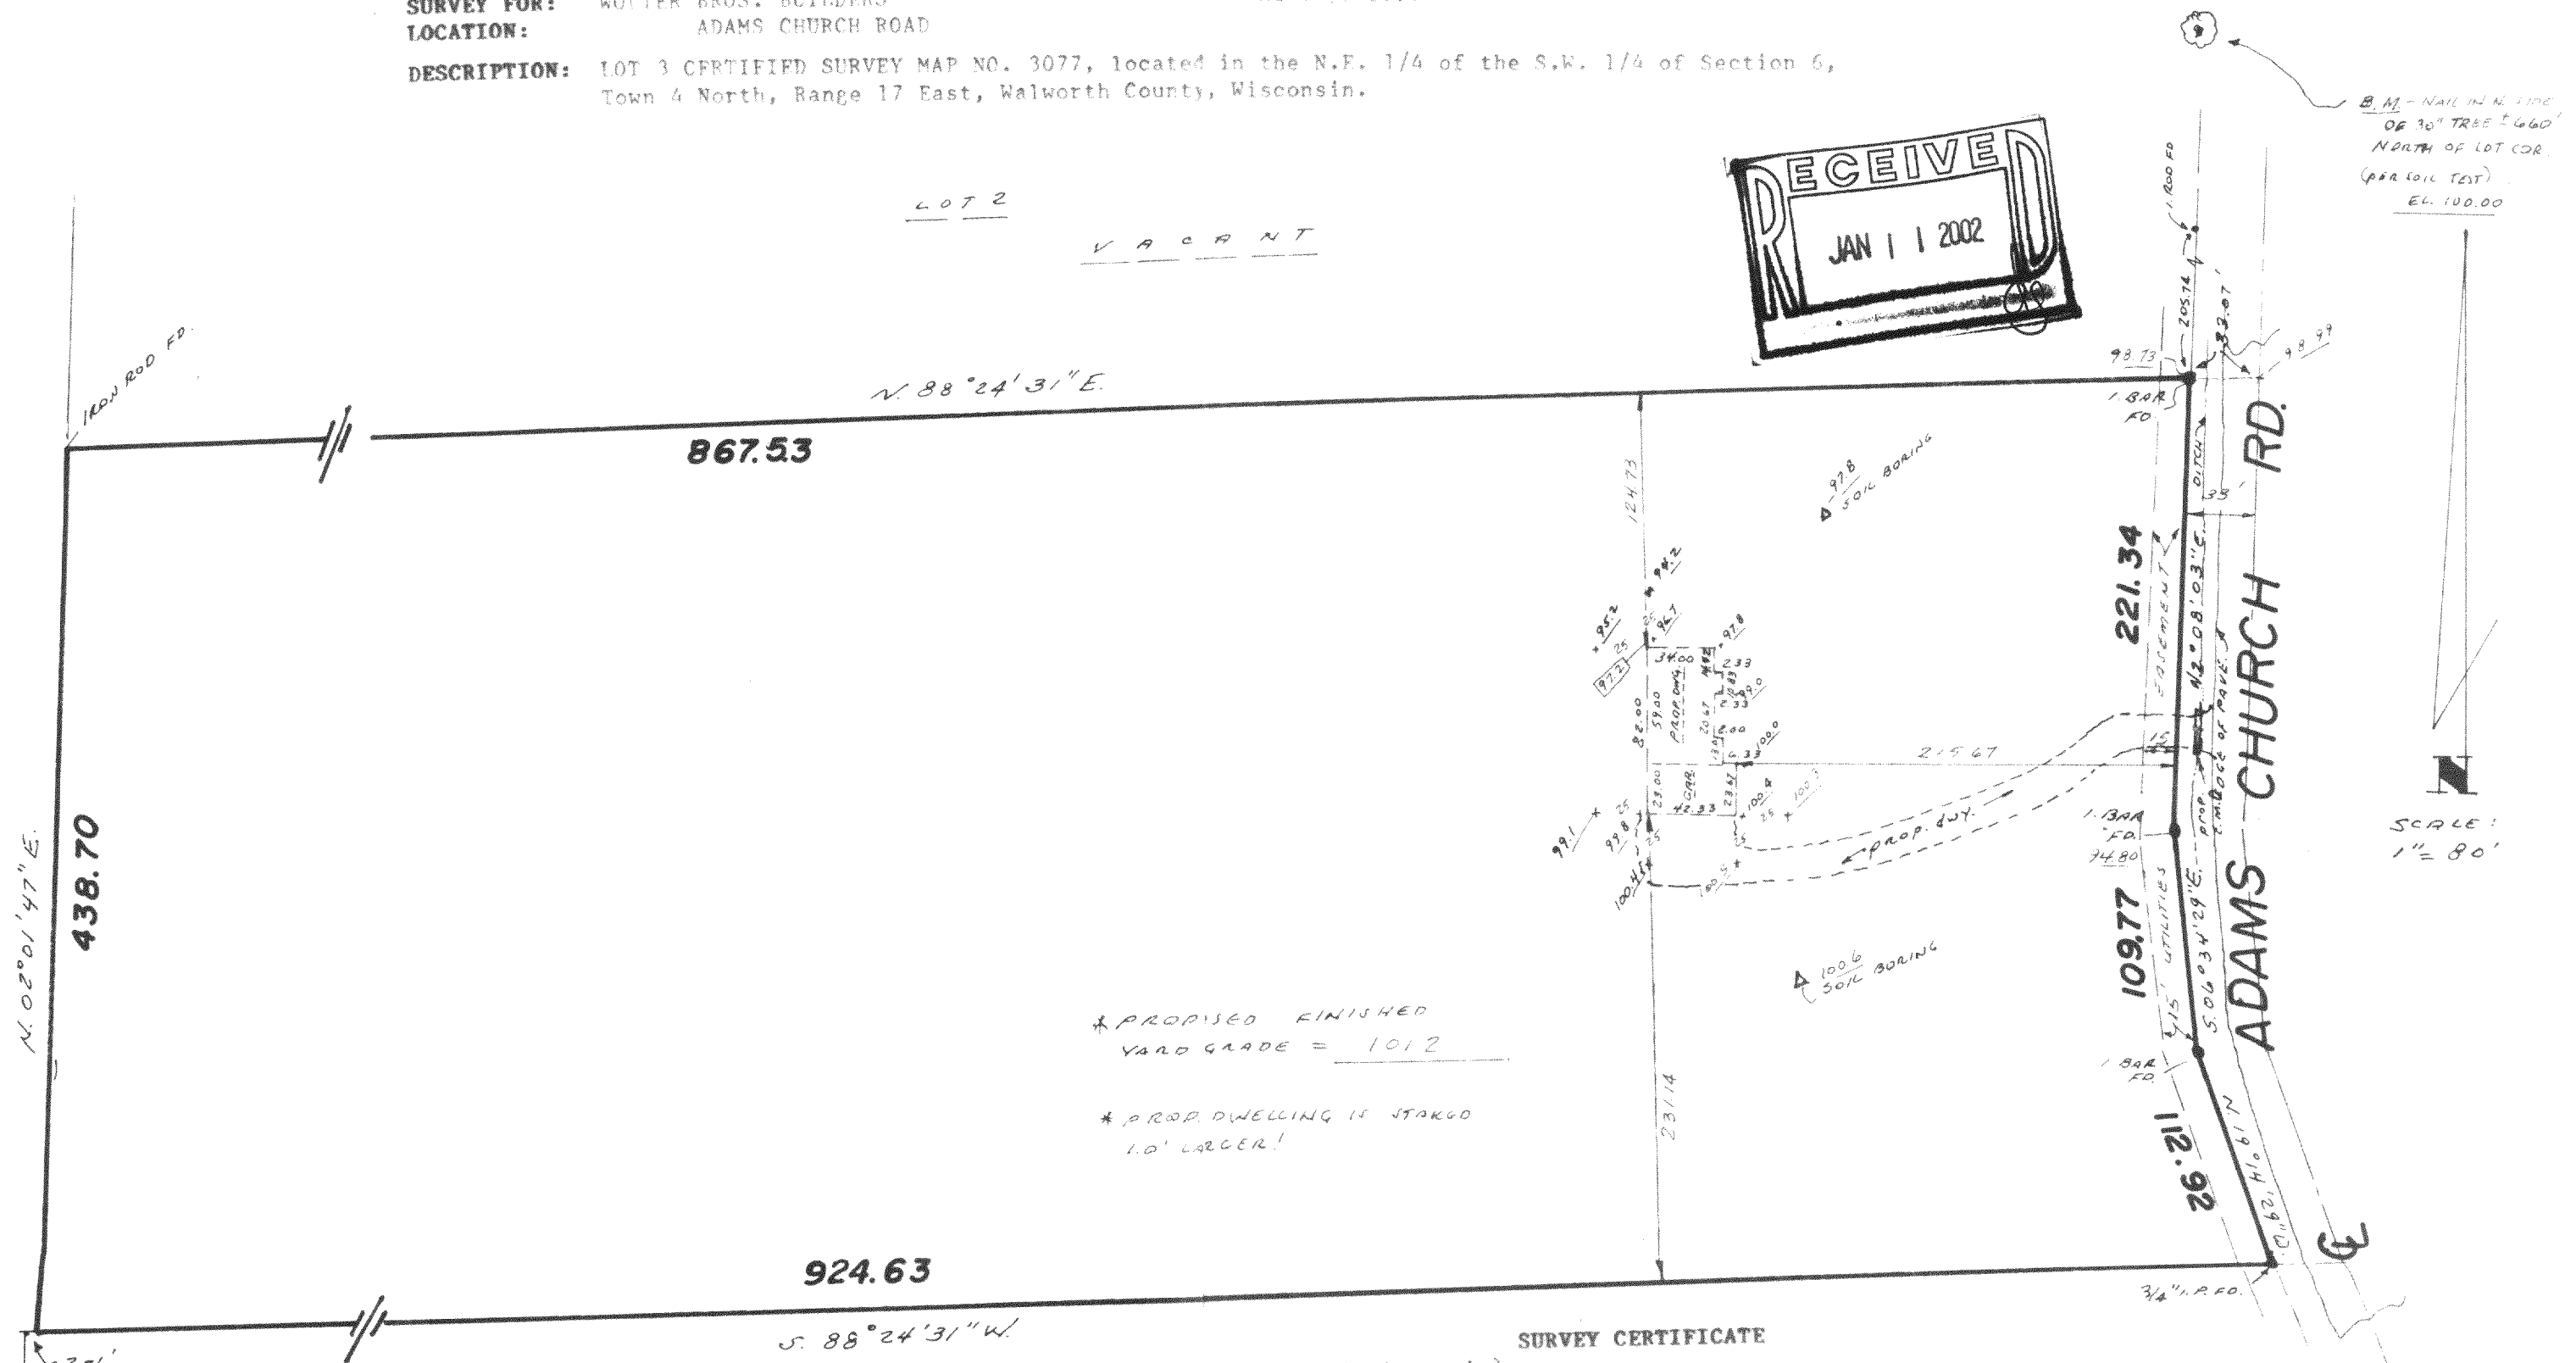

* PROPOSED FINISHED
 YARD GRADE = 1012

* PROP. DWELLING IS STAKED
 1.0' LARGER!



SURVEY CERTIFICATE

State of Wisconsin)
 Milwaukee County)ss


C. S. M. 2757

We, Interline Survey Services, Inc., certify that we have surveyed the above described property and the above map is a true representation thereof, and shows the size and location of the property, its exterior boundaries, the location and dimensions of all visible structures thereon, fences, apparent easements and roadways and visible encroachments, if any.

This survey is made for the exclusive use of the present owners of the Property, and also those who purchase, mortgage, or guarantee the title thereto, within one (1) year from date hereof.

Gary J. Smith

Wisconsin Registered Land Surveyor

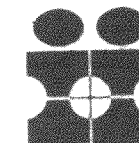

**INTERLINE SURVEY
 SERVICES, INC.**
 11221 W. FOREST HOME AVE.
 HALES CORNERS, WISCONSIN 53130
 PHONE 425-2060

DATE: 3/13/00
 JOB NO. 27472