
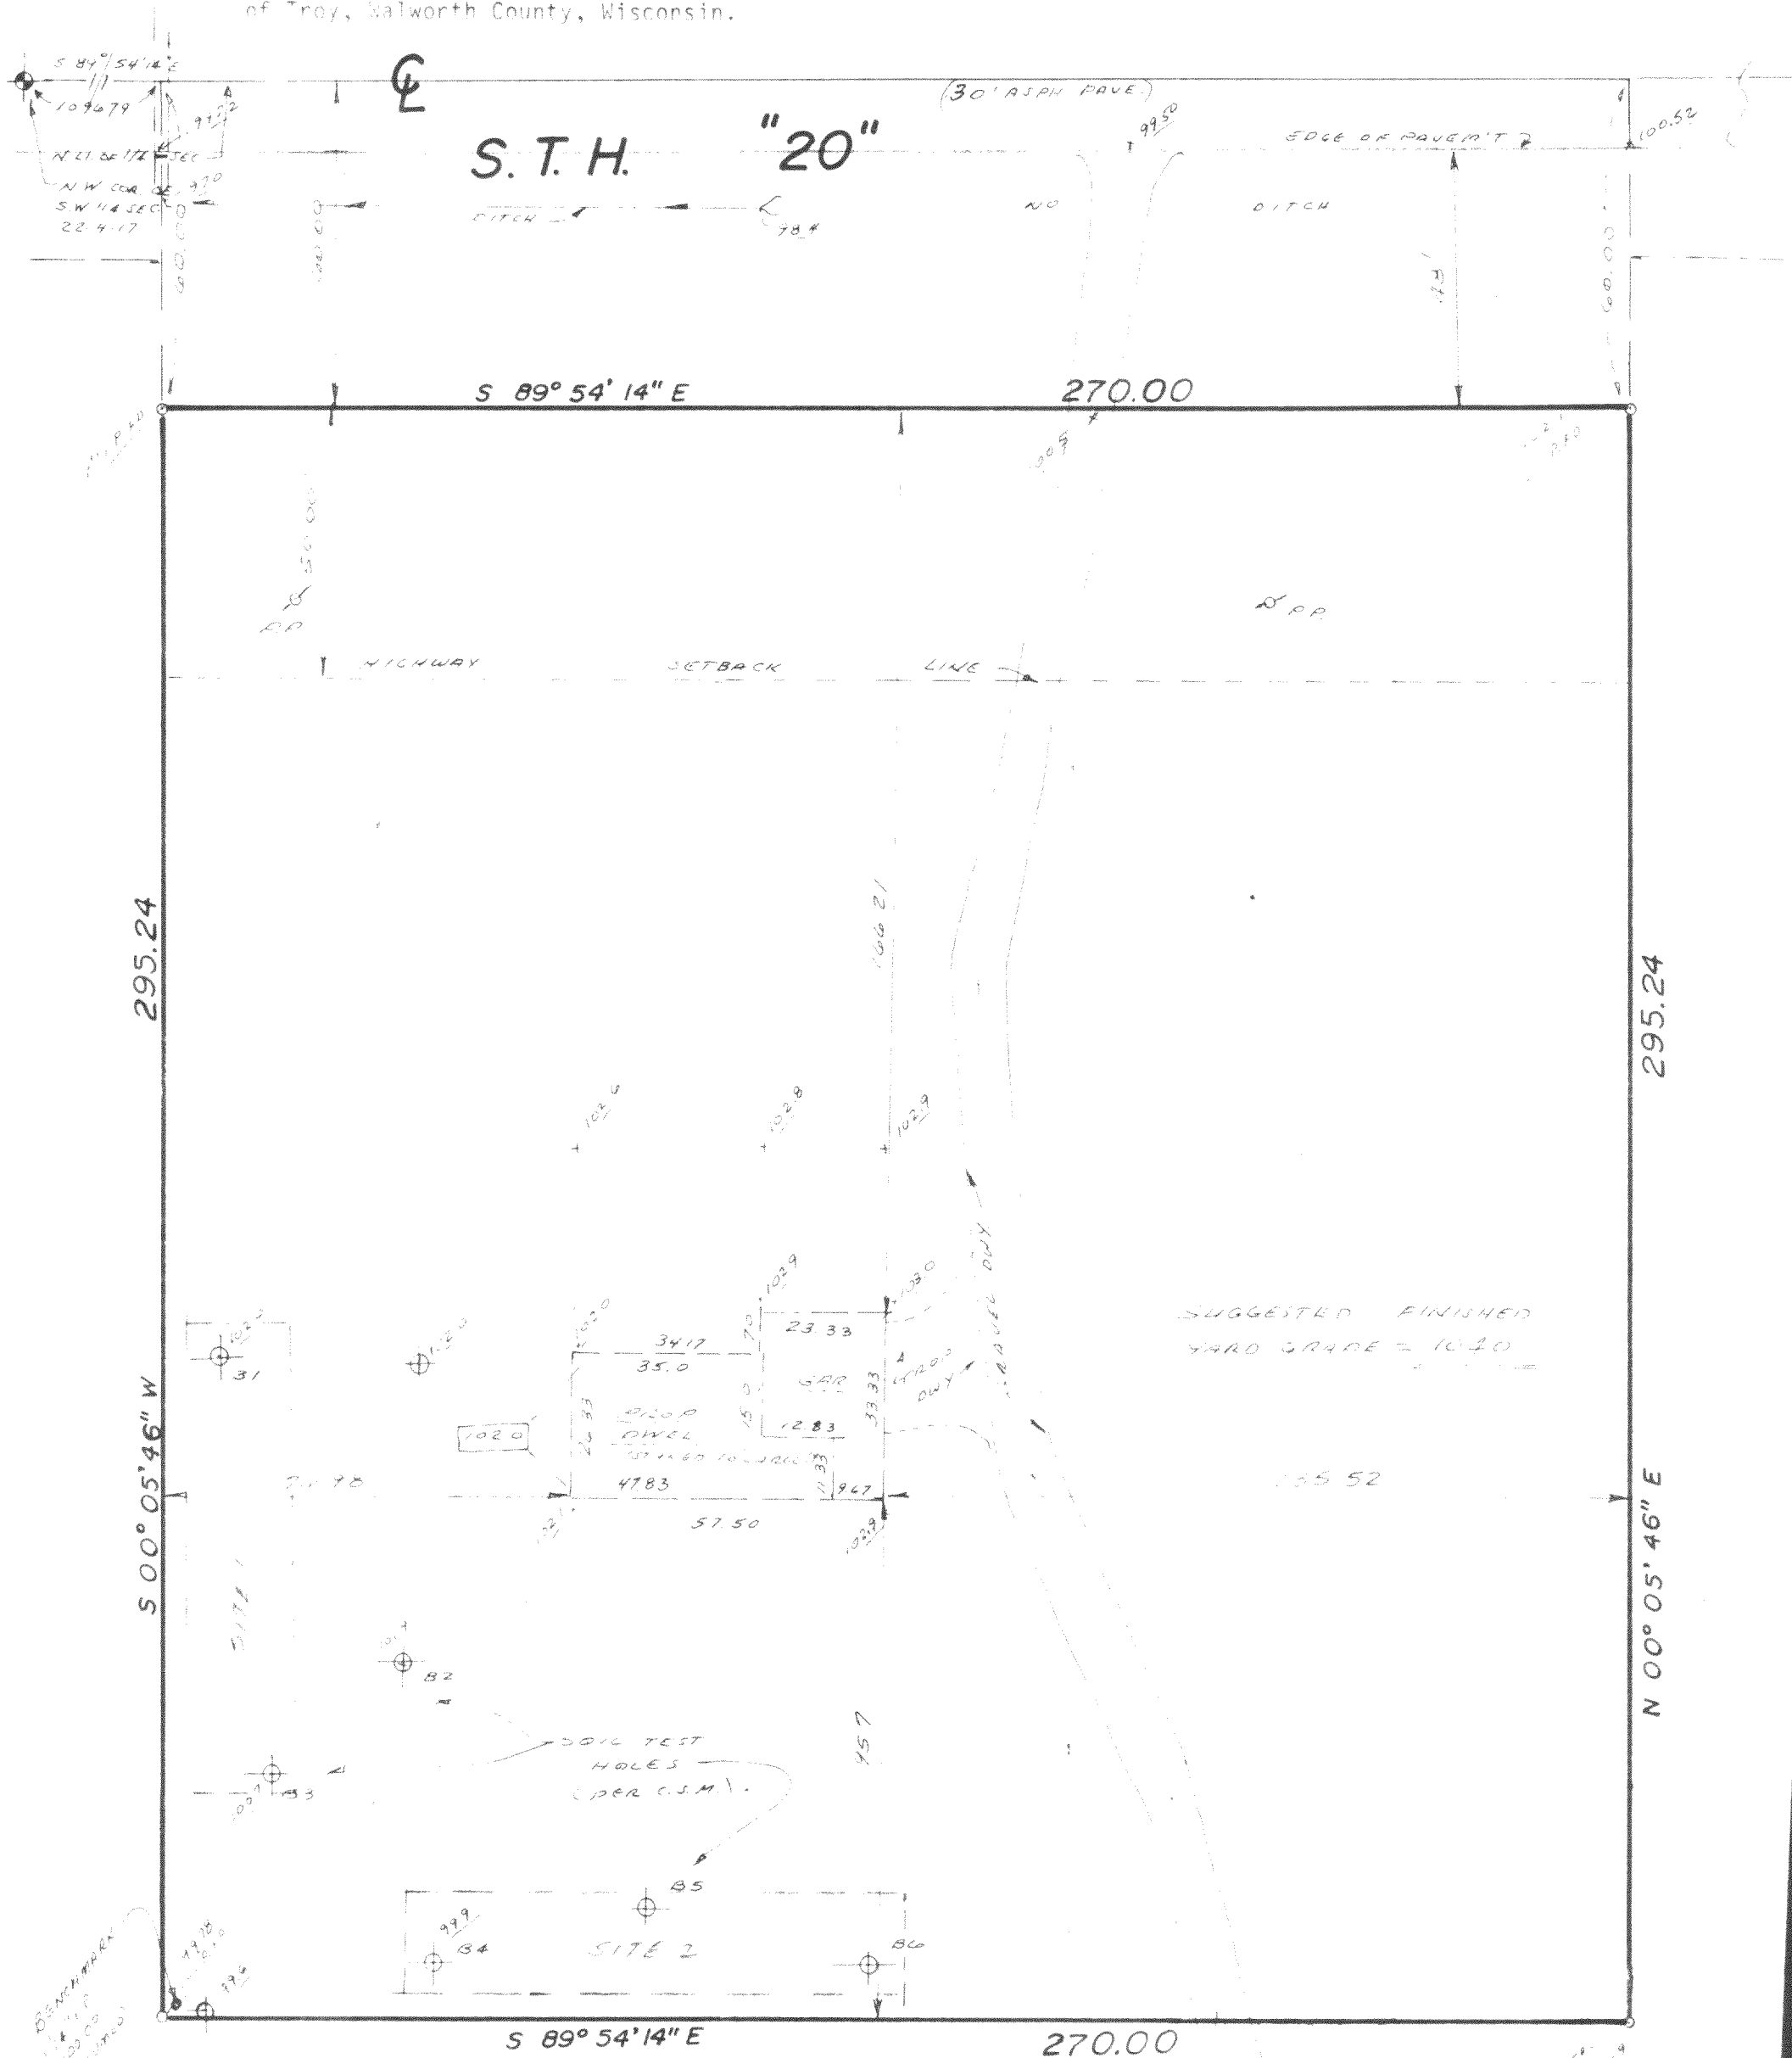


PLAT OF SURVEY

SURVEY FOR: WOLTER BROS. BUILDERS
LOCATION: S.T.H. "20"

BREHM

DESCRIPTION: LOT 1 CERTIFIED SURVEY MAP NO. _____, being a part of the N.W. 1/4 and N.E. 1/4 of the S.W. 1/4 of Section 22, Town 4 North, Range 17 East, Town of Troy, Walworth County, Wisconsin.

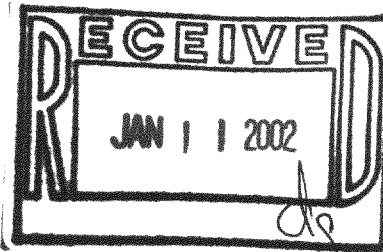

SURVEY CERTIFICATE

We, International Survey Services, Inc., certify that we have surveyed the above described property and that this map is a true representation thereof, and shows the size and location of the property, its exterior boundaries, the location dimensions of all visible features, easements, apparent easements and roadways and visible encroachments, and the location of the exclusive use of the present owners of the Property, and also the location of the mortgage, or guarantee the title thereto, within one (1) year from the date of this survey.

Gary J. Smith
Wisconsin Registered Land Surveyor





JOB NO 27840
DATED 7-26-00

LA-3253-1
417-652

PLAT OF SURVEY

SURVEY FOR: WOLTER BROS. BUILDERS
LOCATION: S.T. H. "20" BREHM
DESCRIPTION: LOT 1 CERTIFIED SURVEY MAP NO. _____, being a part of the N.W. 1/4 and N.E. 1/4 of the S.W. 1/4 of Section 22, Town 4 North, Range 17 East, Town of Troy, Walworth County, Wisconsin.

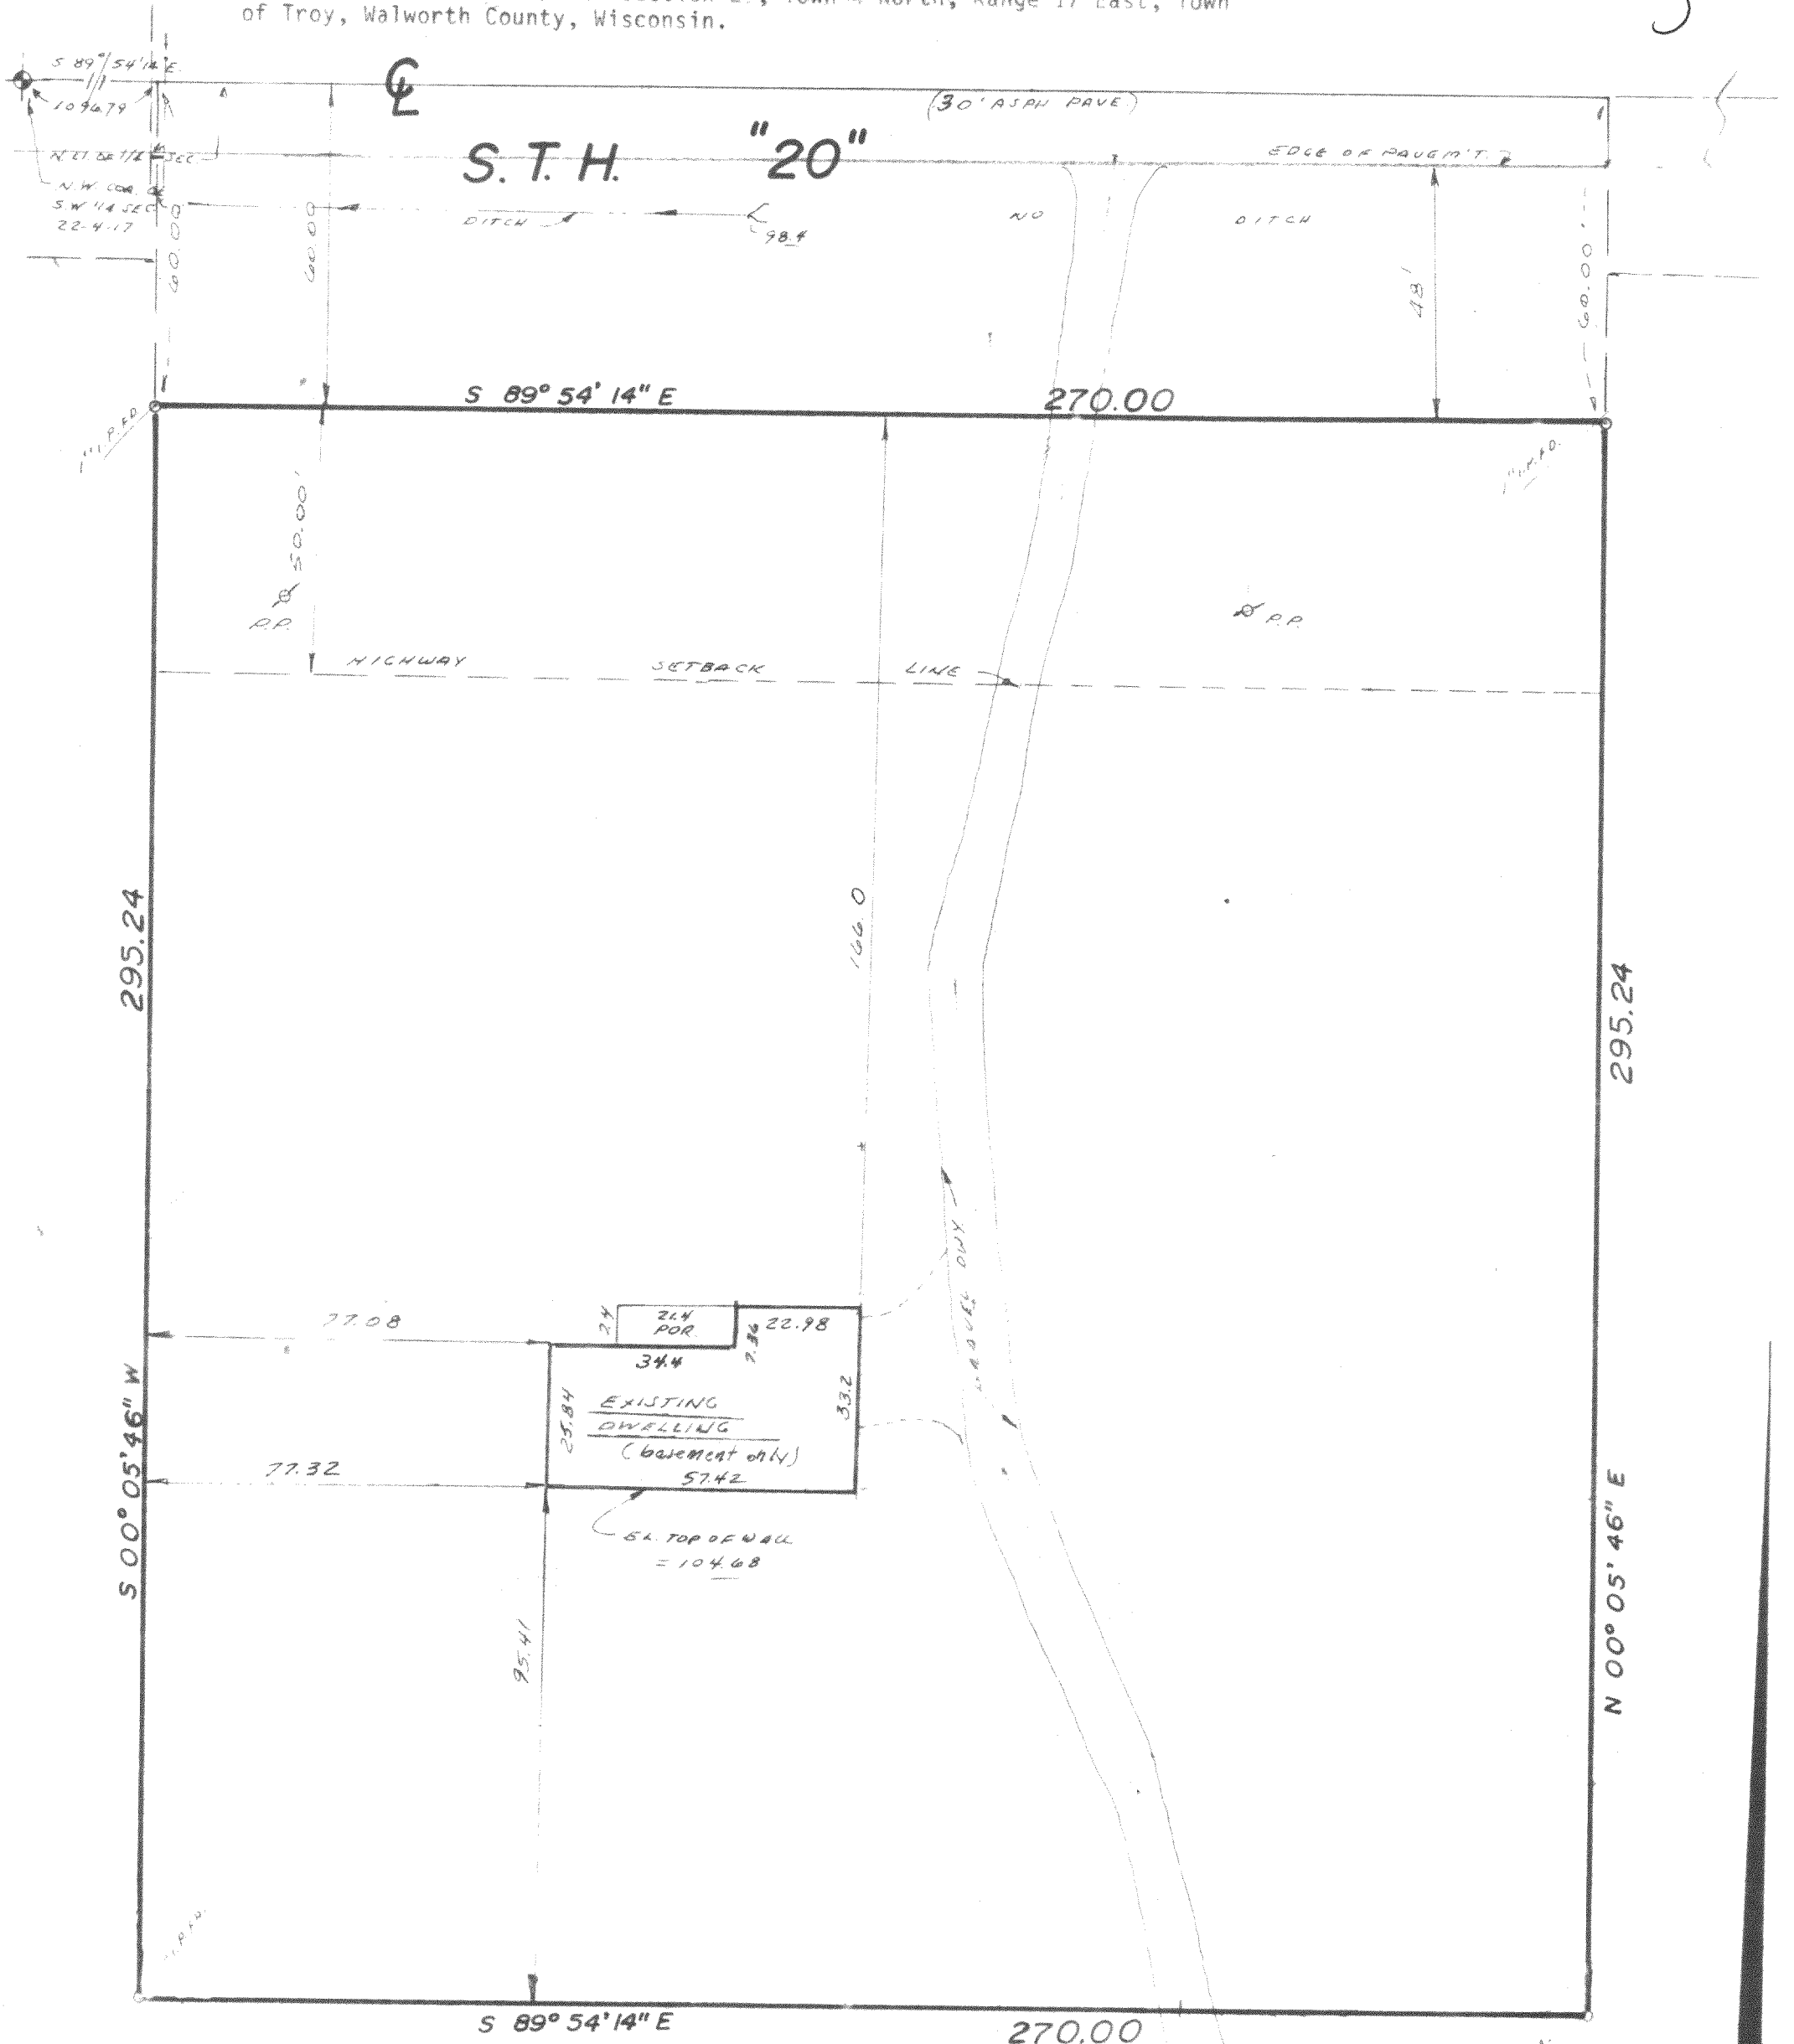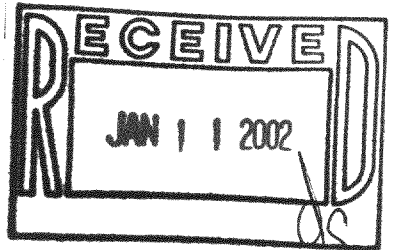

SURVEY CERTIFICATE

State of Wisconsin)
 Milwaukee County) ss

We, Interline Survey Services, Inc., certify that we have surveyed the above described property and the above map is a true representation thereof, and shows the size and location of the property, its exterior boundaries, the location dimensions of all visible structures thereon, fences, apparent easements and roadways and visible encroachments, if any.

This survey is made for the exclusive use of the present owners of the Property, and also those who purchase, mortgage, or guarantee the title thereto, within one (1) year from date hereof.

Gary J. Smith
 Wisconsin Registered Land Surveyor



JOB NO. 27926
 DATED 11/10/00