



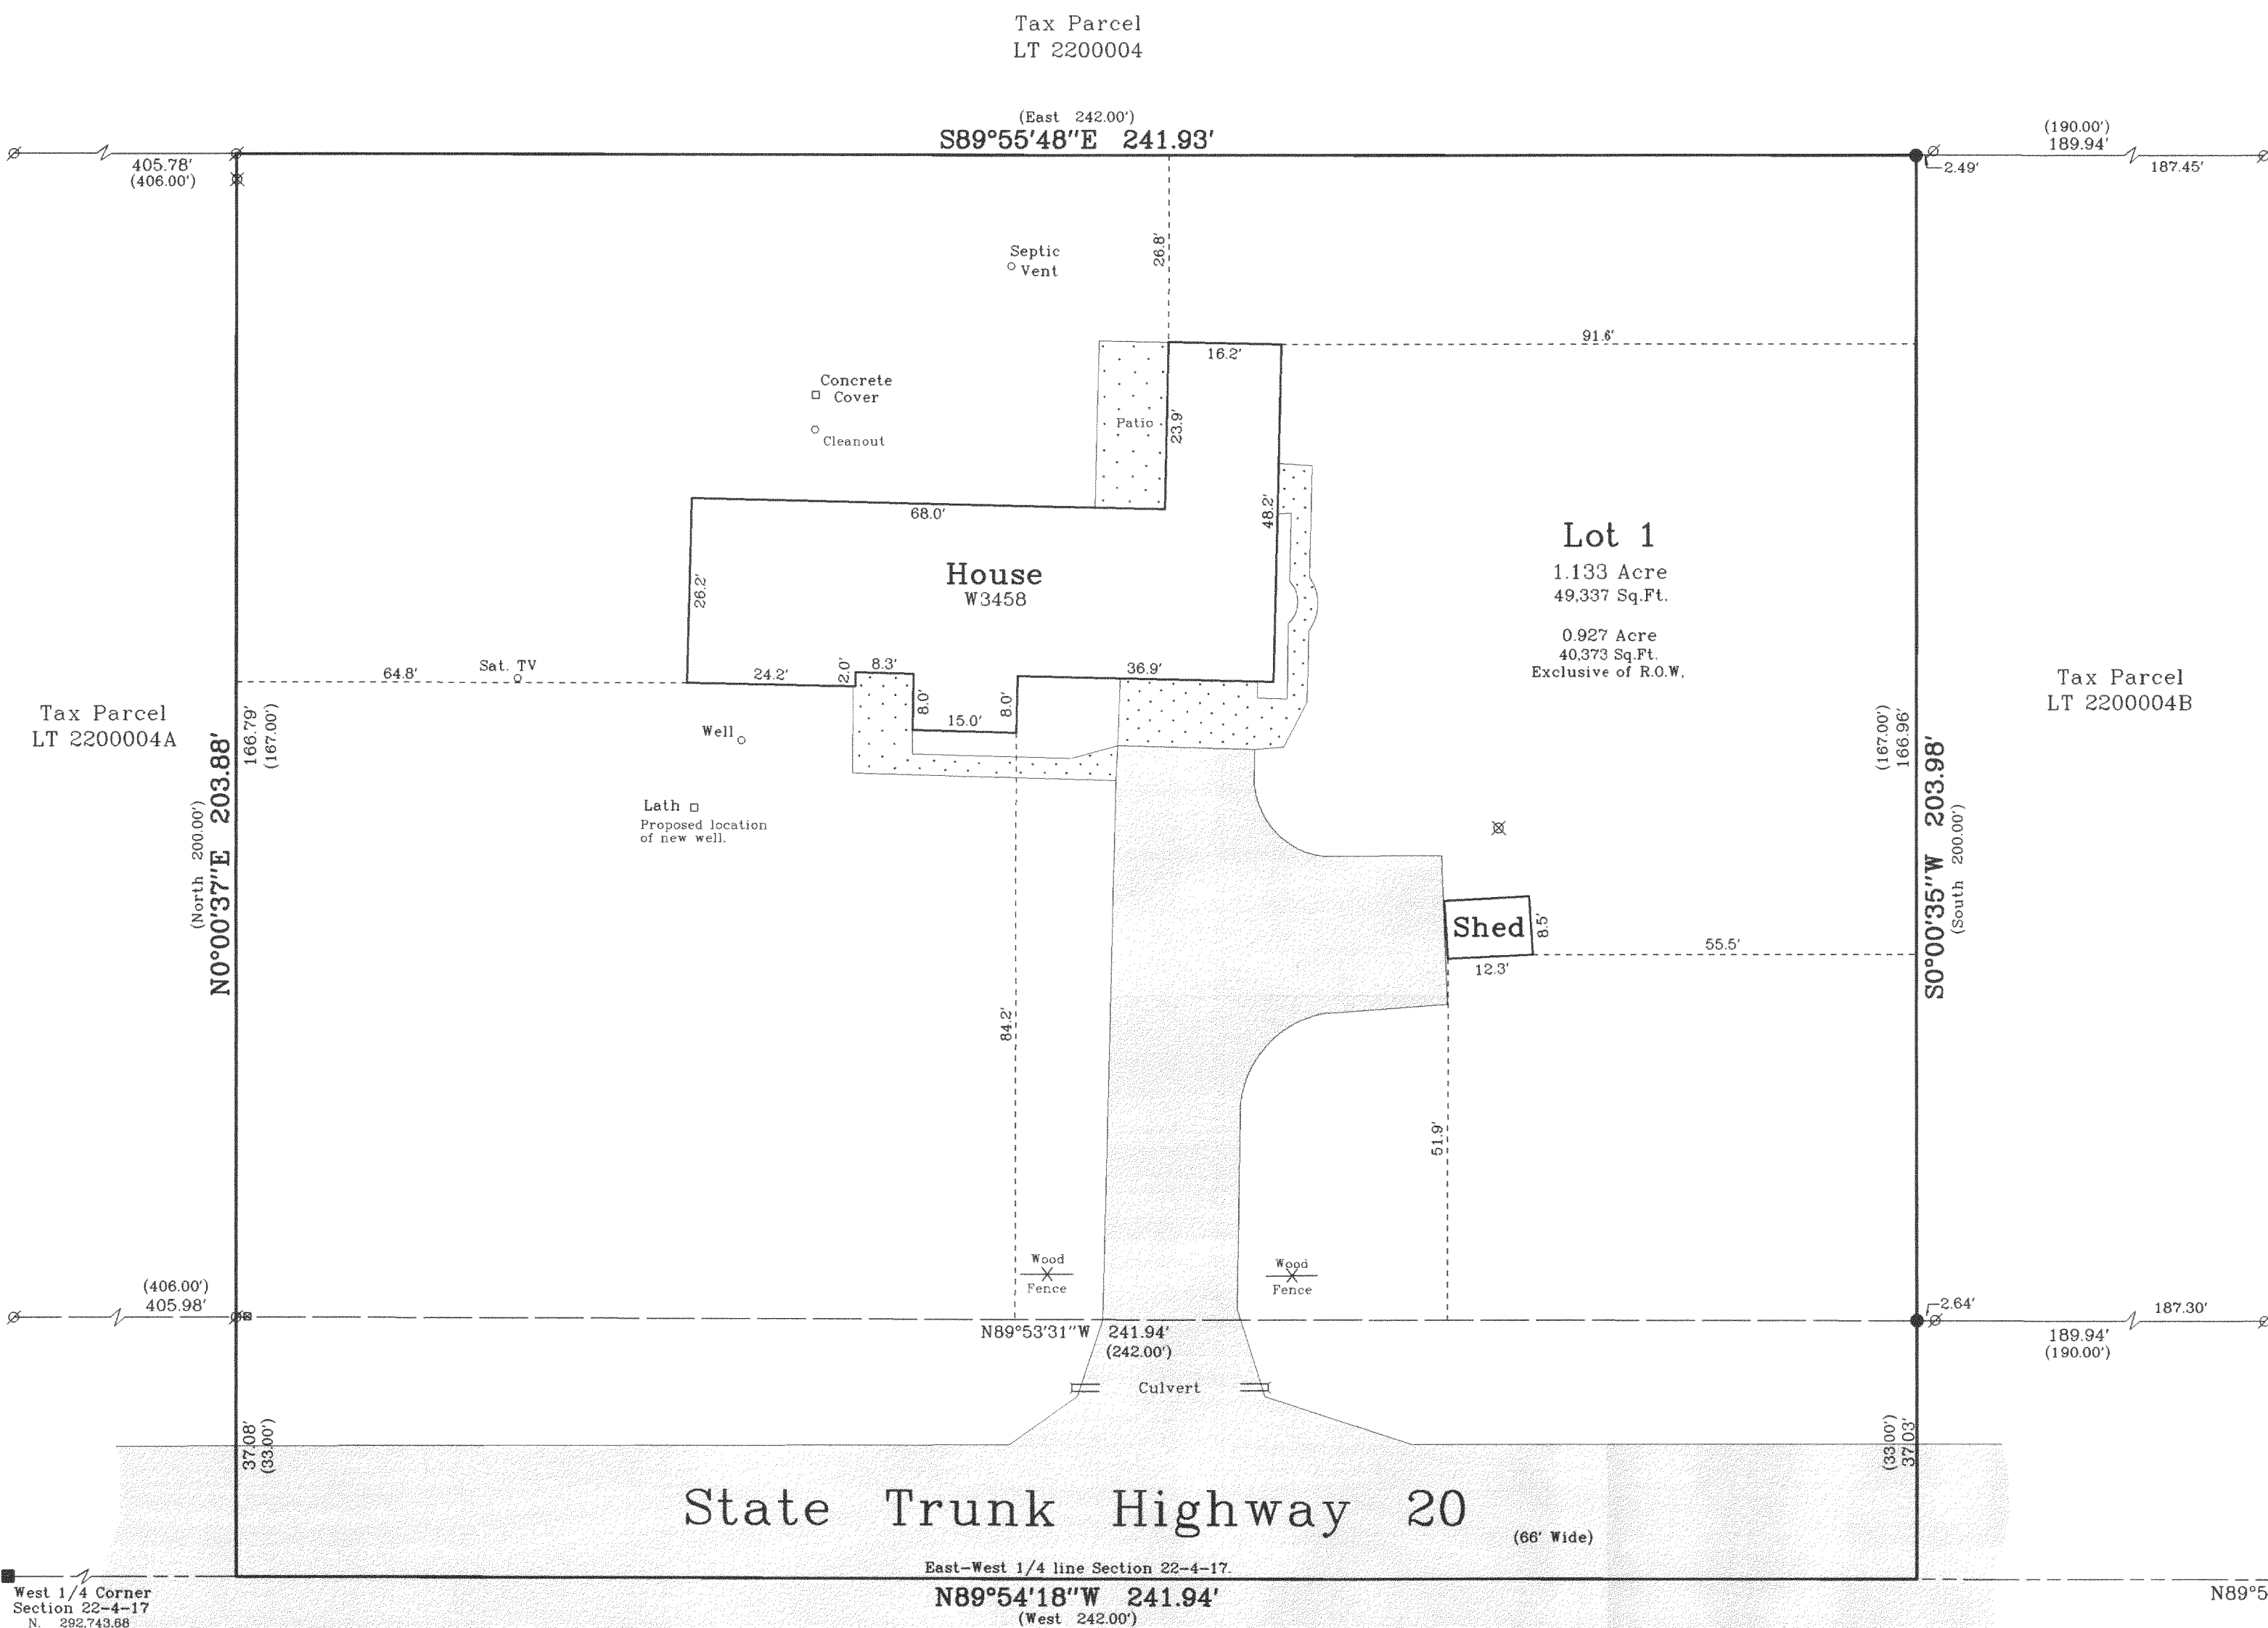


Plat of Survey

of
Lot 1 of Certified Survey Map No. 246,
recorded in Vol. 1 of Certified Survey Maps of Walworth
County on Page 246 and located in the Southwest 1/4
of the Northeast 1/4 of Section 22, Town 4 North, Range
17 East, Town of Troy, Walworth County, Wisconsin.

Surveyed for: **Richard Healey**
W3458 State Road 20
East Troy, Wisconsin. 53120

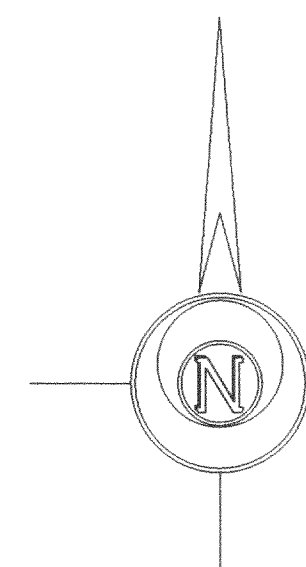

Bearings reference to the Wisconsin State
Plane Coordinate System, South Zone.

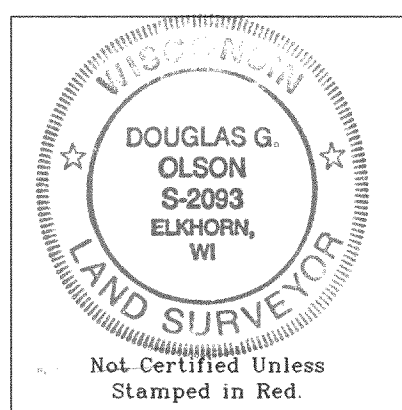

- Notes: 1) This survey plat is not
certified unless signed
and sealed in red ink.
2) This survey is subject to Wisconsin lien laws.
This Plat of Survey is the notice of intent
to file lien. Lien waiver required.

Copyright © 2002 by Jensen & Olson Land Surveying, LLC.

All rights reserved. No part of this survey plat may be reproduced
or transmitted in any form by any means - graphic, electronic, or
mechanical, including photocopying, tracing, or information storage
and retrieval systems - without permission in writing from Douglas
G. Olson, Jensen & Olson Land Surveying, LLC.

I hereby certify that I have surveyed the above described
property and the map hereon is correct to the best of my professional
knowledge and belief and shows the size and location of the property,
its exterior boundaries, the location and dimensions of all visible
structures thereon, boundary fences, apparent easements and roadways
and visible encroachments, if any.
This survey is made for the exclusive use of the present owners
of property, and also those who purchase, mortgage or guarantee title
thereto, within one year from the date hereof.

Douglas G. Olson
Wisconsin Registered Land Surveyor - 2093

Survey Date: October 15, 2002.
Revisions: No. 1 - Survey for

Scale in Feet
1" = 20'



Jensen & Olson Land Surveying, LLC

45 South Wisconsin Street P.O. Box 322
Elkhorn, Wisconsin 53121
Telephone (262) 723-3434
Facsimile (262) 723-8044

Legend
■ Found County Section Corner
● Found Iron Rod, 3/4" dia.
● Set Iron Rod, 3/4" dia.
○ Recorded Information
X Light Pole
+ Concrete Surface
- Asphalt Surface

Sheet 1 of 1 Sheets

Job Reference Number
2002.179

2002.179