



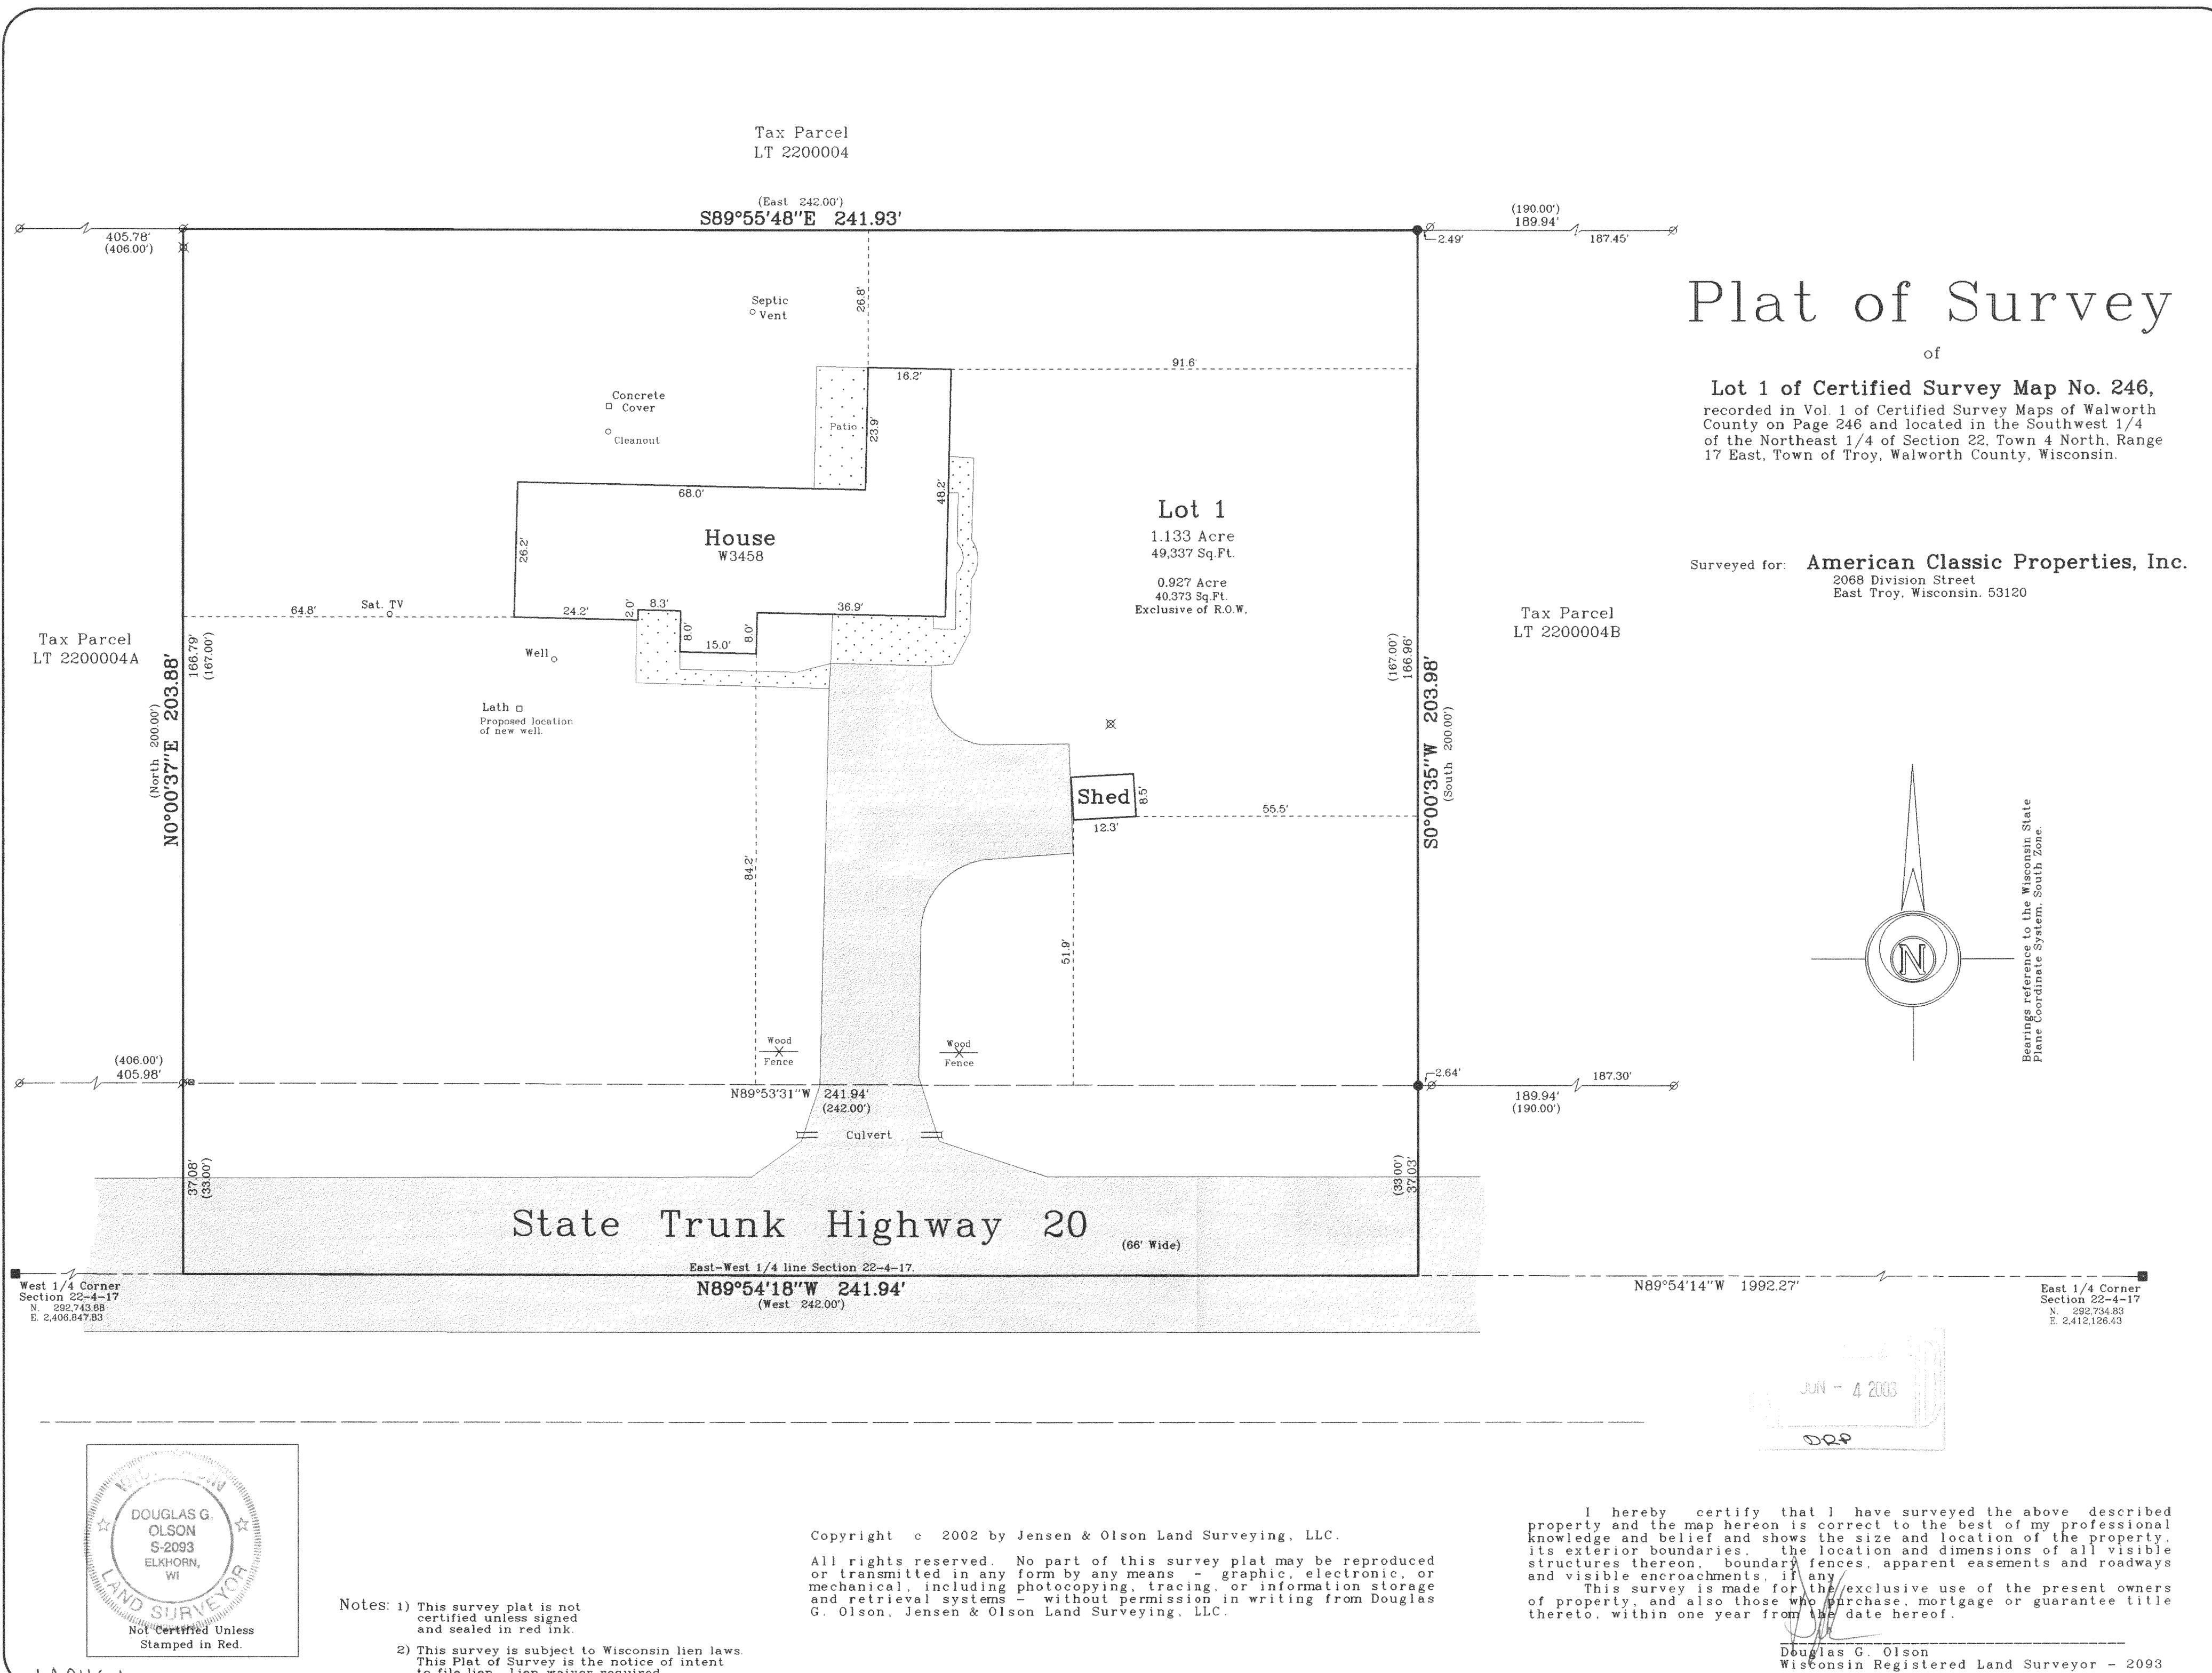

Plat of Survey


of
Lot 1 of Certified Survey Map No. 246,
recorded in Vol. 1 of Certified Survey Maps of Walworth
County on Page 246 and located in the Southwest 1/4
of the Northeast 1/4 of Section 22, Town 4 North, Range
17 East, Town of Troy, Walworth County, Wisconsin.

Surveyed for: **American Classic Properties, Inc.**
2068 Division Street
East Troy, Wisconsin. 53120

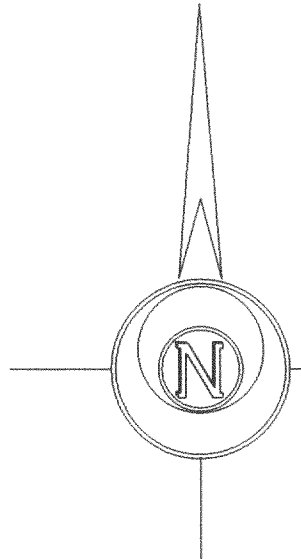

Bearings reference to the Wisconsin State
Plane Coordinate System, South Zone.


Survey Date: October 15, 2002.
Revisions:

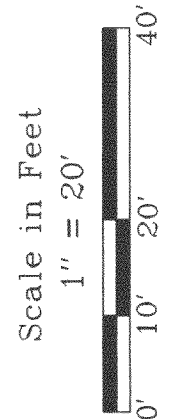

Jensen & Olson Land Surveying, LLC
45 South Wisconsin Street
Elkhorn, Wisconsin 53121
P.O. Box 322
Telephone (262) 723-3434
Facsimile (262) 723-8044

- Legend
- Found County Section Corner
 - Found Iron Pipe
 - Set Iron Rod 3/4" dia.
 - Recorded Information
 - Light Pole
 - Utility Pedestal
 - Concrete Surface
 - Asphalt Surface

Sheet 1 of 1 Sheets
Job Reference Number
2002.179
2002.179

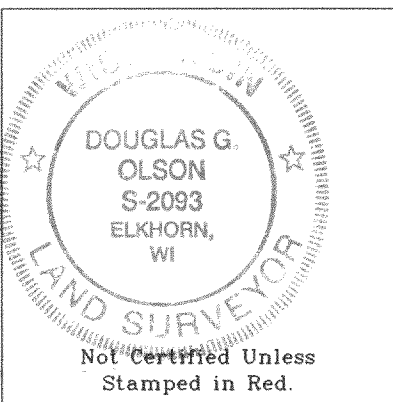

- Notes: 1) This survey plat is not certified unless signed and sealed in red ink.
2) This survey is subject to Wisconsin lien laws. This Plat of Survey is the notice of intent to file lien. Lien waiver required.

Copyright © 2002 by Jensen & Olson Land Surveying, LLC.
All rights reserved. No part of this survey plat may be reproduced or transmitted in any form by any means - graphic, electronic, or mechanical, including photocopying, tracing, or information storage and retrieval systems - without permission in writing from Douglas G. Olson, Jensen & Olson Land Surveying, LLC.

I hereby certify that I have surveyed the above described property and the map hereon is correct to the best of my professional knowledge and belief and shows the size and location of the property, its exterior boundaries, the location and dimensions of all visible structures thereon, boundary fences, apparent easements and roadways and visible encroachments, if any.
This survey is made for the exclusive use of the present owners of property, and also those who purchase, mortgage or guarantee title thereto, within one year from the date hereof.

Douglas G. Olson
Wisconsin Registered Land Surveyor - 2093

LA-246-1

417-697