
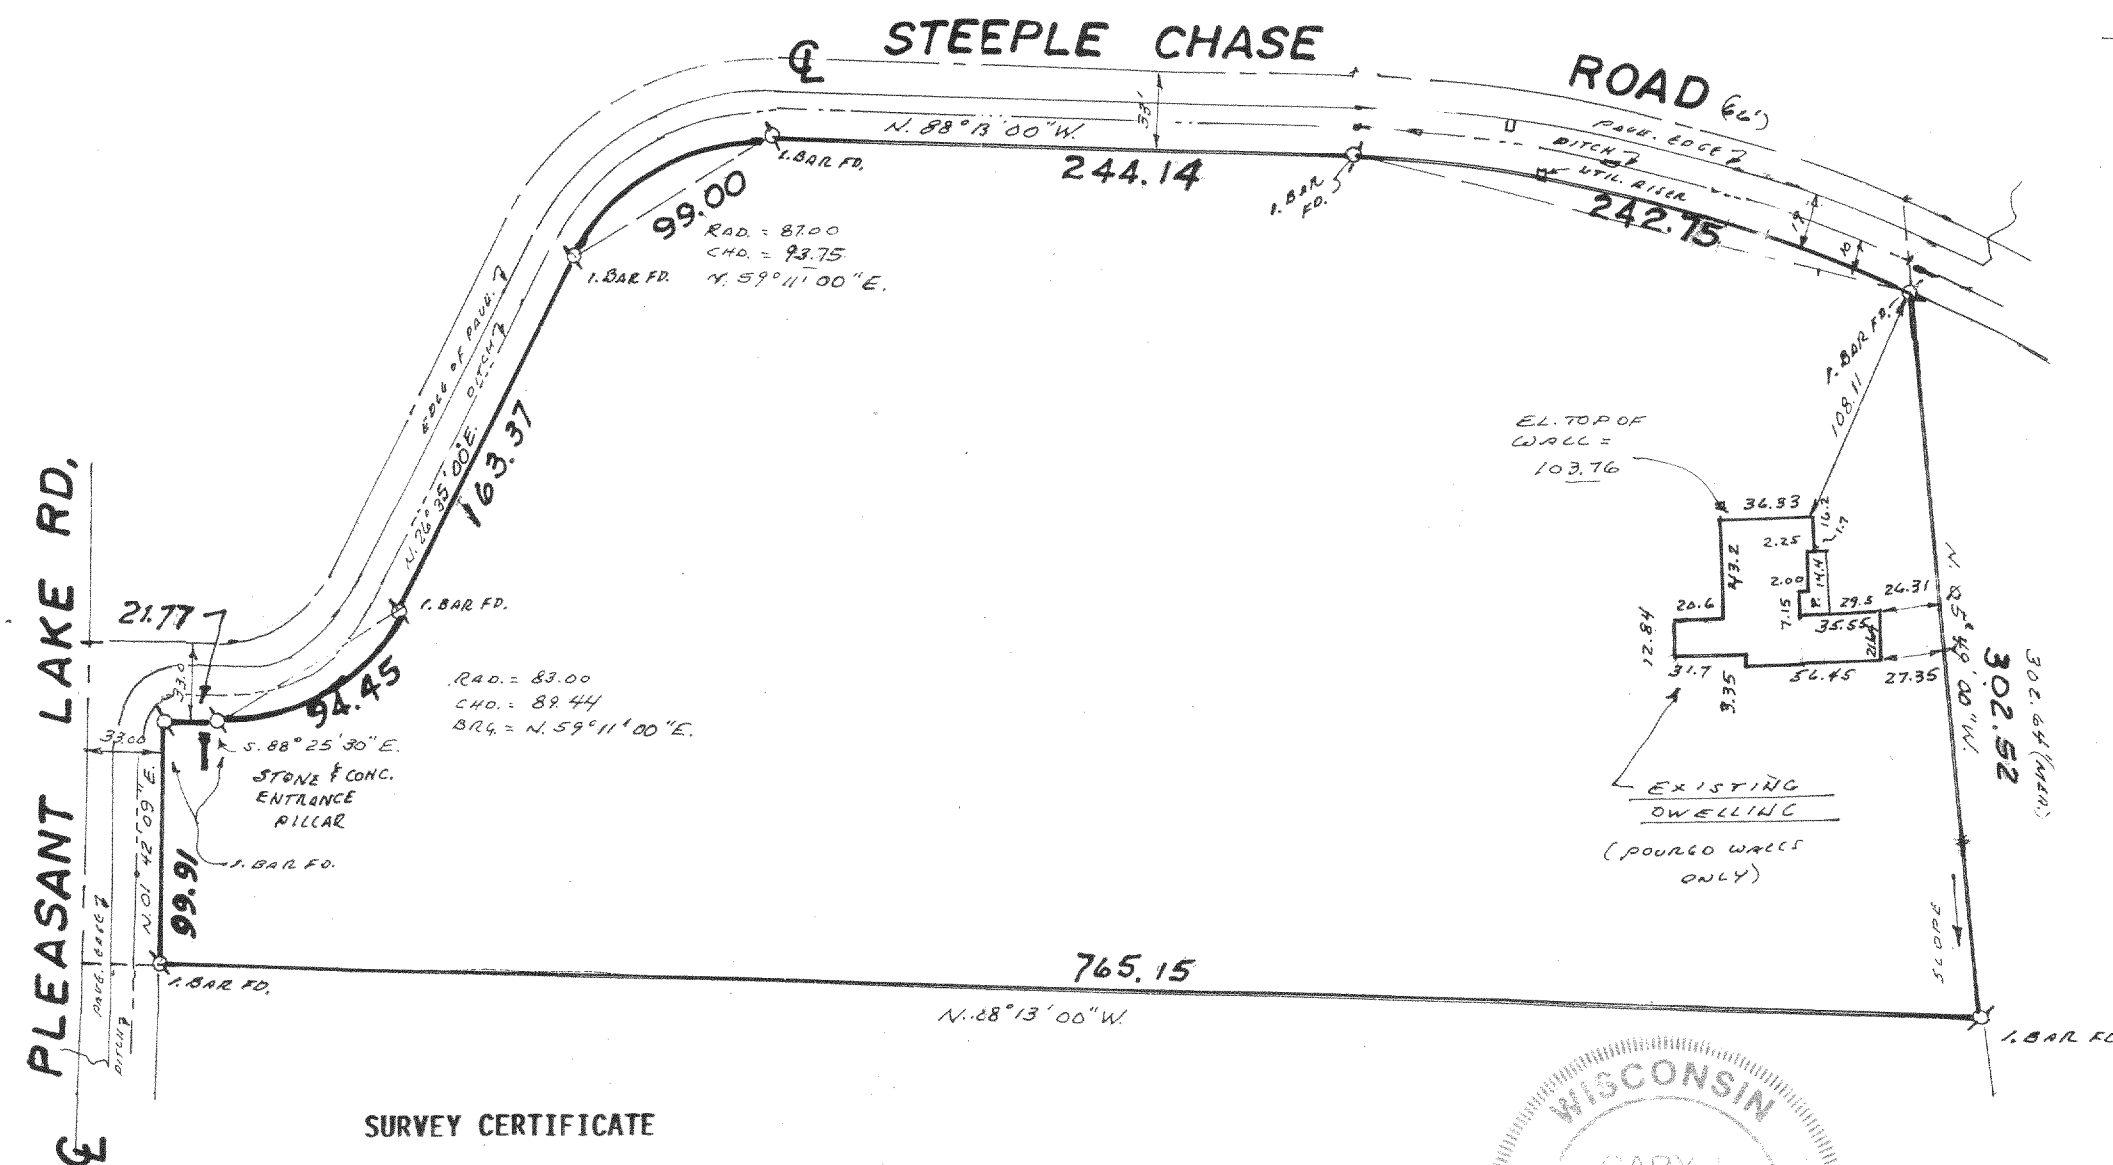


"RECERTIFICATION" PLAT OF SURVEY

SURVEY FOR: WOLTER BROS. BUILDERS
LOCATION:

JOHNSON

DESCRIPTION: LOT 18 SADDLE CLUB OF WALWORTH COUNTY, a subdivision located in the Northwest, Northeast, Southwest, and Southeast 1/4's of the Southwest 1/4 of Section 30, and the Northwest and Northeast 1/4's of the Northwest 1/4 of Section 31, Town 4 North, Range 17 East, Town of Troy, Walworth County, Wisconsin.

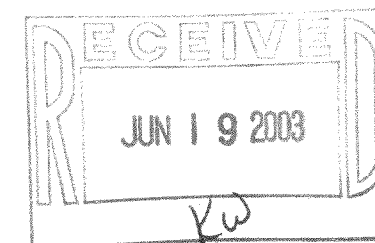


SURVEY CERTIFICATE

State of Wisconsin)
Milwaukee County)ss

We, Interline Survey Services, Inc., certify that we have surveyed the above described property and the above map is a true representation thereof, and shows the size and location of the property, its exterior boundaries, the location and dimensions of all visible structures thereon, fences, apparent easements and roadways and visible encroachments, if any.

This survey is made for the exclusive use of the present owners of the Property, and also those who purchase mortgage, or guarantee the title thereto, within one (1) year from date hereof.

Gary J. Smith
Wisconsin Registered Land Surveyor

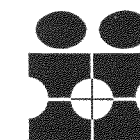

INTERLINE SURVEY SERVICES, INC.
10521 W. FOREST HOME AVE. STE. 201
HALES CORNERS, WI 53130
PHONE 425-2060

JOB NO. 29288
DATED: 03-12-03

417-700

✓ LSC-18