


PLAT OF SURVEY

FOR: AMERICAN CLASSIC PROPERTIES, INC. DATE: 7/30/2003

DESCRIPTION: BEING LOT 1 OF CSM # 553, LOCATED IN PART OF THE SE 1/4 OF SECTION 12, AND THE NE 1/4 OF SECTION 13, TOWN 4 NORTH, RANGE 17 EAST, TOWN OF TROY, WALWORTH COUNTY, WISCONSIN.

LEGEND

Symbol	Description
●	FOUND 1" IRON PIPE
□	SEPTIC CLEANOUT
△	WELL
⊙	SEPTIC TANK
⊙	SEPTIC VENT
⊙	SATILITE DISH
⊙	POWER POLE
---	EDGE OF PAVEMENT

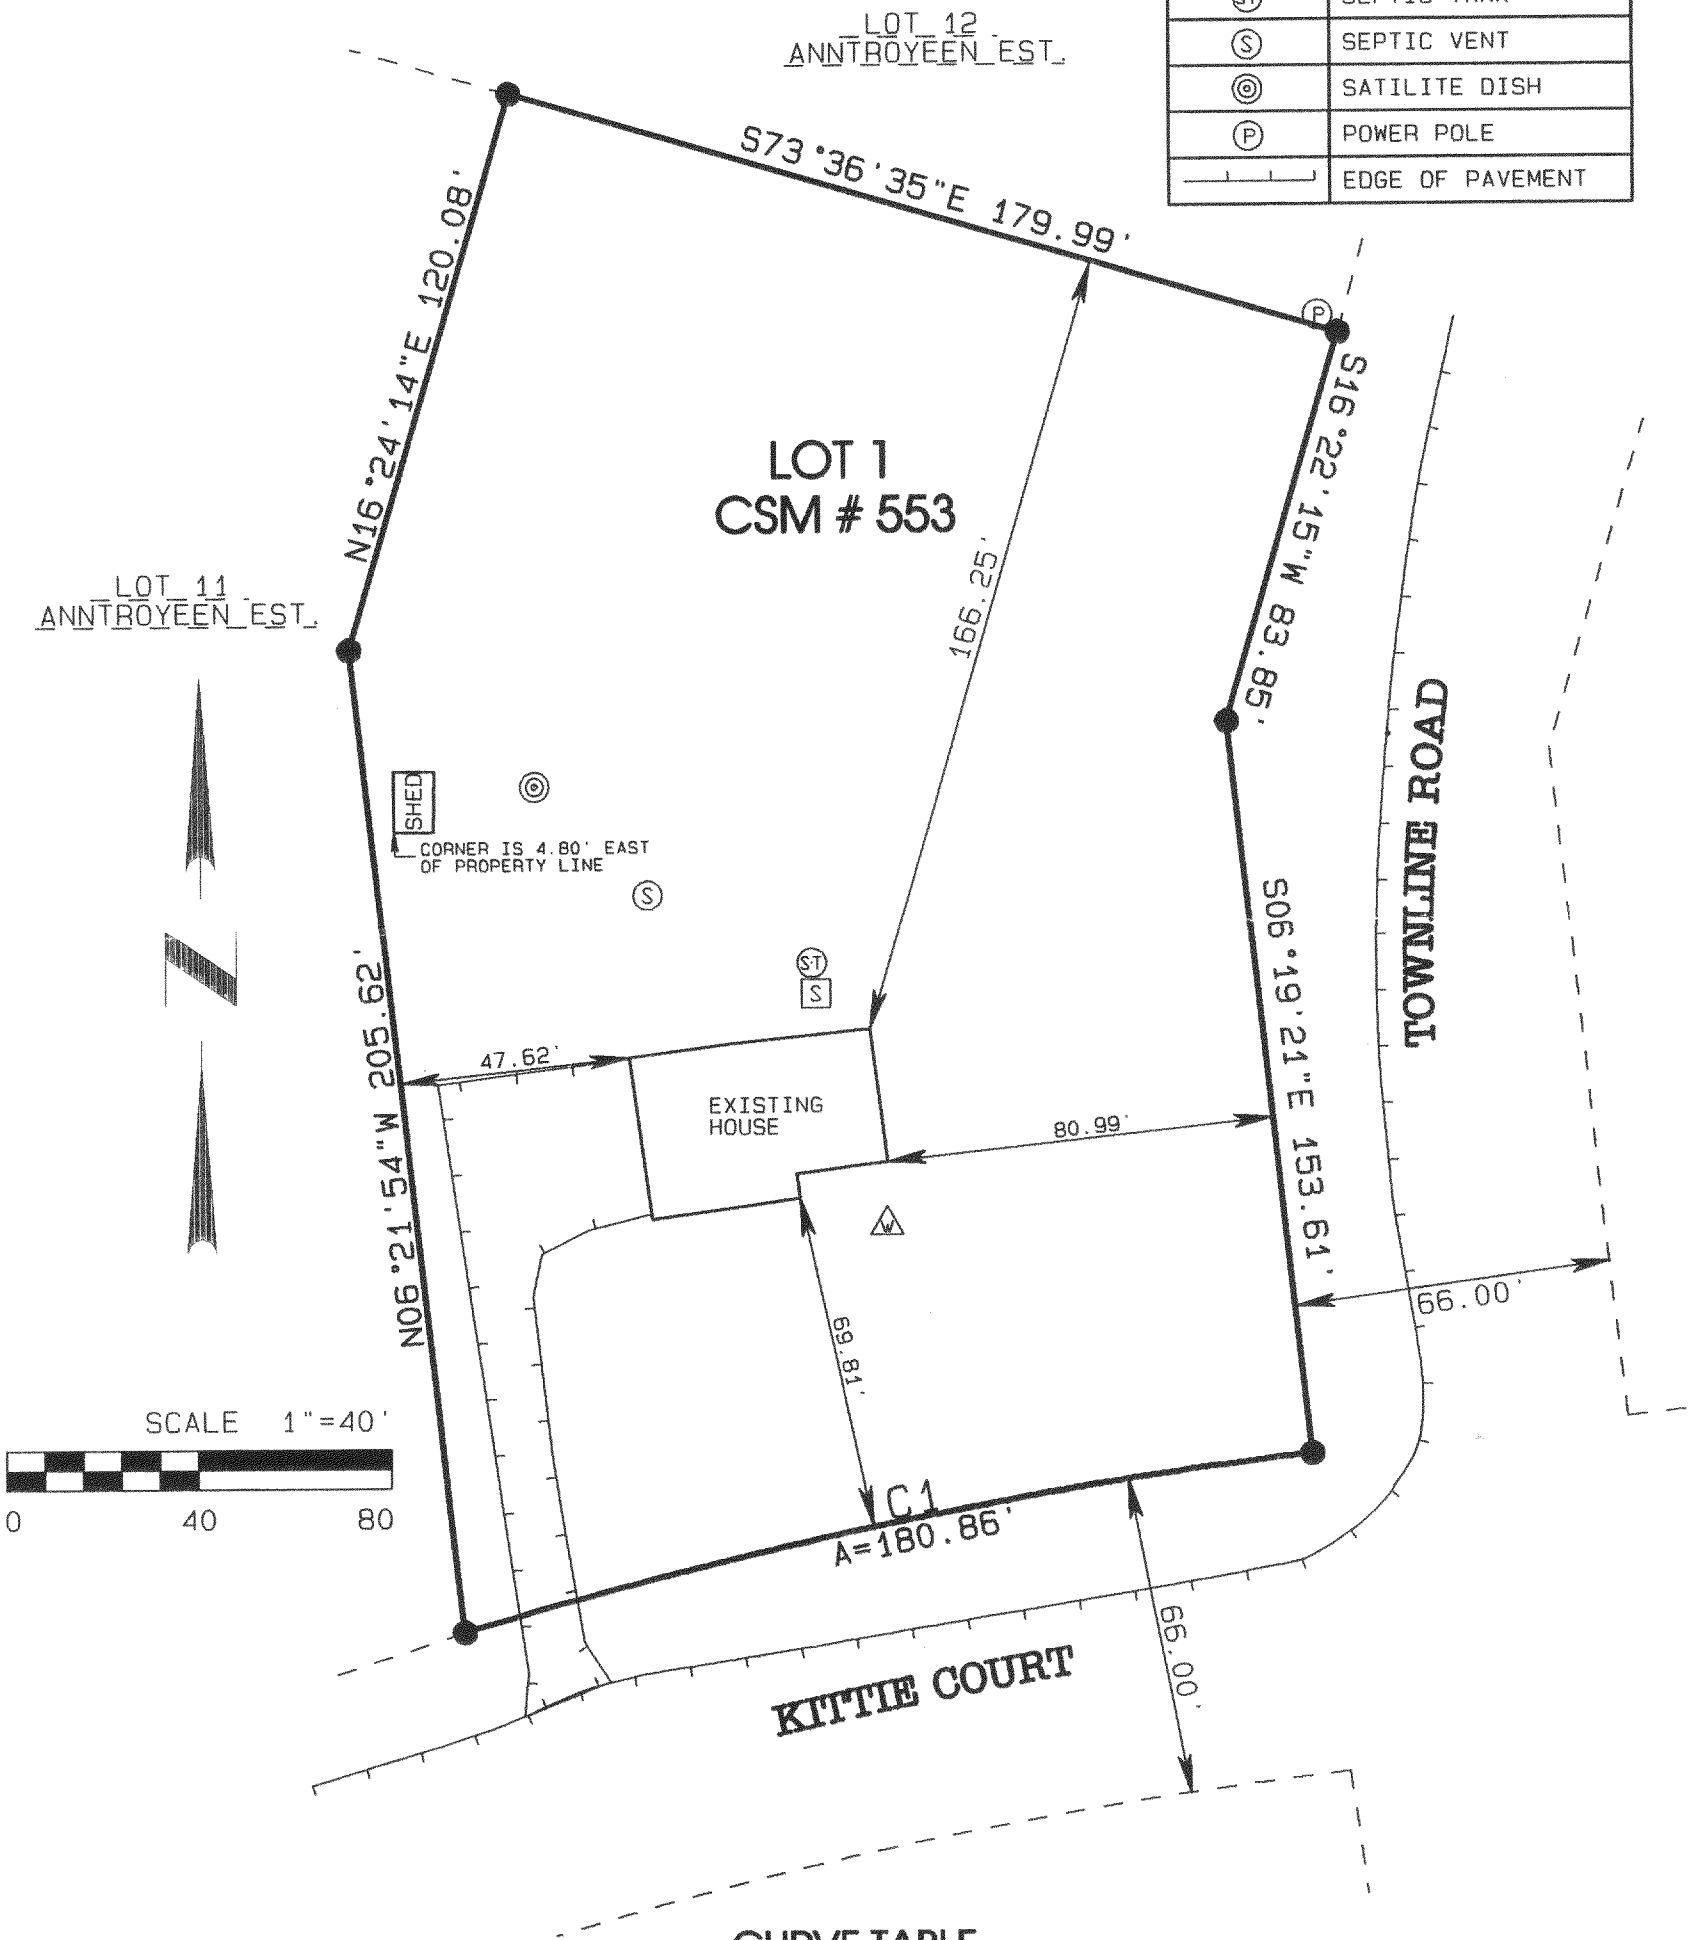


CURVE TABLE

CURVE #	DELTA	RADIUS	ARC	CHORD BEARING	CHORD
C1	10°01'52"	1033.00'	180.86'	N78°37'25"E	180.62'

I PAUL H. VAN HENKELUM R.L.S. # 1931 HEREBY CERTIFY THAT THIS SURVEY WAS MADE IN ACCORDANCE WITH THE MINIMUM STANDARDS FOR PROPERTY SURVEYS (CHAPTER 1-E7) STATE OF WISCONSIN AND HAS BEEN PREPARED UNDER MY DIRECTION AND CONTROL AND IS CORRECT TO THE BEST OF MY KNOWLEDGE AND BELIEF.

PAUL H. VAN HENKELUM R.L.S. #1931
RSVDATE6/BRADTDS03/J03267.PRO

NOV 18 2003
KW

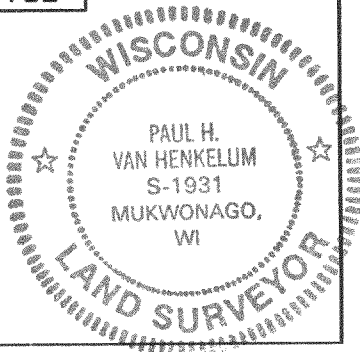

LA 553-1

417-712