
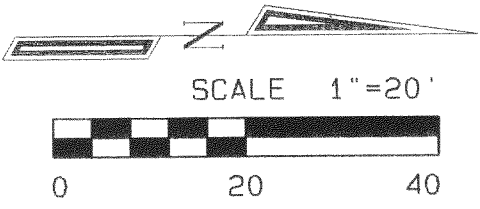


PLAT OF SURVEY

FOR: JEFF WOLF DATE: 9/4/2003

DESCRIPTION:
LOT 40 OF BOOTH LAKE HEIGHTS,
BEING A SUBDIVISION LOCATED IN
THE EAST 1/2 OF THE SW 1/4
AND THE WEST 1/2 OF THE
SE 1/4 OF SECTION 24, TOWN 4
NORTH, RANGE 17 EAST, TOWN OF
TROY, WALWORTH COUNTY, WISCONSIN.

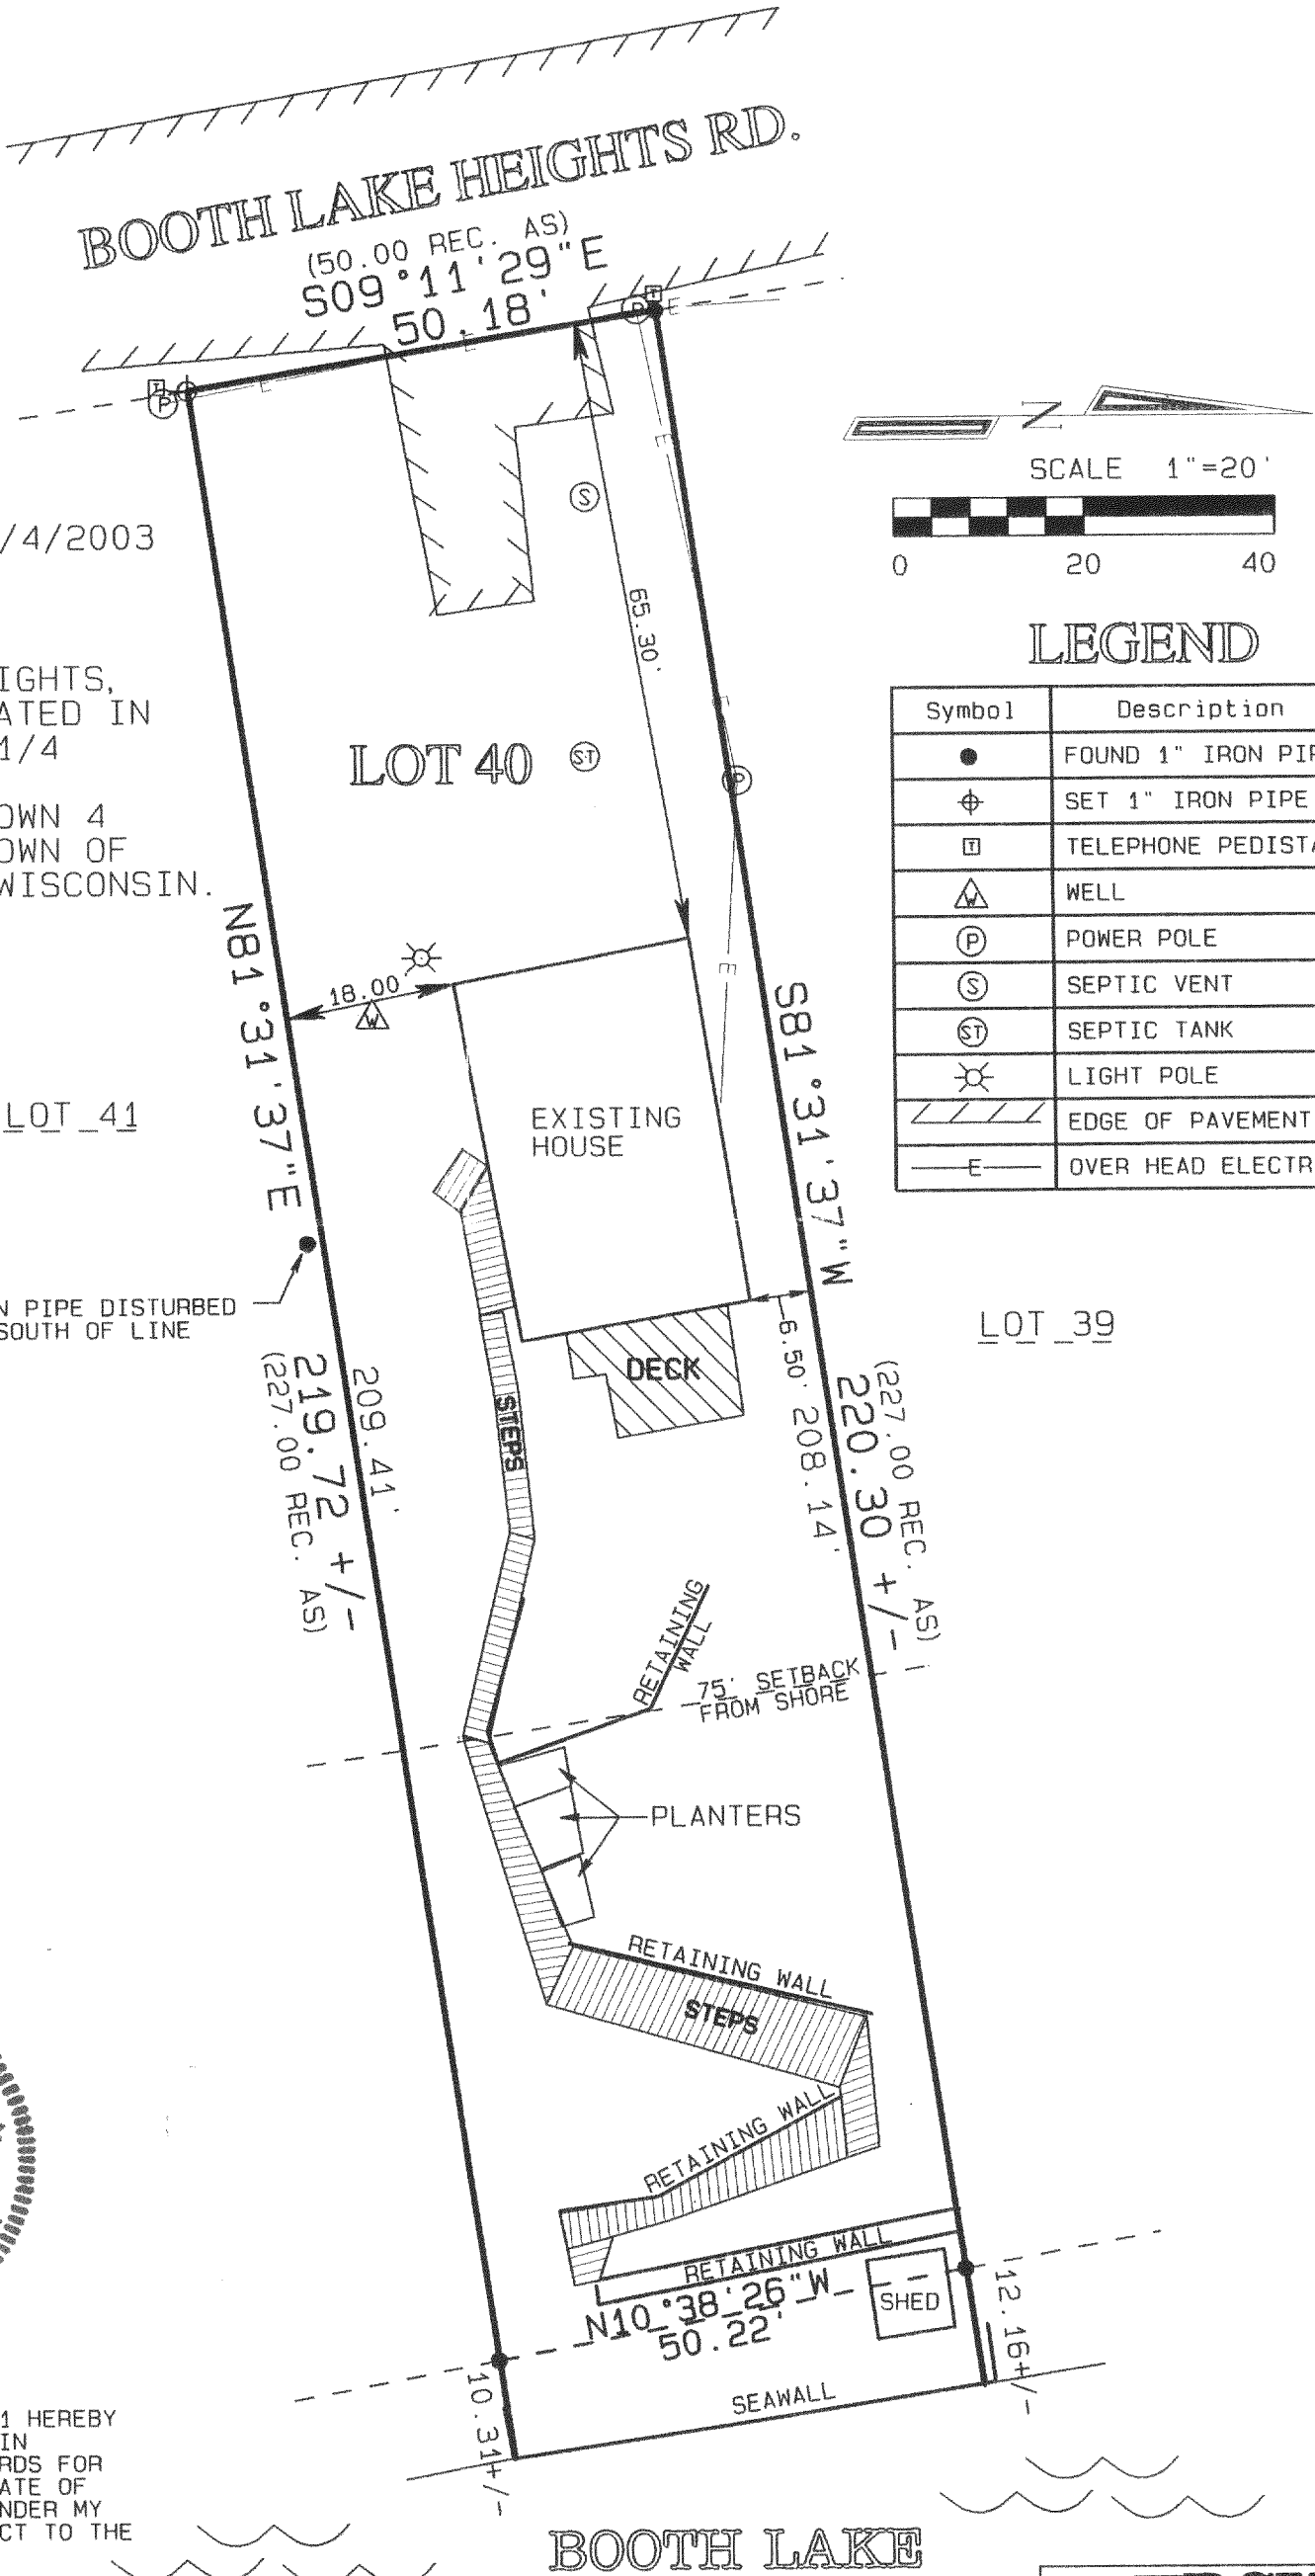

LEGEND

Symbol	Description
●	FOUND 1" IRON PIPE
⊕	SET 1" IRON PIPE
⊞	TELEPHONE PEDISTAL
△	WELL
Ⓟ	POWER POLE
Ⓢ	SEPTIC VENT
ⓈⓉ	SEPTIC TANK
⊗	LIGHT POLE
▨	EDGE OF PAVEMENT
—E—	OVER HEAD ELECTRIC

NOV 18 2003

PAUL H.
VAN HENKELUM
S-1931
MUKWONAGO,
WI

LAND SURVEYOR

I PAUL H. VAN HENKELUM R.L.S # 1931 HEREBY
CERTIFY THAT THIS SURVEY WAS MADE IN
ACCORDANCE WITH THE MINIMUM STANDARDS FOR
PROPERTY SURVEYS (CHAPTER A-E7) STATE OF
WISCONSIN AND HAS BEEN PREPARED UNDER MY
DIRECTION AND CONTROL AND IS CORRECT TO THE
BEST OF MY KNOWLEDGE AND BELIEF.

PAUL H. VAN HENKELUM R.L.S. #1931
RSV DATA6/BRADTDS03/J03286.PRO

RSV
ENGINEERING, INC.
Engineers - Land Surveyors - Environmental Scientists
801 MAIN STREET MUKWONAGO, WISCONSIN 53149 (262) 353-2004

✓ LBL-34

417-713