



PLAT OF SURVEY

DESCRIPTION:
LOT 1 CERTIFIED SURVEY MAP NO. 3008 AS RECORDED IN VOLUME 16 ON PAGE 82
CERTIFIED SURVEY MAPS, A CERTIFIED SURVEY MAP LOCATED IN GOVERNMENT LOT 1
IN THE NORTHWEST 1/4 AND THE SOUTHWEST 1/4 OF THE NORTHEAST 1/4 OF SECTION
24, T.4.N., R.17.E., WALWORTH COUNTY, WISCONSIN.

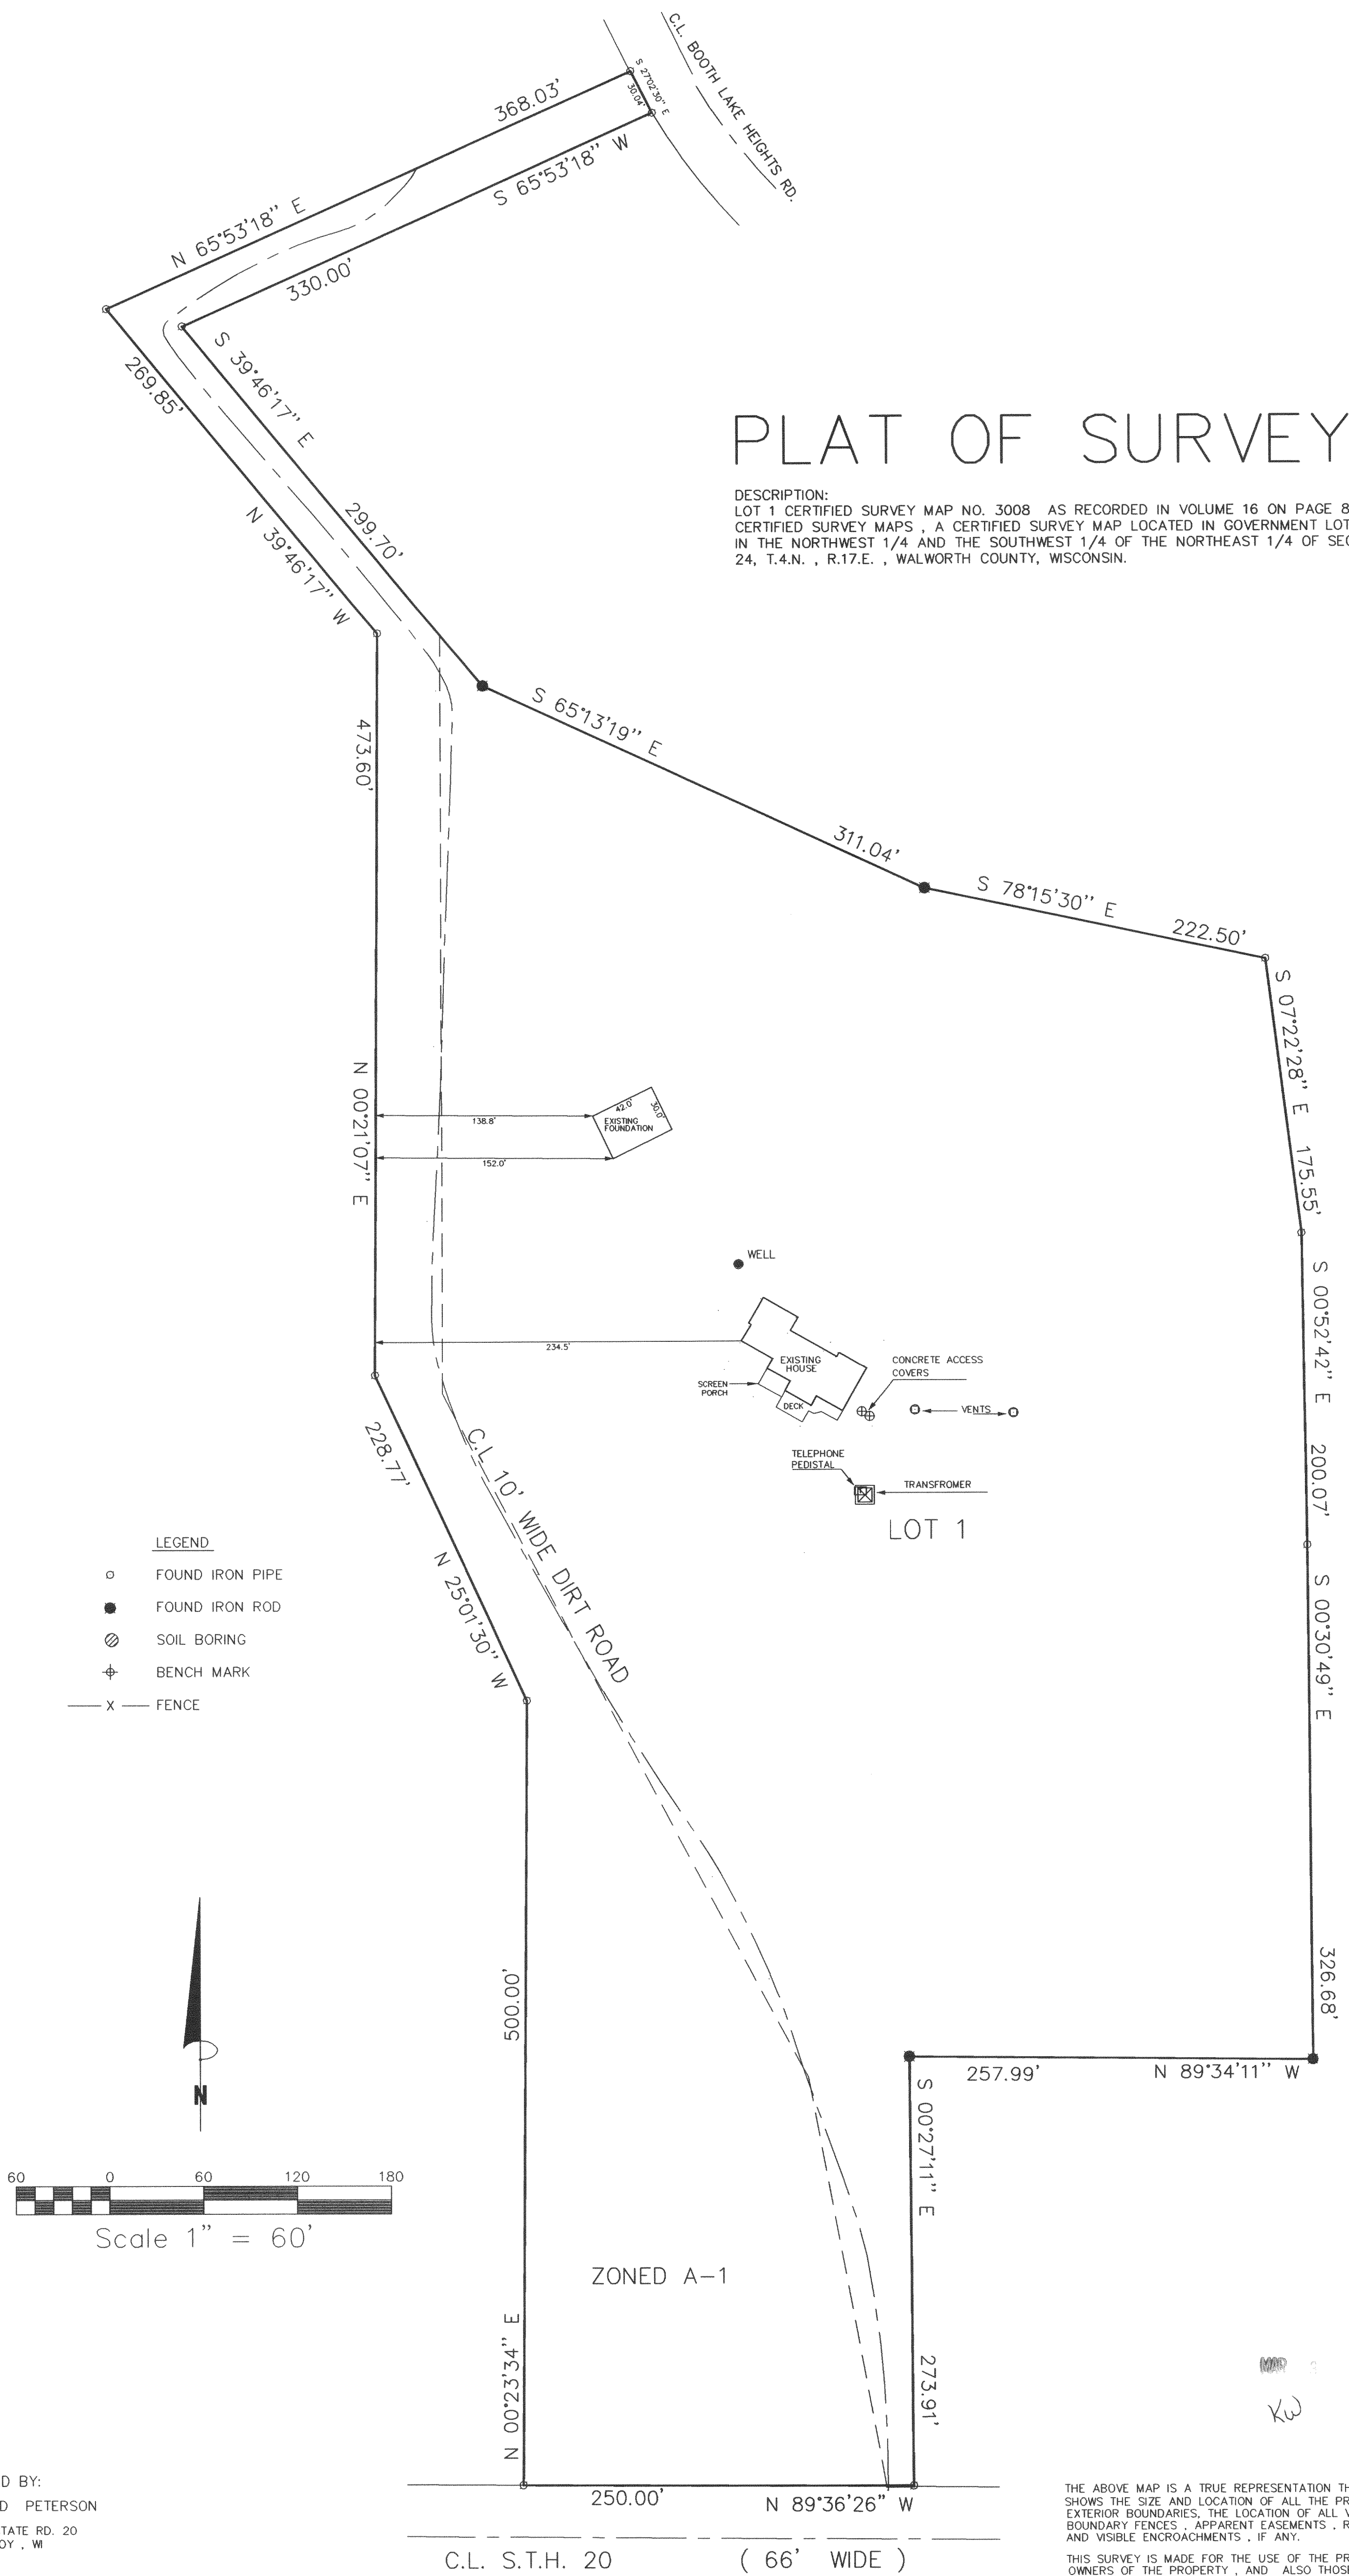

LEGEND

- FOUND IRON PIPE
- FOUND IRON ROD
- ⊗ SOIL BORING
- ⊕ BENCH MARK
- X — FENCE

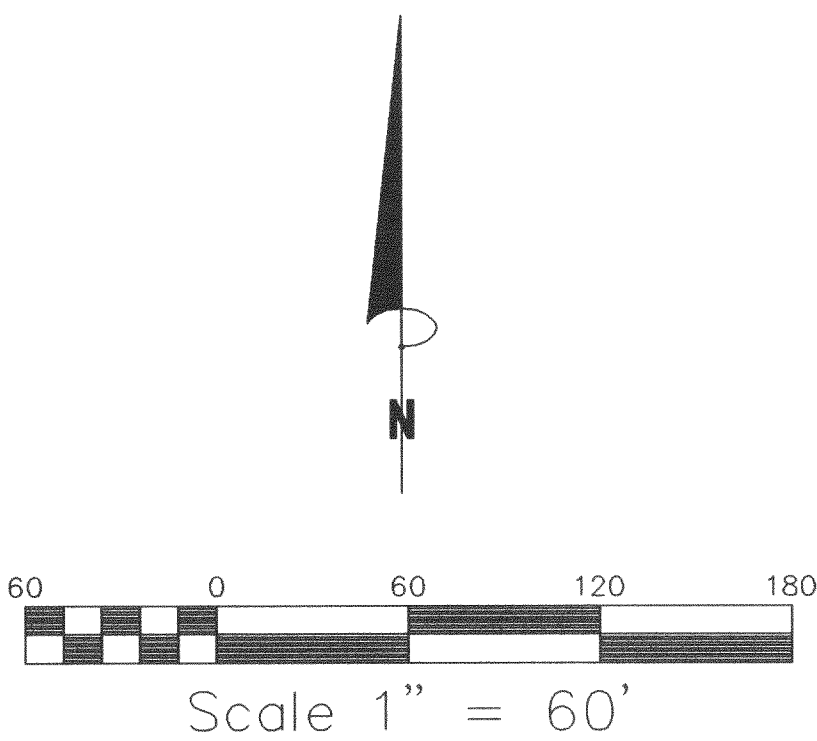


ORDERED BY:
RICHARD PETERSON
W2648 STATE RD. 20
EAST TROY, WI
53120

J.K. SURVEYING, INC
N3705 WILLOW BEND LANE, LAKE GENEVA, WI 53147
(262) 248-3697

THE ABOVE MAP IS A TRUE REPRESENTATION THEREOF AND
SHOWS THE SIZE AND LOCATION OF ALL THE PROPERTY,
EXTERIOR BOUNDARIES, THE LOCATION OF ALL VISIBLE
BOUNDARY FENCES, APPARENT EASEMENTS, ROADWAYS
AND VISIBLE ENCROACHMENTS, IF ANY.

THIS SURVEY IS MADE FOR THE USE OF THE PRESENT
OWNERS OF THE PROPERTY, AND ALSO THOSE WHO
PURCHASE, MORTGAGE OR GUARANTEE TITLE THERETO
WITHIN ONE (1) YEAR FROM DATE HERETO.

John P. Krott
JOHN P. KROTT, R.L.S. 2258

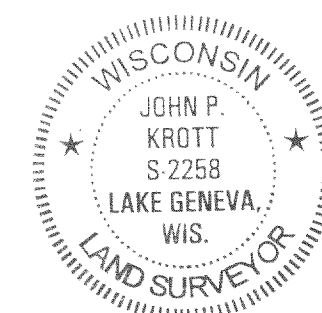

DATE OF LAST REVISION : 12 / 01 / 2003

REVISED: 11 / 03 / 2003

DATE: 6 / 23 / 1999

JOB NUMBER: 99063- 4-17- LA30080001