

PLAT OF SURVEY

BEING A PART OF THE
NORTHWEST 1/4, SOUTHWEST 1/4 SOUTHEAST 1/4
AND NORTHWEST 1/4 OF THE NORTHWEST 1/4 OF
SECTION 16, TOWN 4 NORTH, RANGE 17 EAST,
COUNTY OF MILWAUKEE, WISCONSIN.

WAS FILED FROM PELINSKI BROS. BUILDERS/DAN AND LAURA KOP.
THEir MAP SHOULD BE DETERMINED BY OWNER OR OTHER.




RADIUS	LENGTH	CHORD	BEARING	DELTA
811.21	171.38	171.06	S24°22'19.5"W	12°06'17"

I hereby certify that I have surveyed the above property and that the above map is a true representation thereof and shows the size and location of the property, exterior boundaries, the location of all visible structures and dimensions of all principal buildings thereon, boundary lines, apparent easements, roadways and encroachments, if any.

This survey is made for the use of the present owners of the property, and also those who purchase, mortgage or guarantee the title thereto within one year from date hereof.

Kettle Moraine Surveying Inc.
P.O. Box 357
Eagle WI. 53119
(262)594-3484

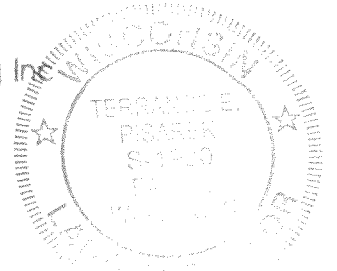

THIS IS NOT AN ORIGINAL SURVEY

2/24/04
DATE

TEP/DW
FIELD WORK BY

TEP
DRAWN BY

C4026
JOB NO.

LOR 00003

417-729