

PLAT OF SURVEY




March 8, 2005

LOCATION: _____ S.T.H. "67", Troy, Wisconsin


Survey No. 040633R
Kaerek Homes - 6593
Jason and Jessica Lippold

LEGAL DESCRIPTION:

Lot 1 of **CERTIFIED SURVEY MAP NO. _____**, Being a redivision of Lot 1, Certified Survey Map No. 3679, being a part of the Southwest 1/4, and the Northwest 1/4 all in the Northwest 1/4 of Section 6, Town 4 North, Range 17 East, in the Town of Troy, Walworth County, Wisconsin.

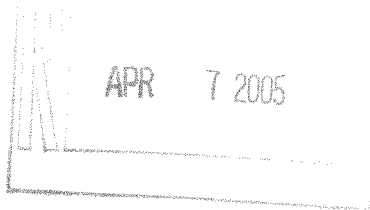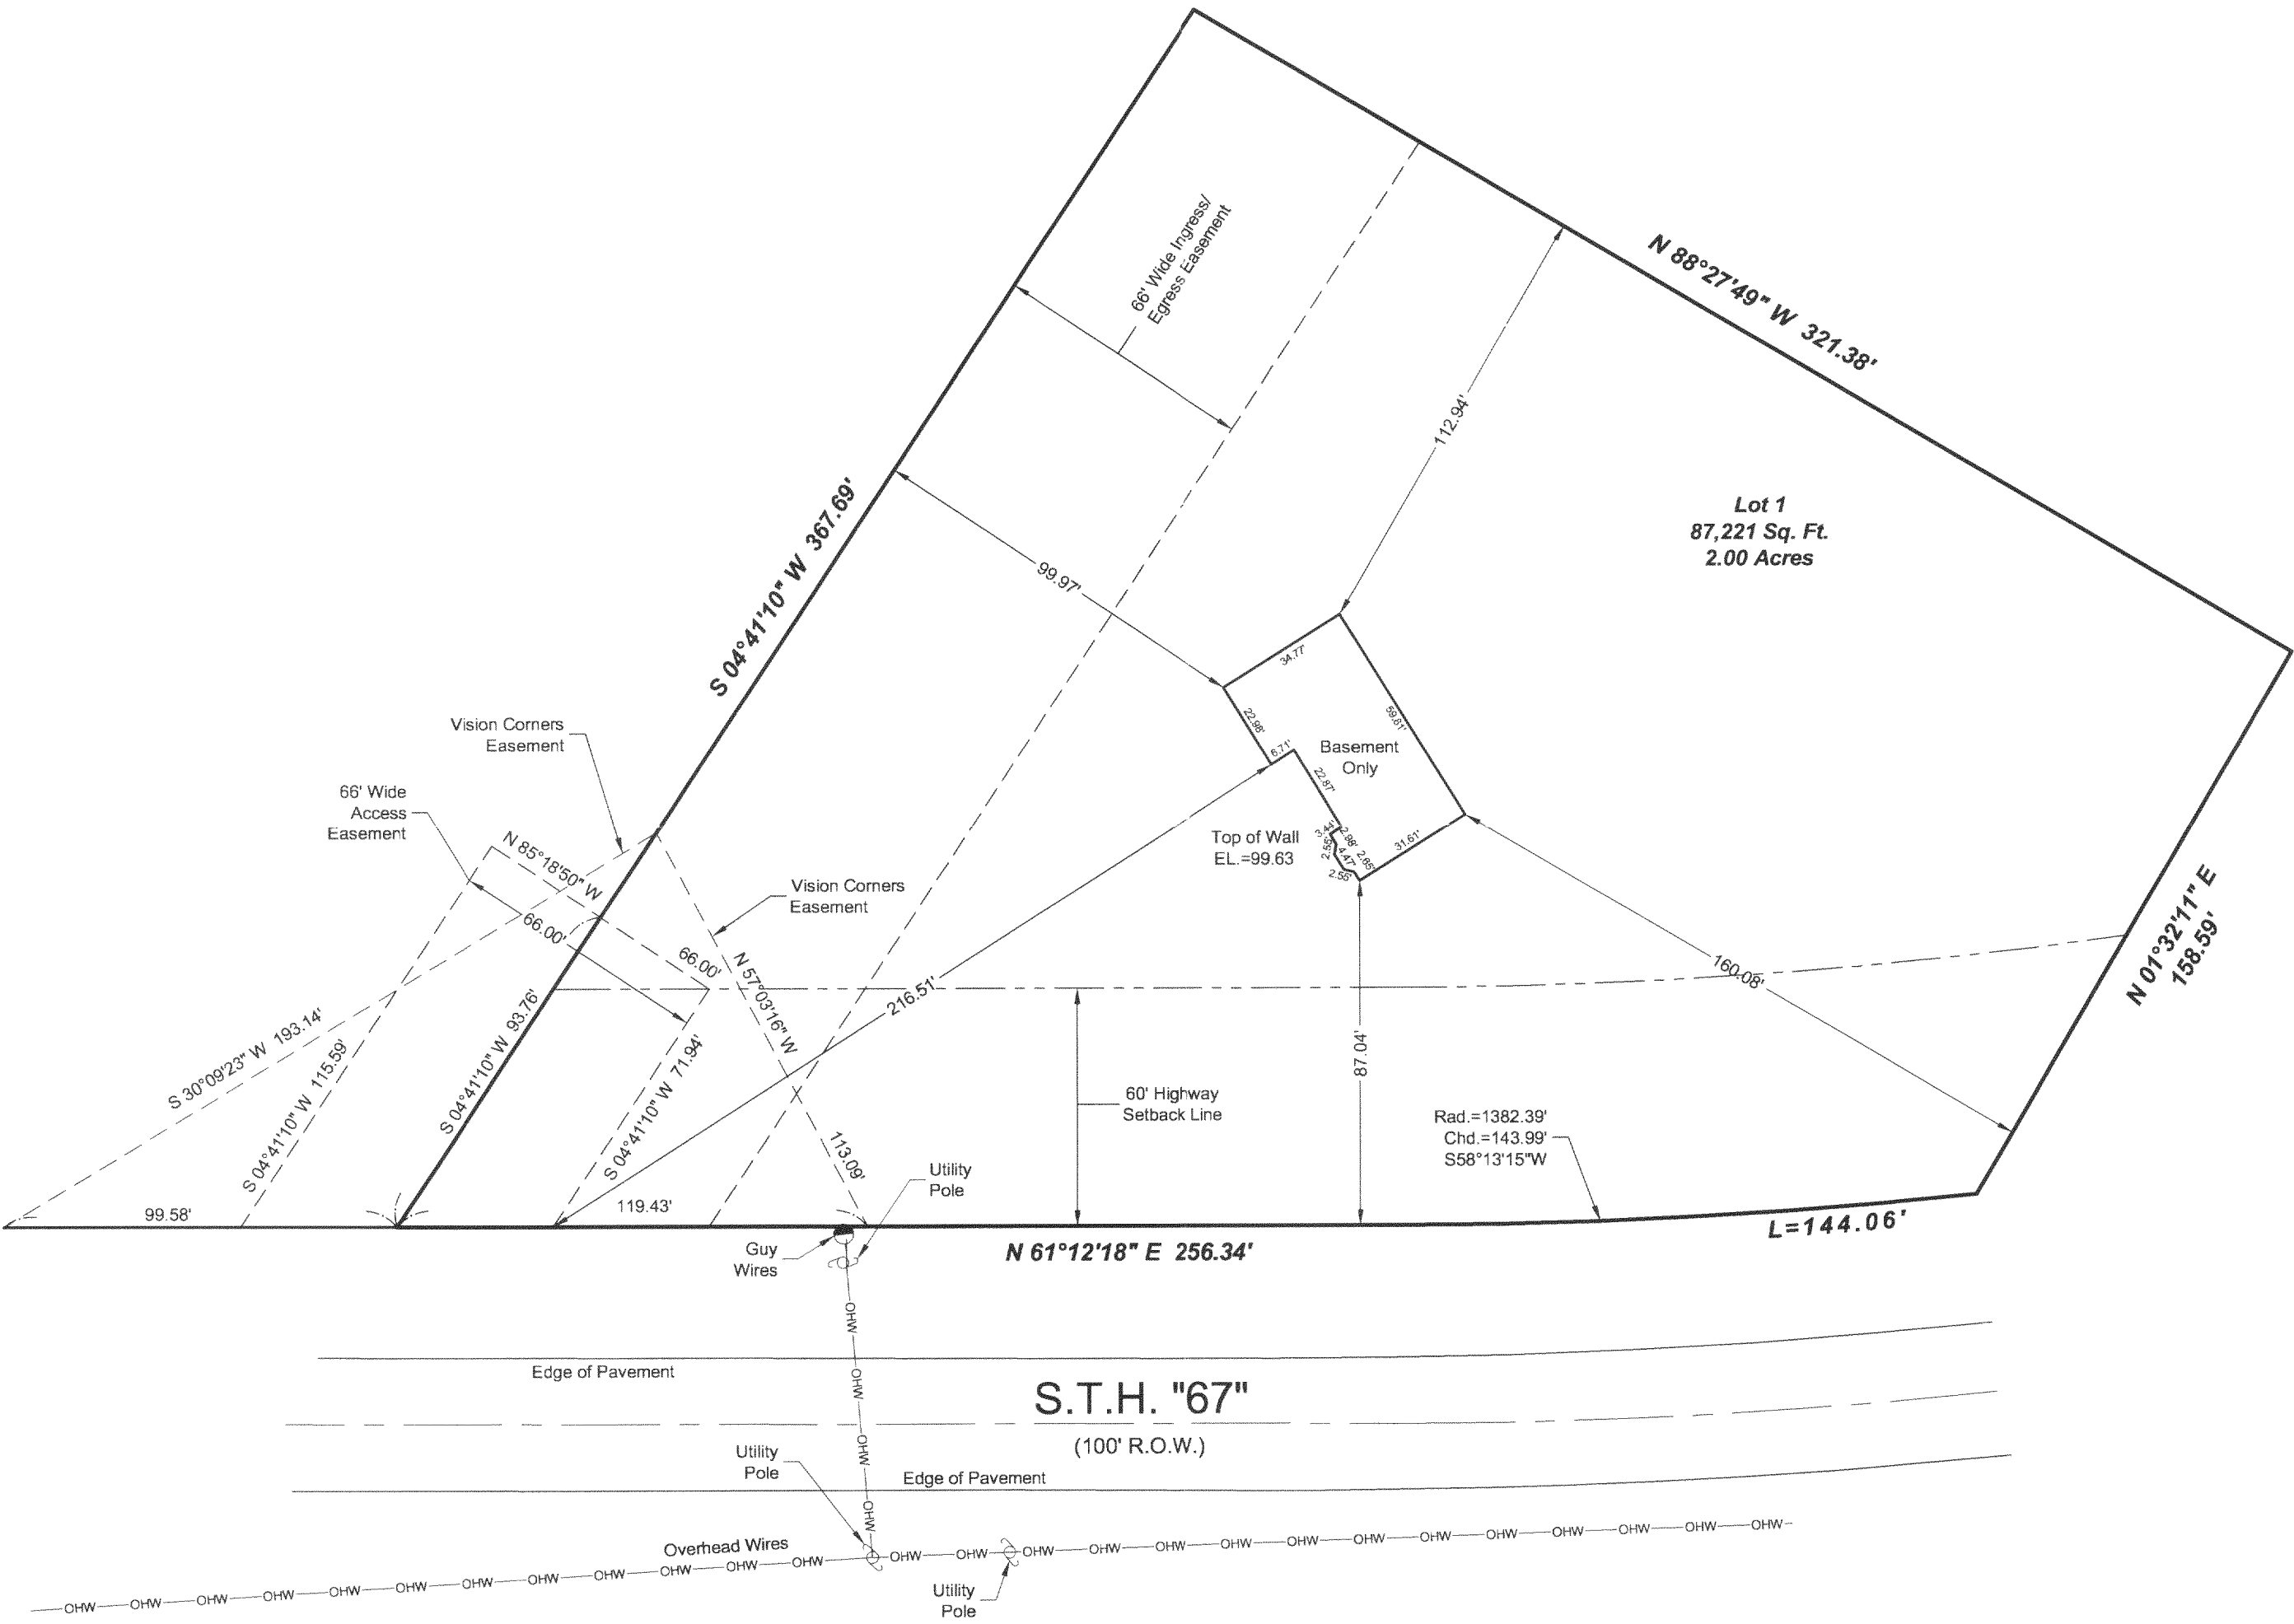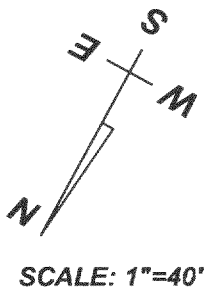

Mortgage Inspection
Monumentation has been waived in accordance with A-5 5.01 (b) of the Wisconsin Administrative Code.

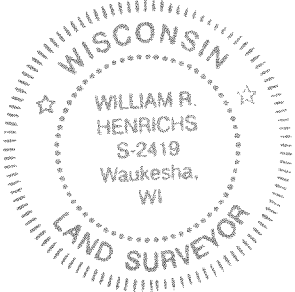

DRAWING BY: AW
FIELD WORK BY: RT

LANDCRAFT SURVEY AND ENGINEERING, INC.
REGISTERED LAND SURVEYORS AND CIVIL ENGINEERS
2077 South 116th Street, West Allis, WI 53227
PH. (414) 604-0674 FAX (414) 604-0677
INFO@LANDCRAFTSE.COM

I HEREBY CERTIFY THAT I HAVE SURVEYED THE ABOVE DESCRIBED PROPERTY AND THAT THE ABOVE MAP IS A TRUE REPRESENTATION THEREOF AND SHOWS THE SIZE AND LOCATION OF THE PROPERTY. ITS EXTERIOR BOUNDARIES, THE LOCATION OF ALL VISIBLE STRUCTURES AND DIMENSIONS OF ALL PRINCIPAL BUILDINGS THEREON, BOUNDARY FENCES, APPARENT EASEMENTS AND ROADWAYS AND VISIBLE ENCROACHMENT, IF ANY.

THIS SURVEY IS MADE FOR THE EXCLUSIVE USE OF THE PRESENT OWNERS OF THE PROPERTY, AND ALSO THOSE WHO PURCHASE, MORTGAGE, OR GUARANTEE THE TITLE THERETO WITHIN ONE (1) YEAR FROM THE DATE HEREOF.

SIGNED 
William R. Henrichs, Registered Land Surveyor S-2419