


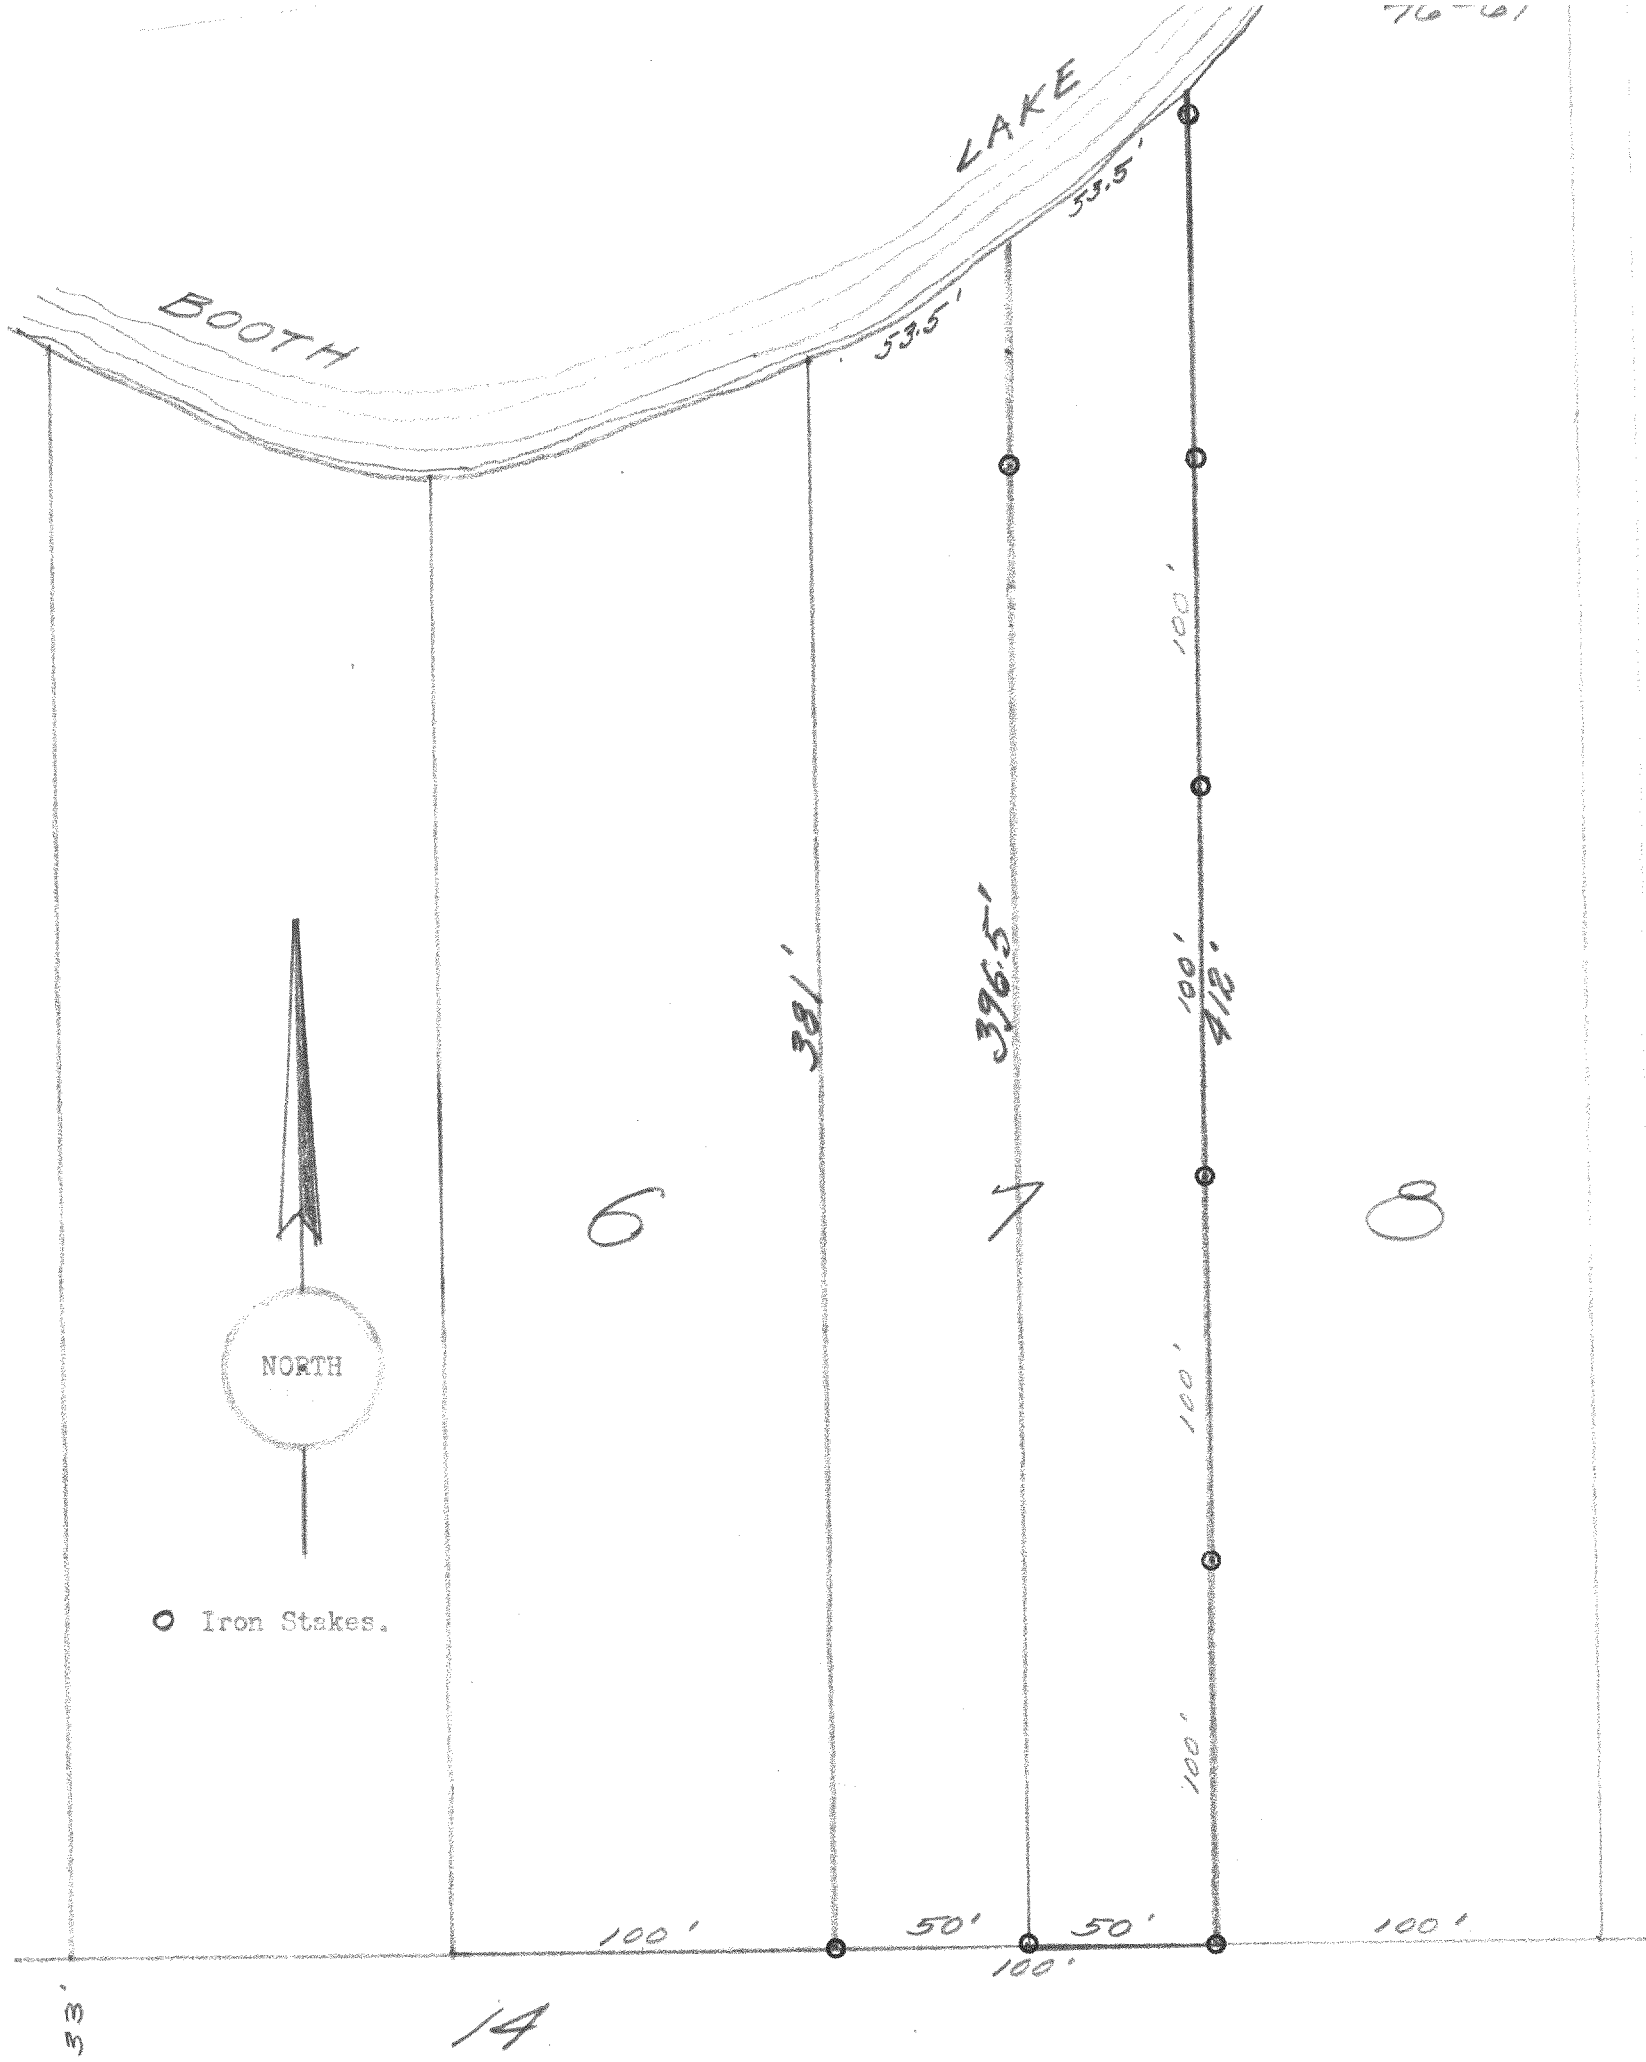

DESCRIPTION:

East 50 feet of Lot 7, in Hultquist Subdivision, Town of Troy, Walworth County, Wisconsin.

CERTIFICATE:

I, hereby certify that I have on this the 30th day of April 1946, surveyed the above described property according to the official records on file in the office of the Recorder of Deeds in and for Walworth County, Wisconsin, and find that the measurements and the bearings of the boundary lines of said property as taken on this day, substantially agree with those in the above description and that no encroachments exist.

SIGNED AND SEALED THIS 3RD DAY OF MAY 1946.

Joseph M. Biagi
Joseph M. Biagi, Professional Engineer.
Elkhorn Wisconsin.