

Plat of Survey

LOT 5, OF BLOCK 11 OF TROY CENTER according to the plat said Village now on file in the office of the Register of Deeds for said Walworth County, LOT 4 OF BLOCK 11 OF TROY CENTER according to the plat of said Village now on file in the office of the Register of Deeds for said Walworth County, EXCEPTING From said Lot 4, Block 11 that part thereof included in Warranty Deed from Wilder I. Hopkins and Emma G. Hopkins to August F. Ahrendt and Anna Ahrendt recorded in Vol. 443 of Deeds on Page 495 #444317


Surveyed for: Sharon Simonis

Survey address: N8715 County Road N



MONUMENTATION WAS WAIVED BY CLIENT
IN ACCORDANCE WITH A-E701(2) OF
THE WISCONSIN ADMINISTRATIVE CODE.

SCALE 1-30'

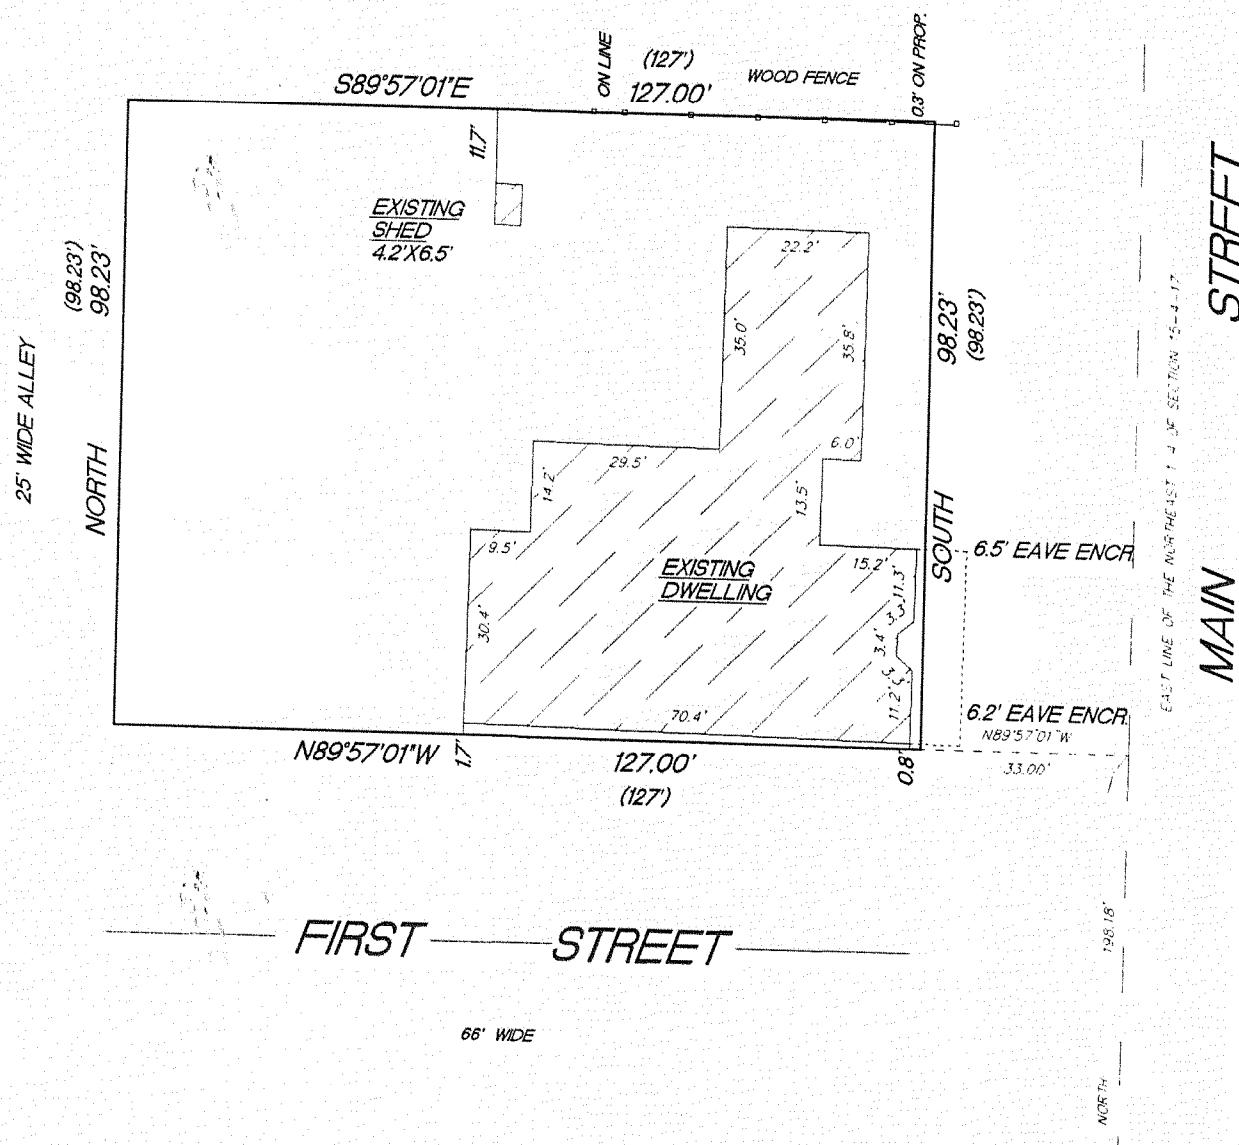

"I hereby certify that I have surveyed the above described property and that the above map is a true representation thereof and shows the size and location of the property, its exterior boundaries, the location of all visible structures and dimension of all principal buildings thereon, boundary fences, apparent easements, roadways and encroachments if any."

"This survey is made for the use of the present owners of the property, and also those who purchase, mortgage or guarantee the title thereto within one year from date hereof."

4/30/07

TEP

DATE


FIELD WORK BY

DRAWN BY

07062

JOB NUMBER

THIS IS NOT AN ORIGINAL SURVEY UNLESS THE SEAL IS RED.

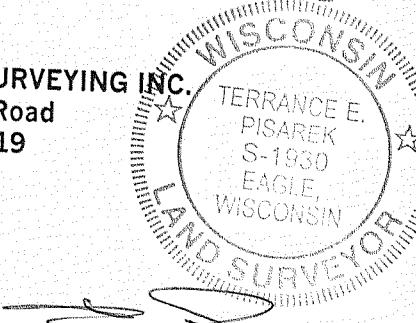

LTC-25

47.8118