


NOTE:
The 100 year flood elevation for Booth Lake has not been determined by either Walworth County Park and Planning or FEMA Maps.

BOOTH

Existing Lake Water
Surface Elevation: 816.15
Nov. 6th, 2007

L A K E

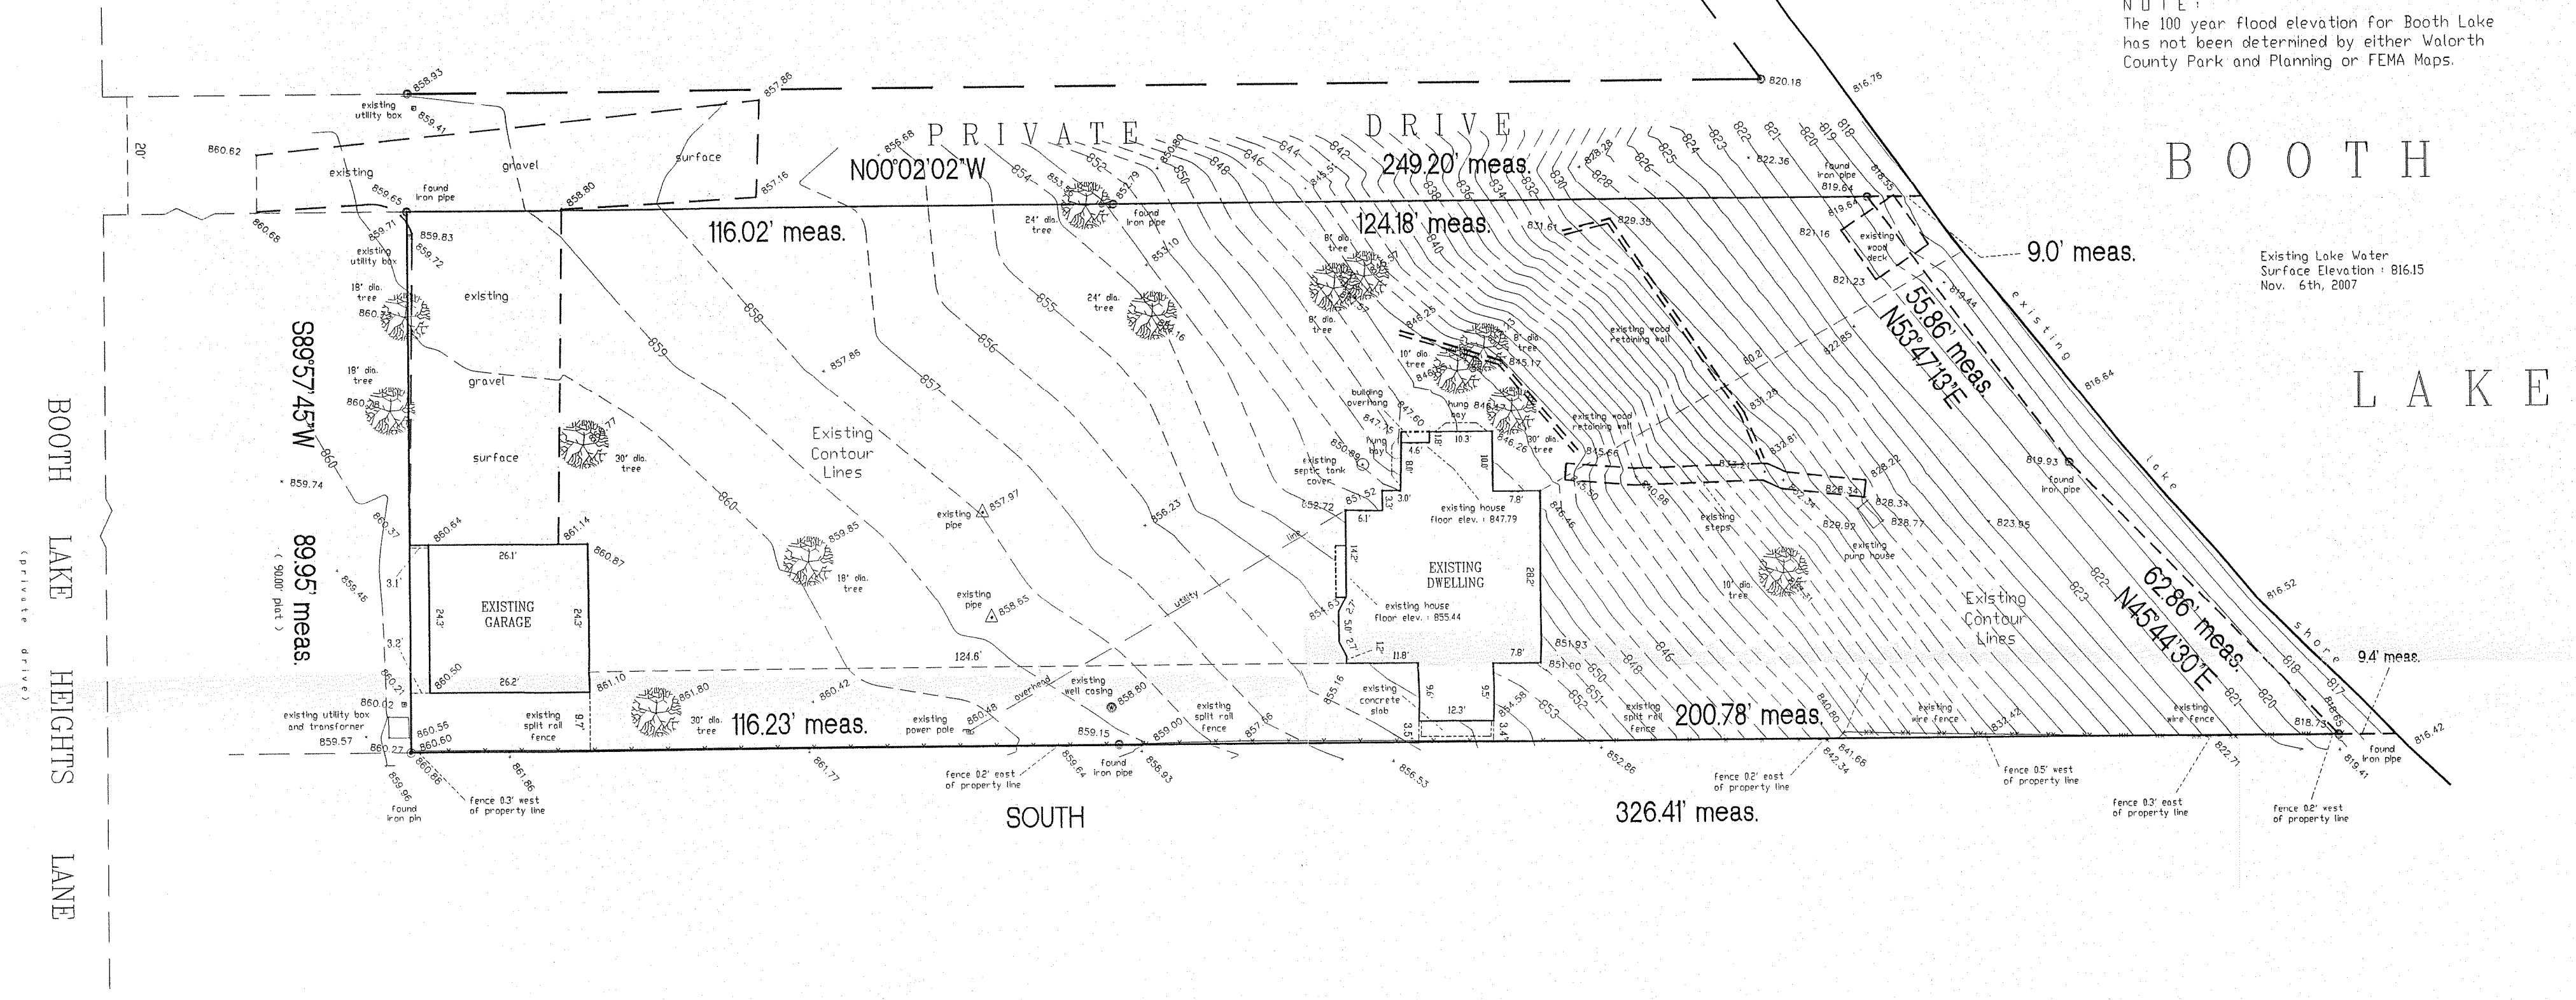

PLAT OF SURVEY


LOTS 1, 2, 5, 6 AND THE NORTH 15 FEET OF LOT 9, IN FENLON'S SUBDIVISION, located in the Northeast 1/4 of Section 24, Town 4 North, Range 17 East, in the Town of Troy, Walworth County, Wisconsin.

Address: W2538 Booth Lake Heights Lane

TOWN LINE ROAD


Benchmark for elevations
Found monument at the
Northeast corner of the
Northeast 1/4 of
Section 24-4-17
Elev.: 816.99 U.S.G.S. Datum

TOWN LINE RD.

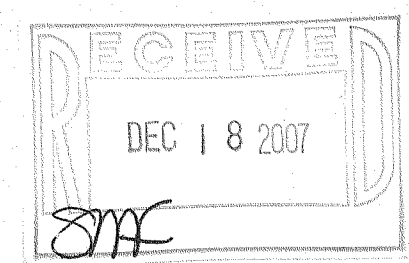


Area of Property = 25,700.9 Sq. Ft.
0.59 Acre

* 855.23 - Denotes Existing Spot Elevation

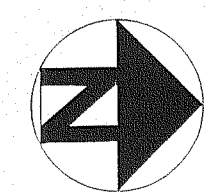

GRAPHIC SCALE

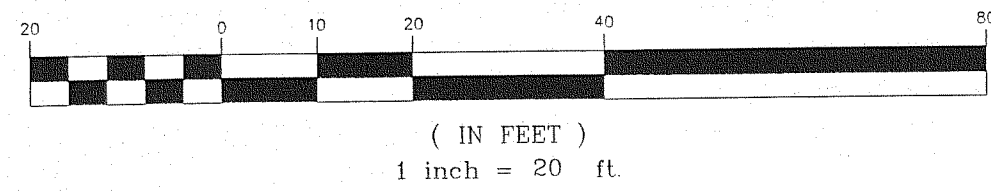

 SURVEYING ASSOCIATES, INC. MEMBER: NATIONAL SOCIETY OF LAND SURVEYORS AND AMERICAN SOCIETY OF SURVEYING AND MAPPING 2554 North 100th Street, Wauwatosa, WI Tel. (414) 257-2212 Fax (414) 257-2443	"I have surveyed the above described property and the above is a true representation thereof and shows the size and location of the property, its exterior boundaries, the location and dimensions of all structures thereon, fences, apparent easements and roadways and visible encroachments, if any." "This survey is made for the exclusive use of the present owners of the property, and also those who purchase, mortgage, or guarantee the title thereto within one (1) year from date hereof and as to their heirs and assigns." VISCONSIN REGISTERED LAND SURVEYOR	Scale: 1" = 20'	Date: 11-14-07	Revised:
		Project Number: 32265	Field Work: GB BJK	Drafted By: BJK
Project Completed For: JACK FELSKE				

LHF-1 LHF-1B

417-852