
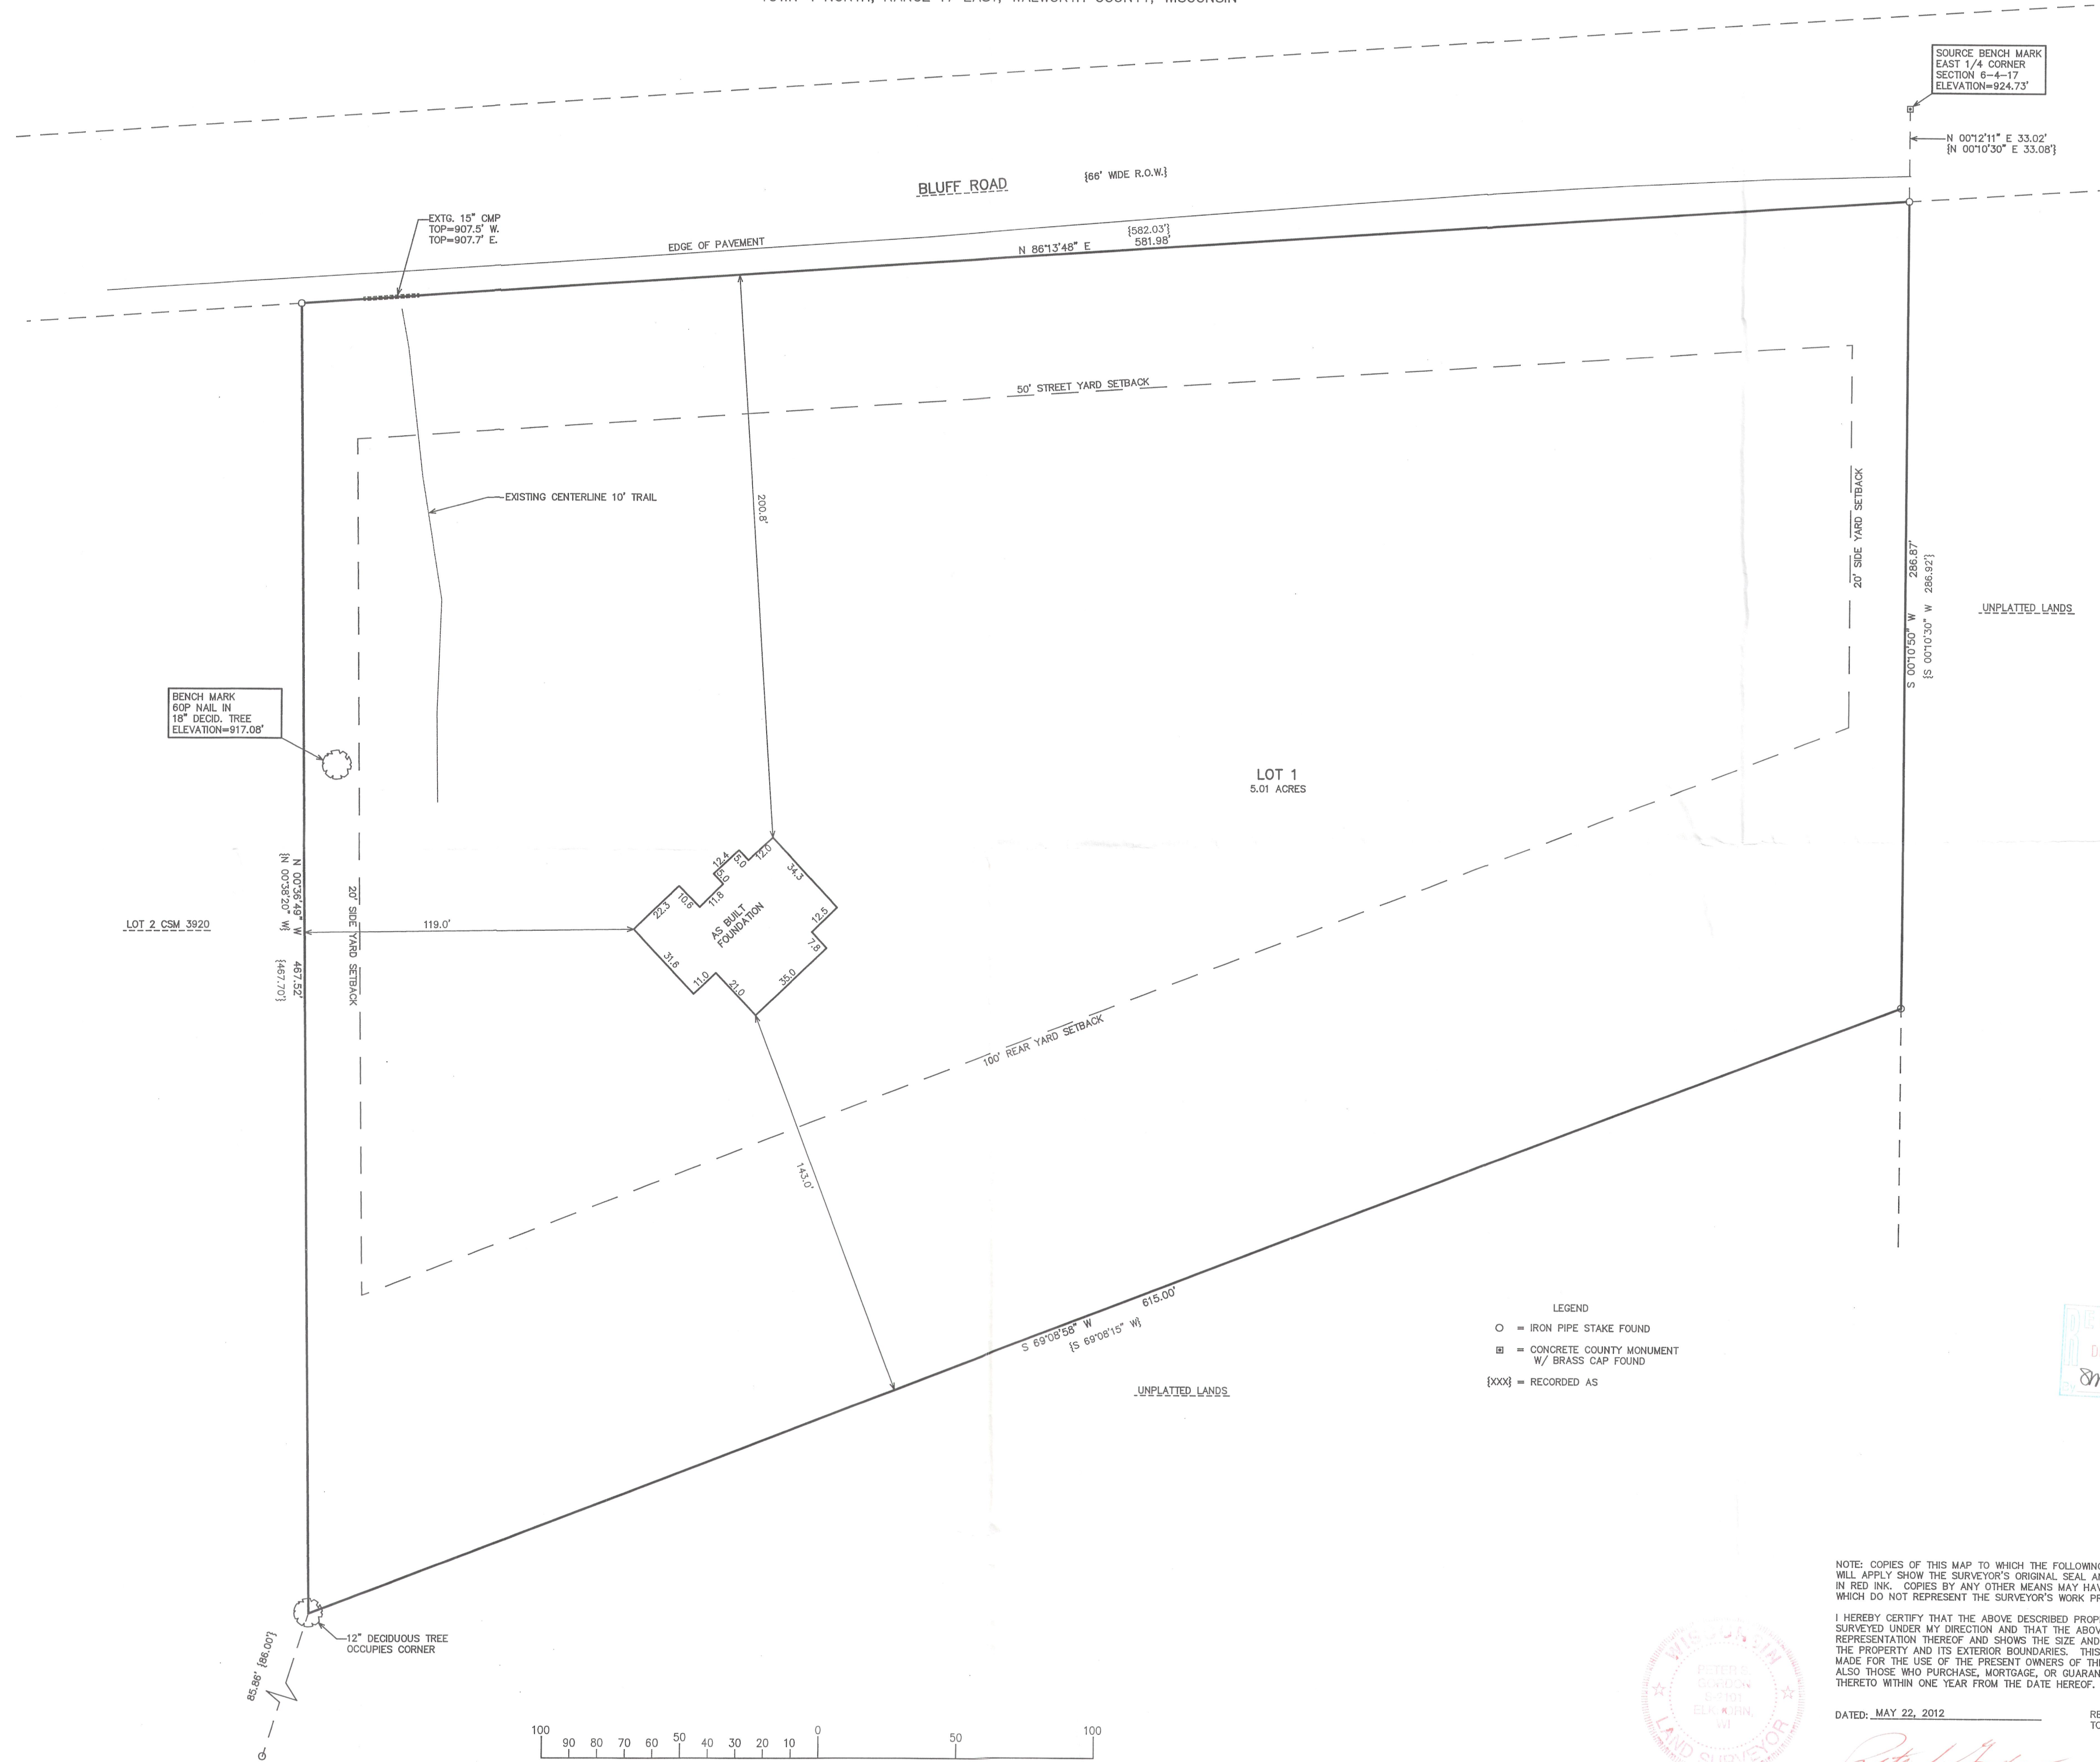


PLAT OF SURVEY
LOT 1 OF CERTIFIED SURVEY MAP NO. 3920
LOCATED IN PART OF THE SOUTHEAST 1/4 OF SECTION 6,
TOWN 4 NORTH, RANGE 17 EAST, WALWORTH COUNTY, WISCONSIN

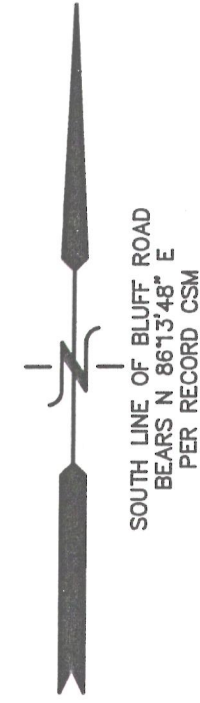

LEGEND
○ = IRON PIPE STAKE FOUND
■ = CONCRETE COUNTY MONUMENT
W/ BRASS CAP FOUND
{xxx} = RECORDED AS

NOTE: COPIES OF THIS MAP TO WHICH THE FOLLOWING CERTIFICATE WILL APPLY, SHOW THE SURVEYOR'S ORIGINAL SEAL AND SIGNATURE IN RED INK. COPIES BY ANY OTHER MEANS MAY HAVE ALTERATIONS WHICH DO NOT REPRESENT THE SURVEYOR'S WORK PRODUCT.
I HEREBY CERTIFY THAT THE ABOVE DESCRIBED PROPERTY HAS BEEN SURVEYED UNDER MY DIRECTION AND THAT THE ABOVE MAP IS A TRUE REPRESENTATION THEREOF AND SHOWS THE SIZE AND LOCATION OF THE PROPERTY AND ITS EXTERIOR BOUNDARIES. THIS SURVEY IS MADE FOR THE USE OF THE PRESENT OWNERS OF THE PROPERTY, AND ALSO THOSE WHO PURCHASE, MORTGAGE, OR GUARANTEE THE TITLE THERETO WITHIN ONE YEAR FROM THE DATE HEREOF.

DATED: MAY 22, 2012
REVISED 10-18-2012
TO SHOW AS BUILT FOUNDATION

PETER S. GORDON
R.L.S. 2101



WORK ORDERED BY -
JEFF AUBERGER
PRESERVATION HOMES
1560 N. COUNTRY CLUB PARKWAY
ELKHORN, WI 53121

FARRIS, HANSEN & ASSOCIATES, INC.
ENGINEERING - ARCHITECTURE - SURVEYING
7 RIDGEWAY COURT P.O. BOX 437
ELKHORN, WISCONSIN 53121
OFFICE: (262) 723-2098 FAX: (262) 723-5886

REVISIONS

PROJECT NO.
8576
DATE
5/16/2012
SHEET NO.
1 OF 1