



AS BUILT MAPPING

LOT 2 OF CERTIFIED SURVEY MAP NO. 3584

RECORDED IN VOLUME 21 ON PAGE 130 AS DOCUMENT NO. 568652
LOCATED IN PART OF THE NW 1/4 & THE SW 1/4 OF THE NW 1/4 OF SECTION 19,
TOWN 4 NORTH, RANGE 17 EAST, TOWN OF TROY, WALWORTH COUNTY, WISCONSIN

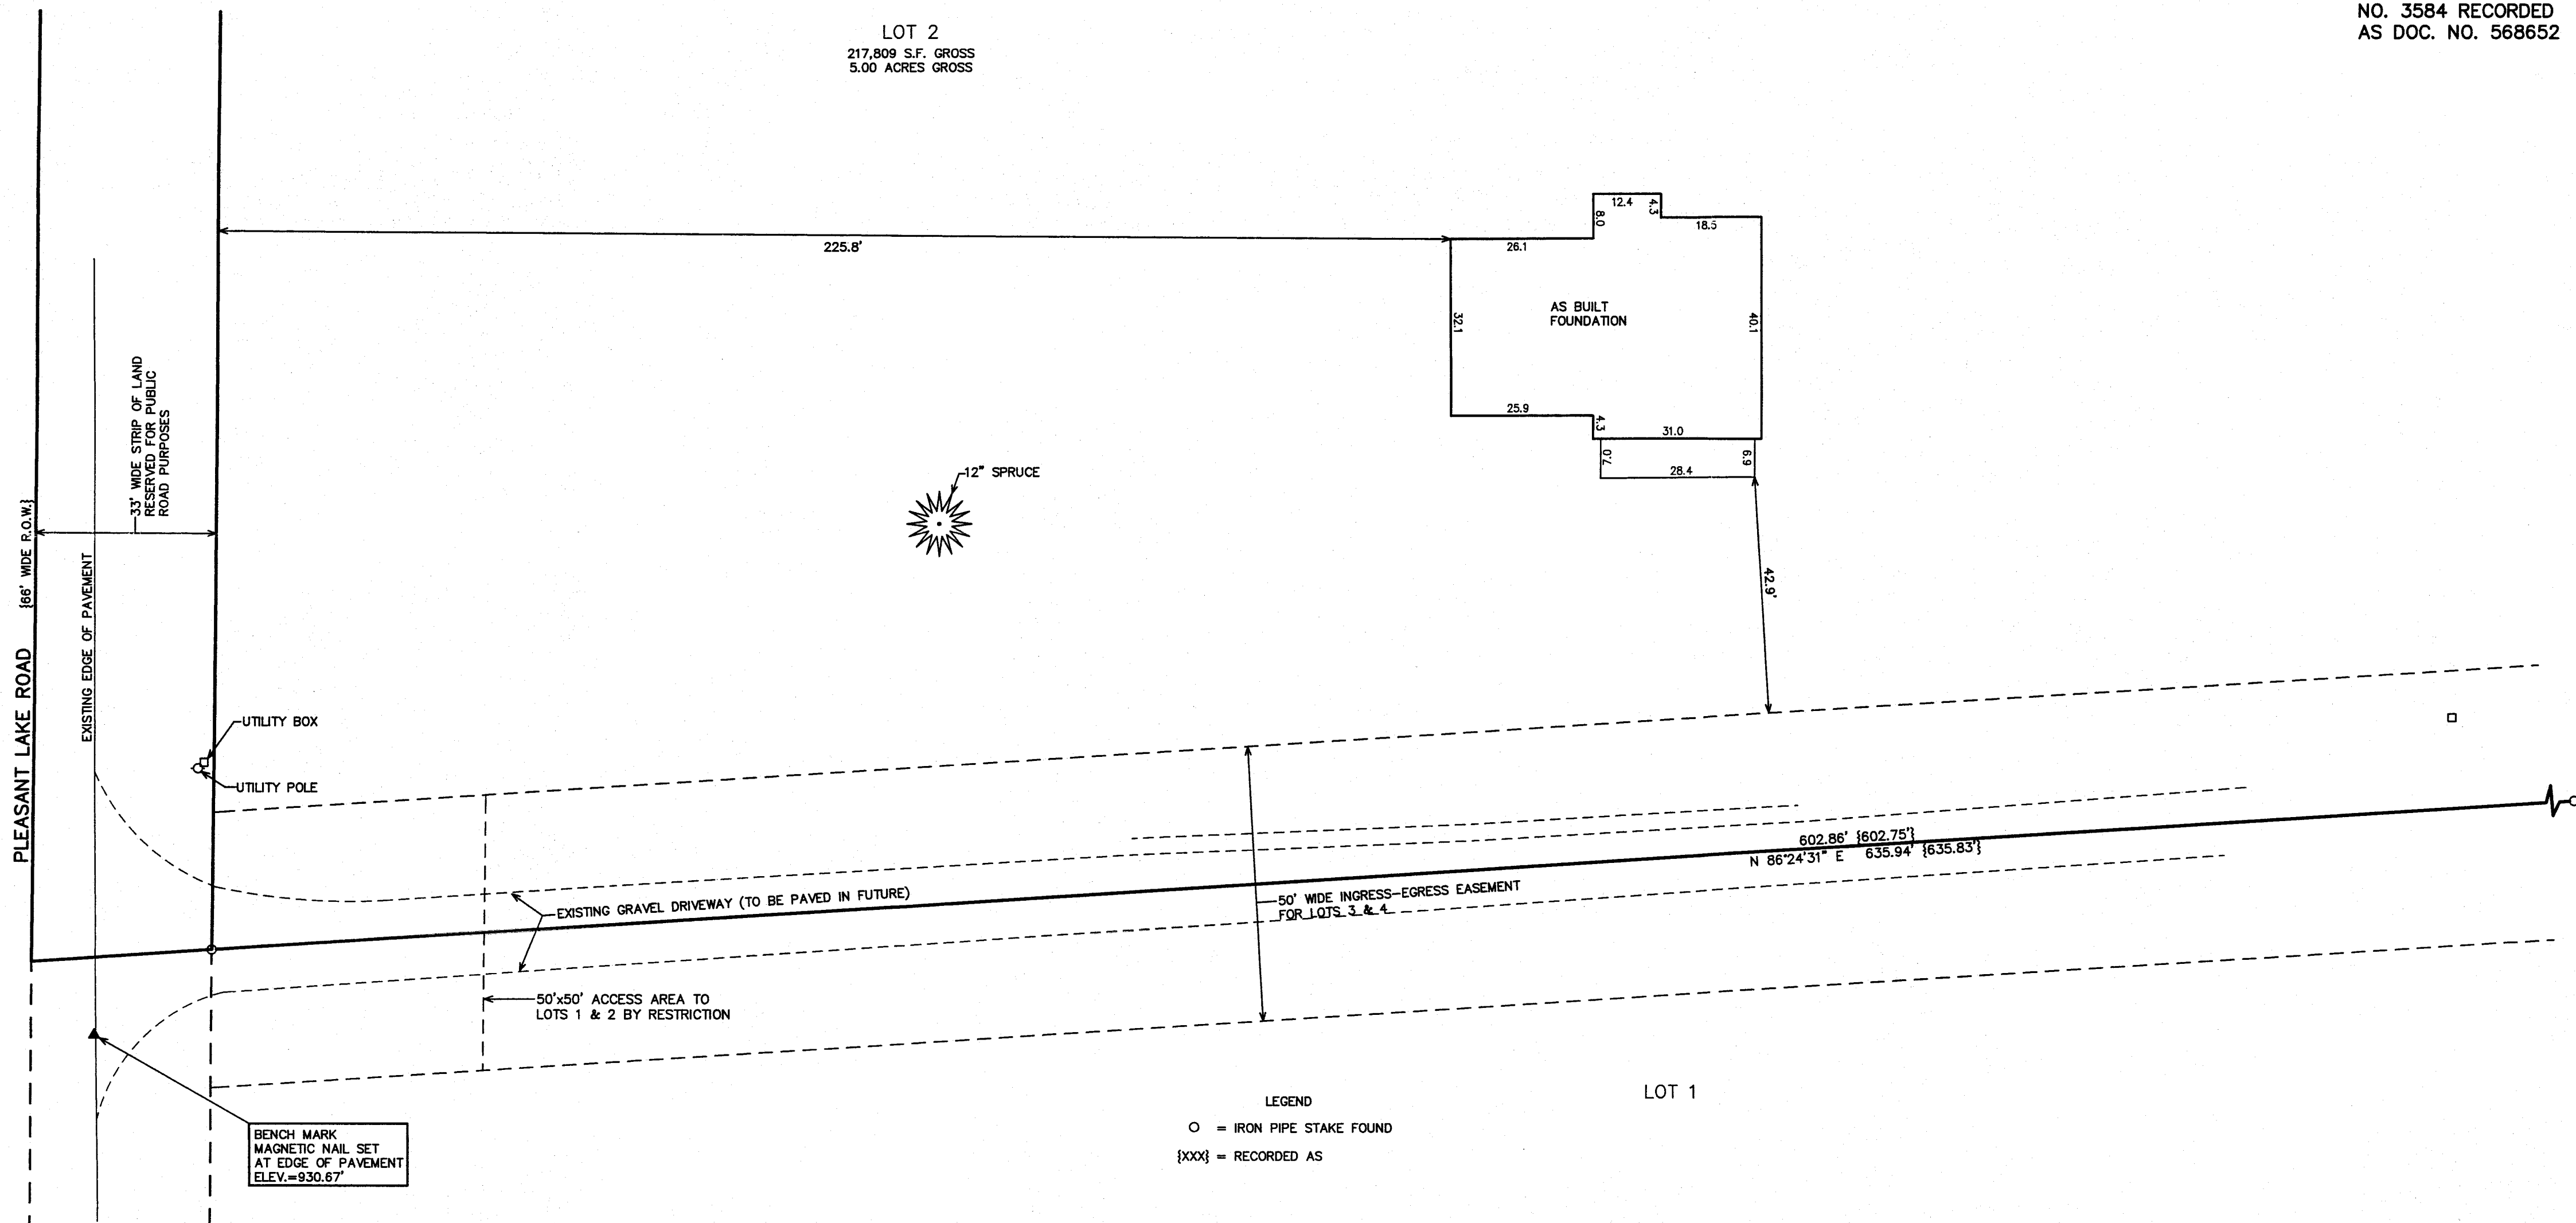

COPY OF SHEET 2 OF
CERTIFIED SURVEY MAP
NO. 3584 RECORDED
AS DOC. NO. 568652

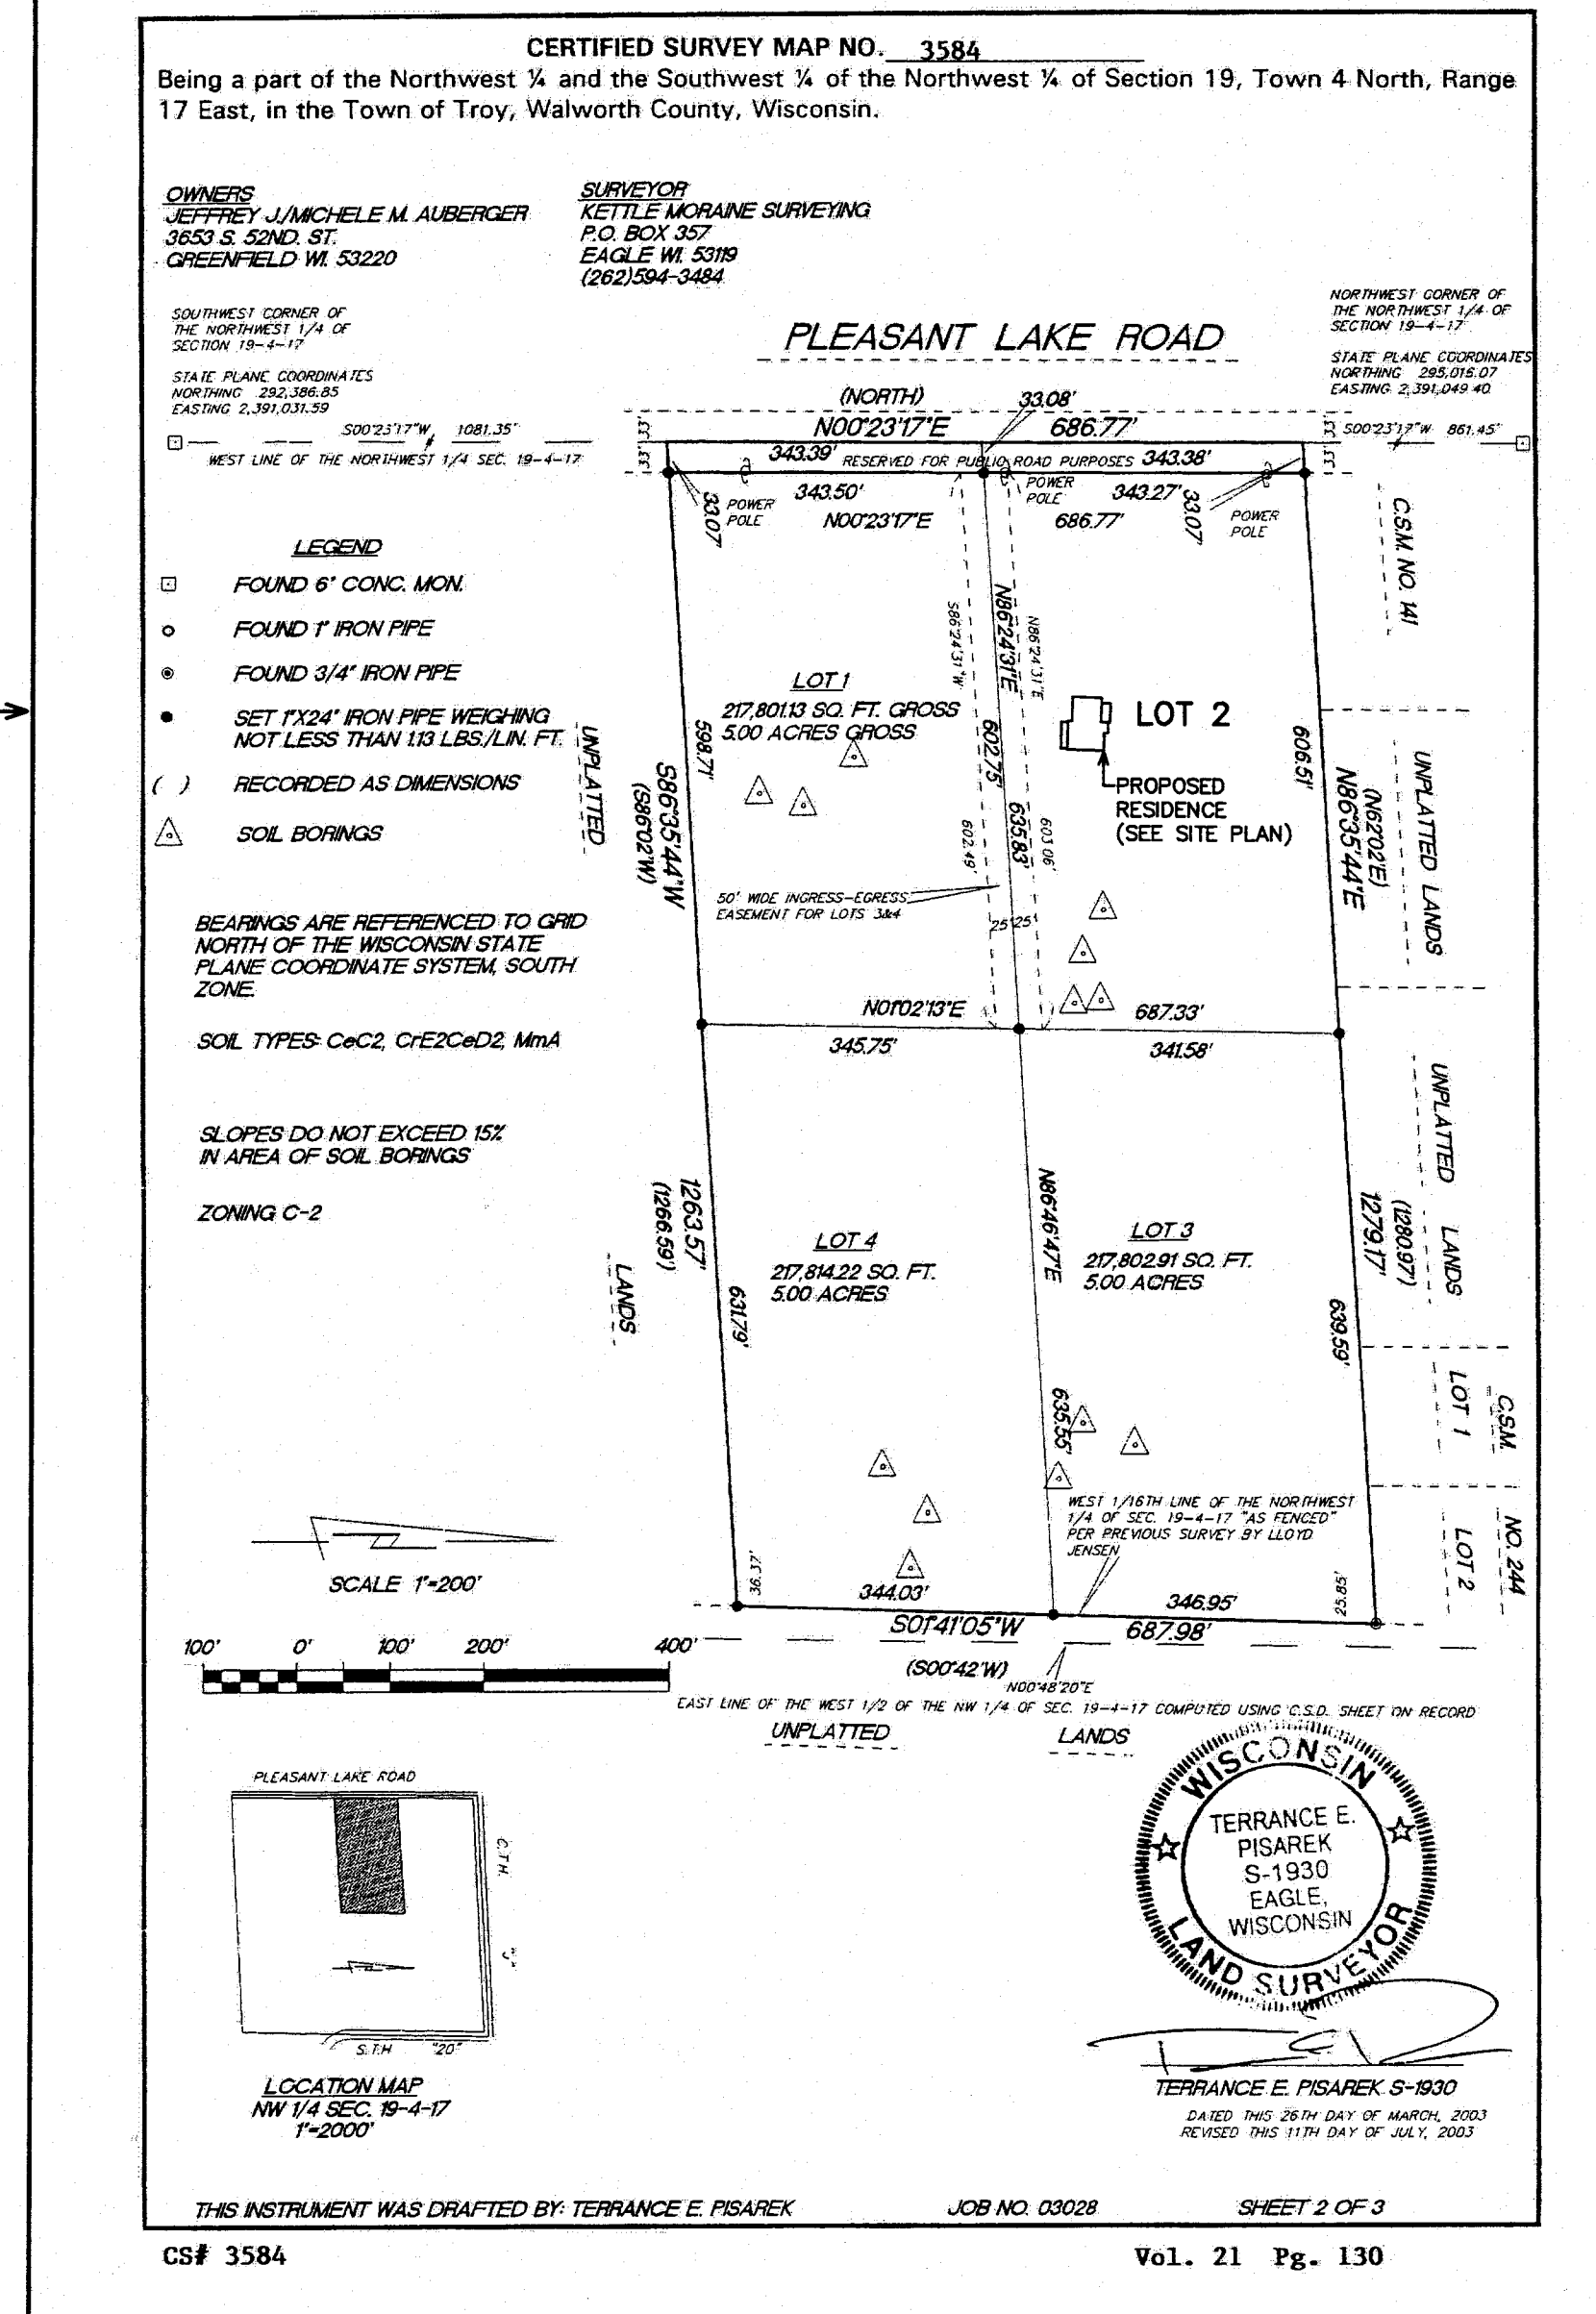





NOTE: COPIES OF THIS MAP TO WHICH THE FOLLOWING CERTIFICATE WILL APPLY SHOW THE SURVEYOR'S ORIGINAL SEAL AND SIGNATURE IN RED INK. COPIES BY ANY OTHER MEANS MAY HAVE ALTERATIONS WHICH DO NOT REPRESENT THE SURVEYOR'S WORK PRODUCT.

I HEREBY CERTIFY THAT THIS PLAT IS A TRUE AND ACCURATE REPRESENTATION OF THE LOCATION OF THE PROPOSED RESIDENCE IN RELATION TO THE NORTHWEST, AND SOUTHWEST CORNERS OF LOT 2 OF CERTIFIED SURVEY MAP NO. 3584 TO THE BEST OF MY PROFESSIONAL KNOWLEDGE AND BELIEF. NOTE: THIS IS NOT A SURVEY AS DEFINED IN CHAPTER A-6, 7 OF WISCONSIN ADMINISTRATIVE CODE.

DATED: OCTOBER 10, 2013

Peter S. Gordon
PETER S. GORDON RLS 2101

REVISED 04-03-2014
TO SHOW SIZE & LOCATION OF
AS BUILT FOUNDATION

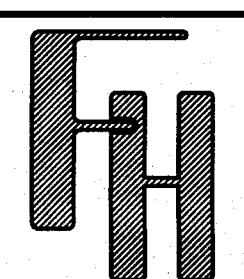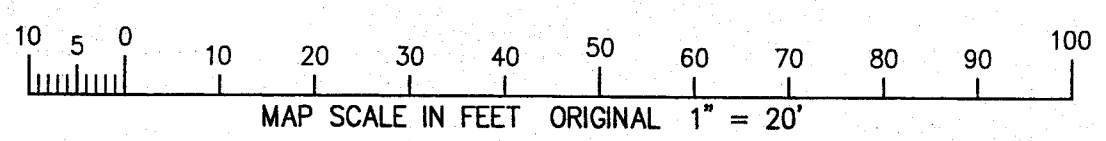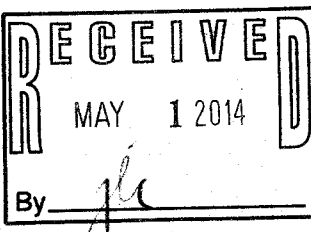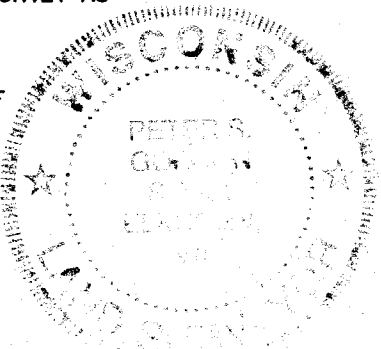

— WORK ORDERED BY —
LIAM COEN
2615 S. STERLING CIRCLE
EAST TROY, WI 53120

FARRIS, HANSEN & ASSOCIATES, INC.
ENGINEERING — ARCHITECTURE — SURVEYING
7 RIDGWAY COURT P.O. BOX 437
ELKHORN, WISCONSIN 53121
OFFICE: (262) 723-2098 FAX: (262) 723-5886

REVISIONS	

PROJECT NO.
8857.13
DATE
7/30/2013
SHEET NO.
1 OF 1

LA3584-2

417-967