

# PLAT OF SURVEY




July 18, 2000

LOCATION: \_\_\_\_\_ Beulah Meadows Road, East Troy, Wisconsin

Survey No. 000079B  
COVENTRY HOMES, LTD. - 7599  
Chris & Lori Hurst

### LEGAL DESCRIPTION:

Lot 47 in **BEULAH LAKE FARMS SUBDIVISION ADDITION # 1**, Being a redivision of Lots 22 through 33 of BEULAH LAKE FARMS, and additional lands being located in the Southwest 1/4 of the Northeast 1/4 and part of the Northwest 1/4 of the Southeast 1/4 of Section 3, Township 4 North, Range 18 East, Town of East Troy, Walworth County, Wisconsin.

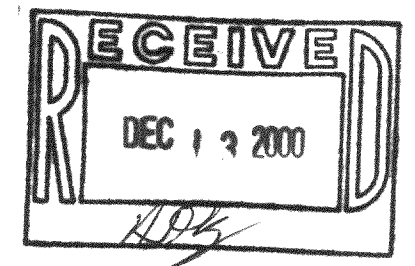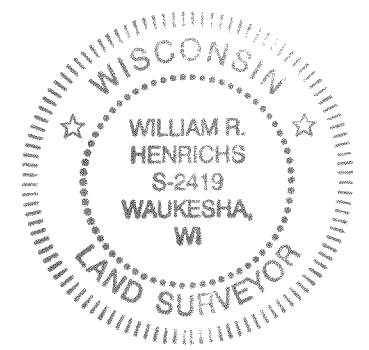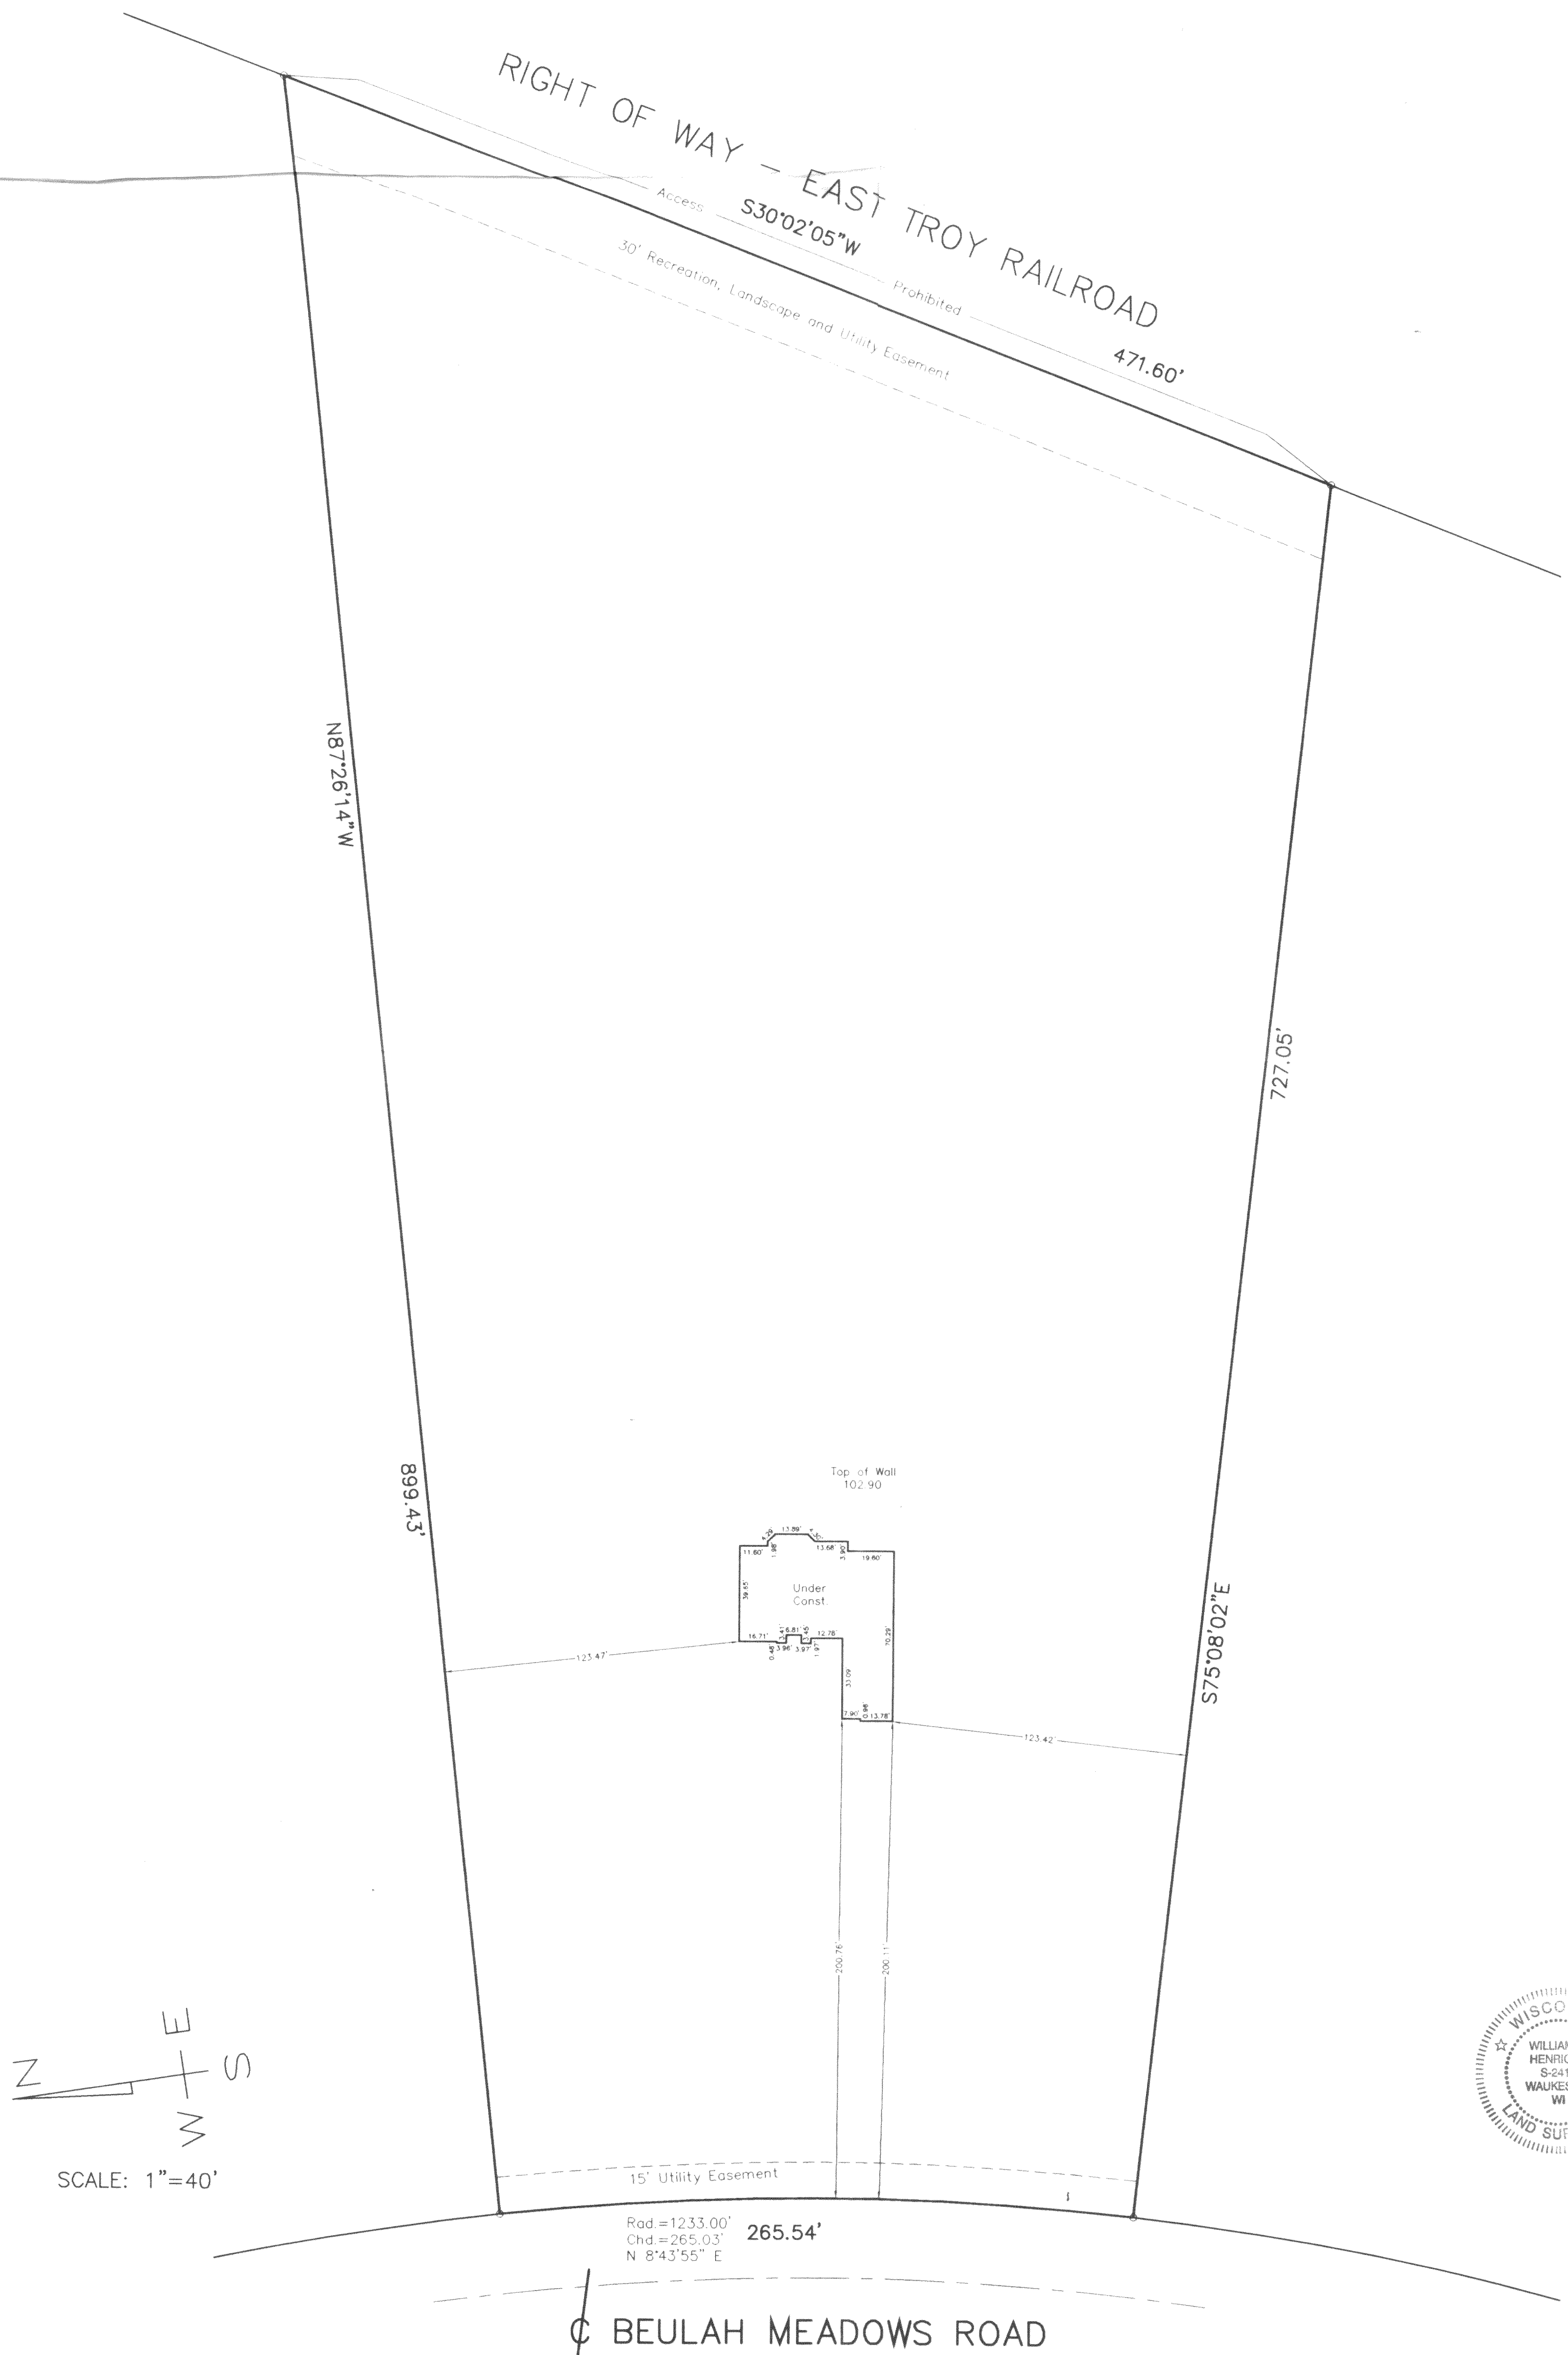

© 2000 RIGHT 1999 LANDCRAFT SURVEY AND ENGINEERING, INC. ALL RIGHTS RESERVED

LANDCRAFT SURVEY AND ENGINEERING, INC.  
 REGISTERED LAND SURVEYORS AND CIVIL ENGINEERS  
 2077 South 116th Street West Allis, WI 53227  
 PH (414) 604-0674 FAX (414) 604-0677  
 LANDCRF1@EXL.CPC.COM

Mortgage Inspection  
 Monumentation has been waived in  
 accordance with A-5.01 (b) of the  
 Wisconsin Administrative Code.

I HEREBY CERTIFY THAT I HAVE SURVEYED THE ABOVE DESCRIBED PROPERTY AND THAT THE ABOVE MAP IS A TRUE REPRESENTATION THEREOF AND SHOWS THE SIZE AND LOCATION OF THE PROPERTY, ITS EXTERIOR BOUNDARIES, THE LOCATION OF ALL VISIBLE STRUCTURES AND DIMENSIONS OF ALL PRINCIPAL BUILDINGS THEREON, BOUNDARY EASEMENTS, APPURTENANCES AND ROADWAYS AND VISIBLE ENCROACHMENT, IF ANY.  
 THIS SURVEY IS MADE FOR THE EXCLUSIVE USE OF THE PRESENT OWNERS OF THE PROPERTY AND ALSO THOSE WHO PURCHASE FROM SAID OWNER OR GUARANTEE THE TITLE THEREIN WITHIN ONE (1) YEAR FROM THE DATE HEREOF.  
 SIGNED: *William R. Henrichs*  
 William R. Henrichs, Registered Land Surveyor S-2419