

# PLAT OF SURVEY



Engineers • Land Surveyors • Environmental Scientists  
801 MAIN STREET MUKWONAGO, WISCONSIN 53149 (262)363-2004

FOR: JOHN & CHRISTI CLANCY

DATE: 1/14/02

DESCRIPTION: THE NORTH 1/2 OF LOT 8, THE SUBDIVISION OF LOT 10 OF BEULAH LAKE PARK, BEING IN SECTION 4, TOWN 4 NORTH, RANGE 18 EAST, TOWN OF EAST TROY, WALWORTH COUNTY, WISCONSIN.



## LEGEND

●	SET 1" IRON PIPE
— x —	FENCE
SVO	SEPTIC VENT
▨	CONCRETE WALK
////	EDGE OF PAVEMENT
P/L	PROPERTY LINE

SET SPIKE IN  
30" STUMP 4' +/-  
ABOVE GROUND



SCALE 1" = 40'

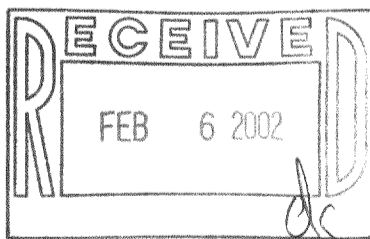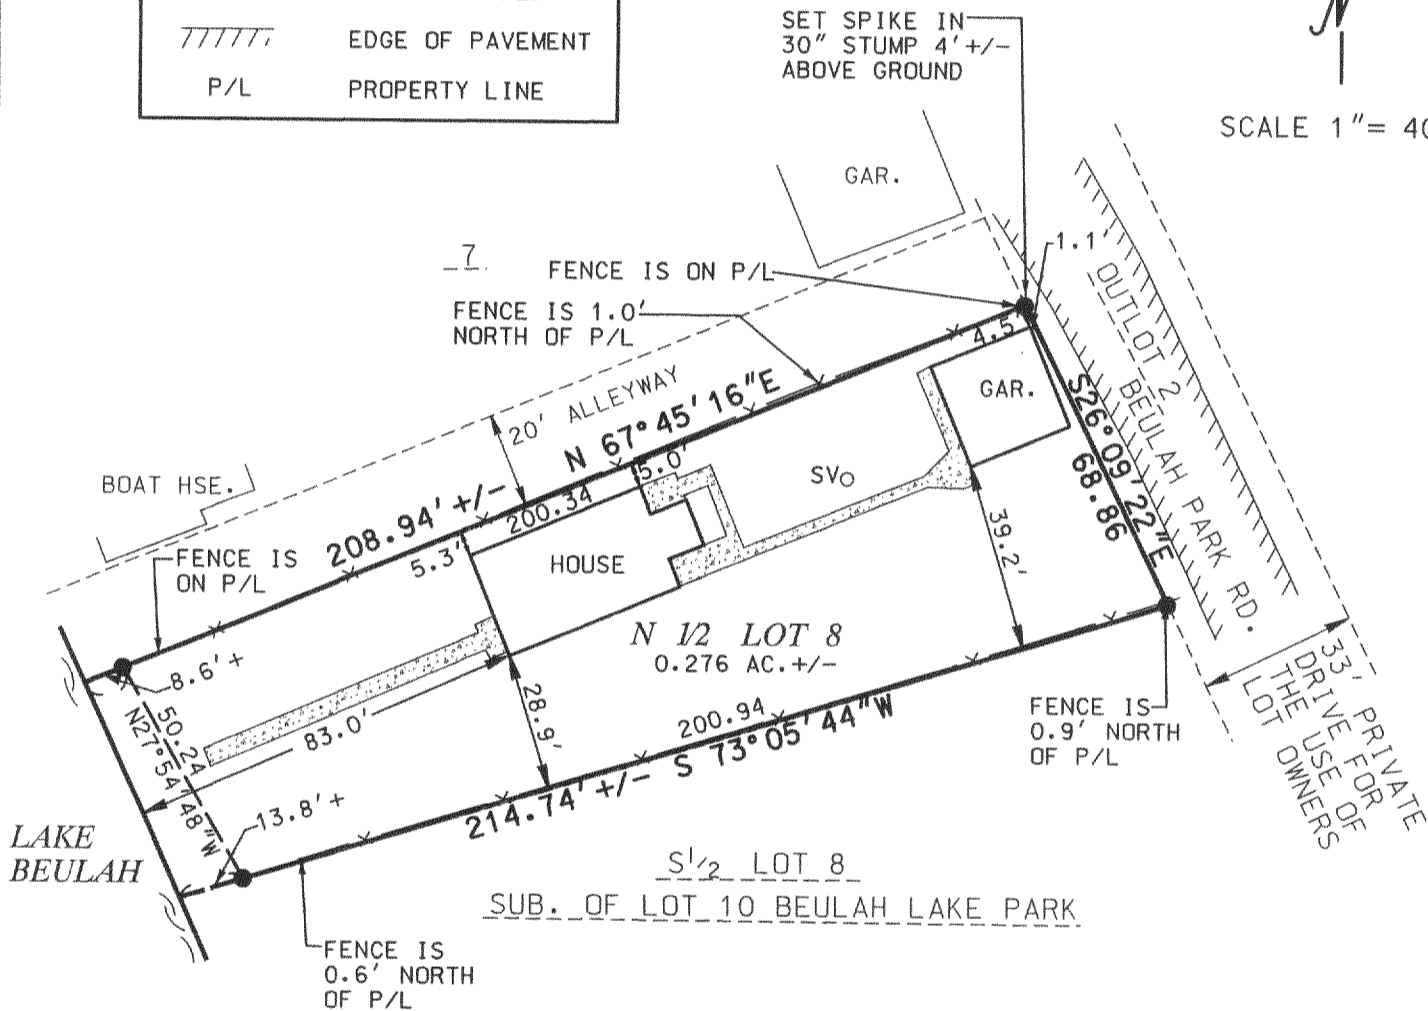


THE ABOVE MAP IS A TRUE REPRESENTATION THEREOF AND SHOWS THE SIZE AND LOCATION OF ALL THE PROPERTY, EXTERIOR BOUNDARIES, THE LOCATION OF ALL VISIBLE BOUNDARY FENCES, APPARENT EASEMENTS, ROADWAYS AND VISIBLE ENCROACHMENTS, IF ANY.

THIS SURVEY IS MADE FOR THE USE OF THE PRESENT OWNERS OF THE PROPERTY, AND ALSO THOSE WHO PURCHASE, MORTGAGE OR GUARANTEE TITLE THERETO WITHIN ONE (1) YEAR FROM DATE HERETO.

BRADFORD L. SPENCER, R.L.S. 2069  
RSV#02002

THIS IS ORIGINAL  
PRINT ONLY IF  
SEAL IS IMPRINTED  
IN RED

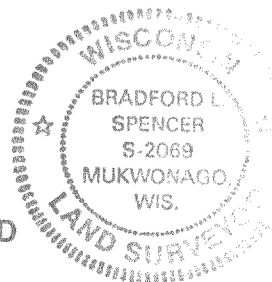

PBLA-8 ✓ 418-1525