


PROPERTY SURVEY

PREPARED FOR: **GARY & SHARI DIERKS / STONECREST HOMES**



LOCATION: **STONE SCHOOL ROAD (TOWN OF EAST TROY)**

DESCRIPTION OF PROPERTY
 LOT 6 IN GREYSTONE ESTATES, PART OF THE SOUTHEAST 1/4 AND SOUTHWEST 1/4'S OF THE NORTHWEST 1/4 OF SECTION 14 AND PART OF THE NORTHEAST 1/4 AND NORTHWEST 1/4'S OF THE SOUTHWEST 1/4 OF SECTION 14 ALL IN TOWN 4 NORTH, RANGE 18 EAST, TOWN OF EAST TROY, WALWORTH COUNTY, WISCONSIN.

(11.7532 ACRES)

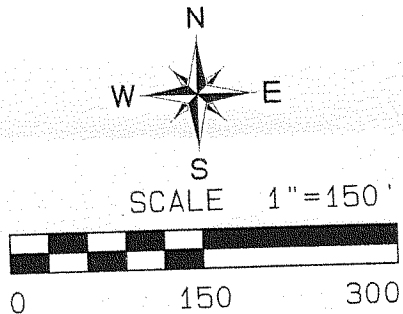

HOUSE DETAIL
 SCALE: 1" = 30'

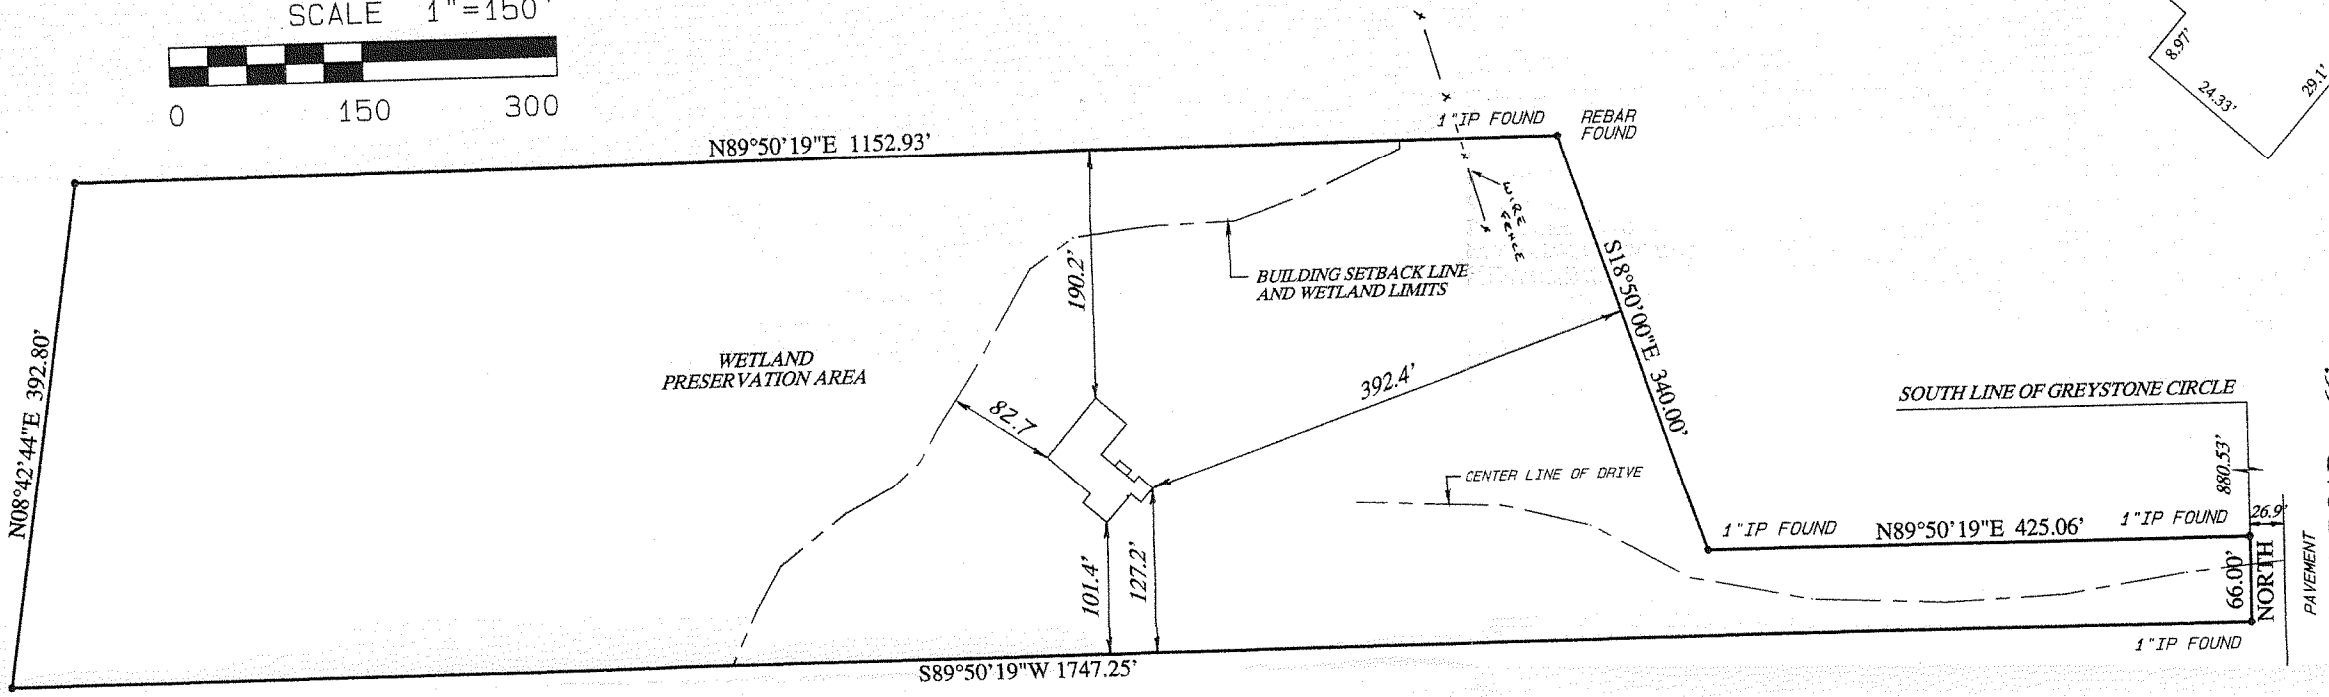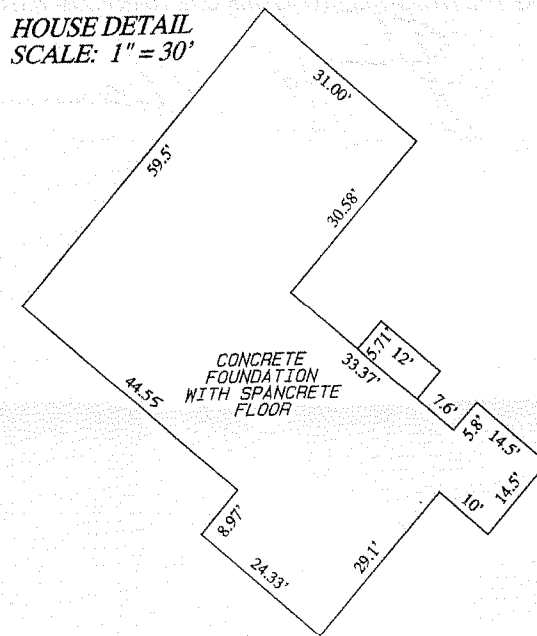

STONE SCHOOL ROAD - 66'
 PAVEMENT



SURVEY CERTIFICATE
 I HAVE SURVEYED THE ABOVE-DESCRIBED PROPERTY AND THE ABOVE MAP IS A TRUE REPRESENTATION THEREOF AND SHOWS THE SIZE AND LOCATION OF THE PROPERTY, ITS EXTERIOR BOUNDARIES, THE LOCATION AND DIMENSIONS OF ALL VISIBLE STRUCTURES THEREON, FENCES, APPARENT EASEMENTS AND ROADWAYS AND VISIBLE ENCROACHMENTS, IF ANY.
 THIS SURVEY IS MADE FOR THE EXCLUSIVE USE OF THE PRESENT OWNERS OF THE PROPERTY, AND ALSO THOSE WHO PURCHASE, MORTGAGE, OR GUARANTEE THE TITLE THERETO WITHIN ONE YEAR FROM DATE HEREOF.

[Handwritten Signature]

FEBRUARY 22, 2006
 DATE RECERTIFICATION 6-9-06

KIT KUOKKANEN
 REGISTERED LAND SURVEYOR
 S-1177

LAND SURVEYORS
KUOKKANEN & ASSOCIATES, INC.
 910 ELM GROVE ROAD
 ELM GROVE, WI 53122
 PHONE: 262-782-8690
 FAX: 262-782-1770

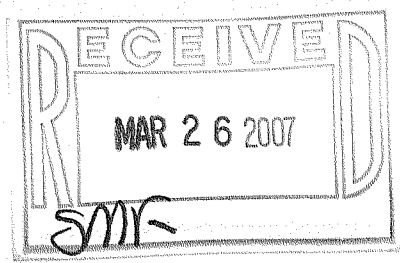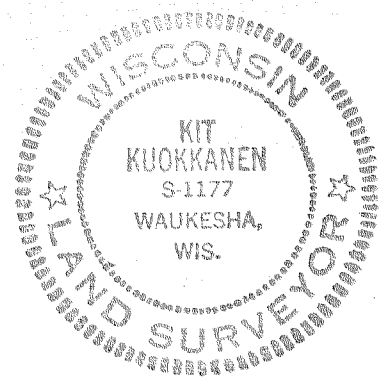

PGRE-6

418-2011