

PLAT OF SURVEY
 LOT 4 OF LAKE BEULAH ESTATES
 TOWN OF EAST TROY, WALWORTH COUNTY, WISCONSIN


WORK ORDERED BY -
 DALE DOBROTH
 1360 MIDDLEFORK DRIVE
 LAKE FOREST, IL 60045

FARRIS, HANSEN & ASSOCIATES, INC.
 ENGINEERING - ARCHITECTURE - SURVEYING
 7 RIDGWAY COURT P.O. BOX 437
 ELKHORN, WISCONSIN 53121
 OFFICE: (262) 723-2098 FAX: (262) 723-5886

REVISIONS

PROJECT NO.
 3360.12
 DATE
 08/20/2012
 SHEET NO.
 1 OF 1

PLAT OF SURVEY
 LOT 4 OF LAKE BEULAH ESTATES
 LOCATED IN PART OF THE NW 1/4 OF THE NE 1/4 OF
 SECTION 8, TOWN 4 NORTH, RANGE 18 EAST,
 WALWORTH COUNTY, WISCONSIN

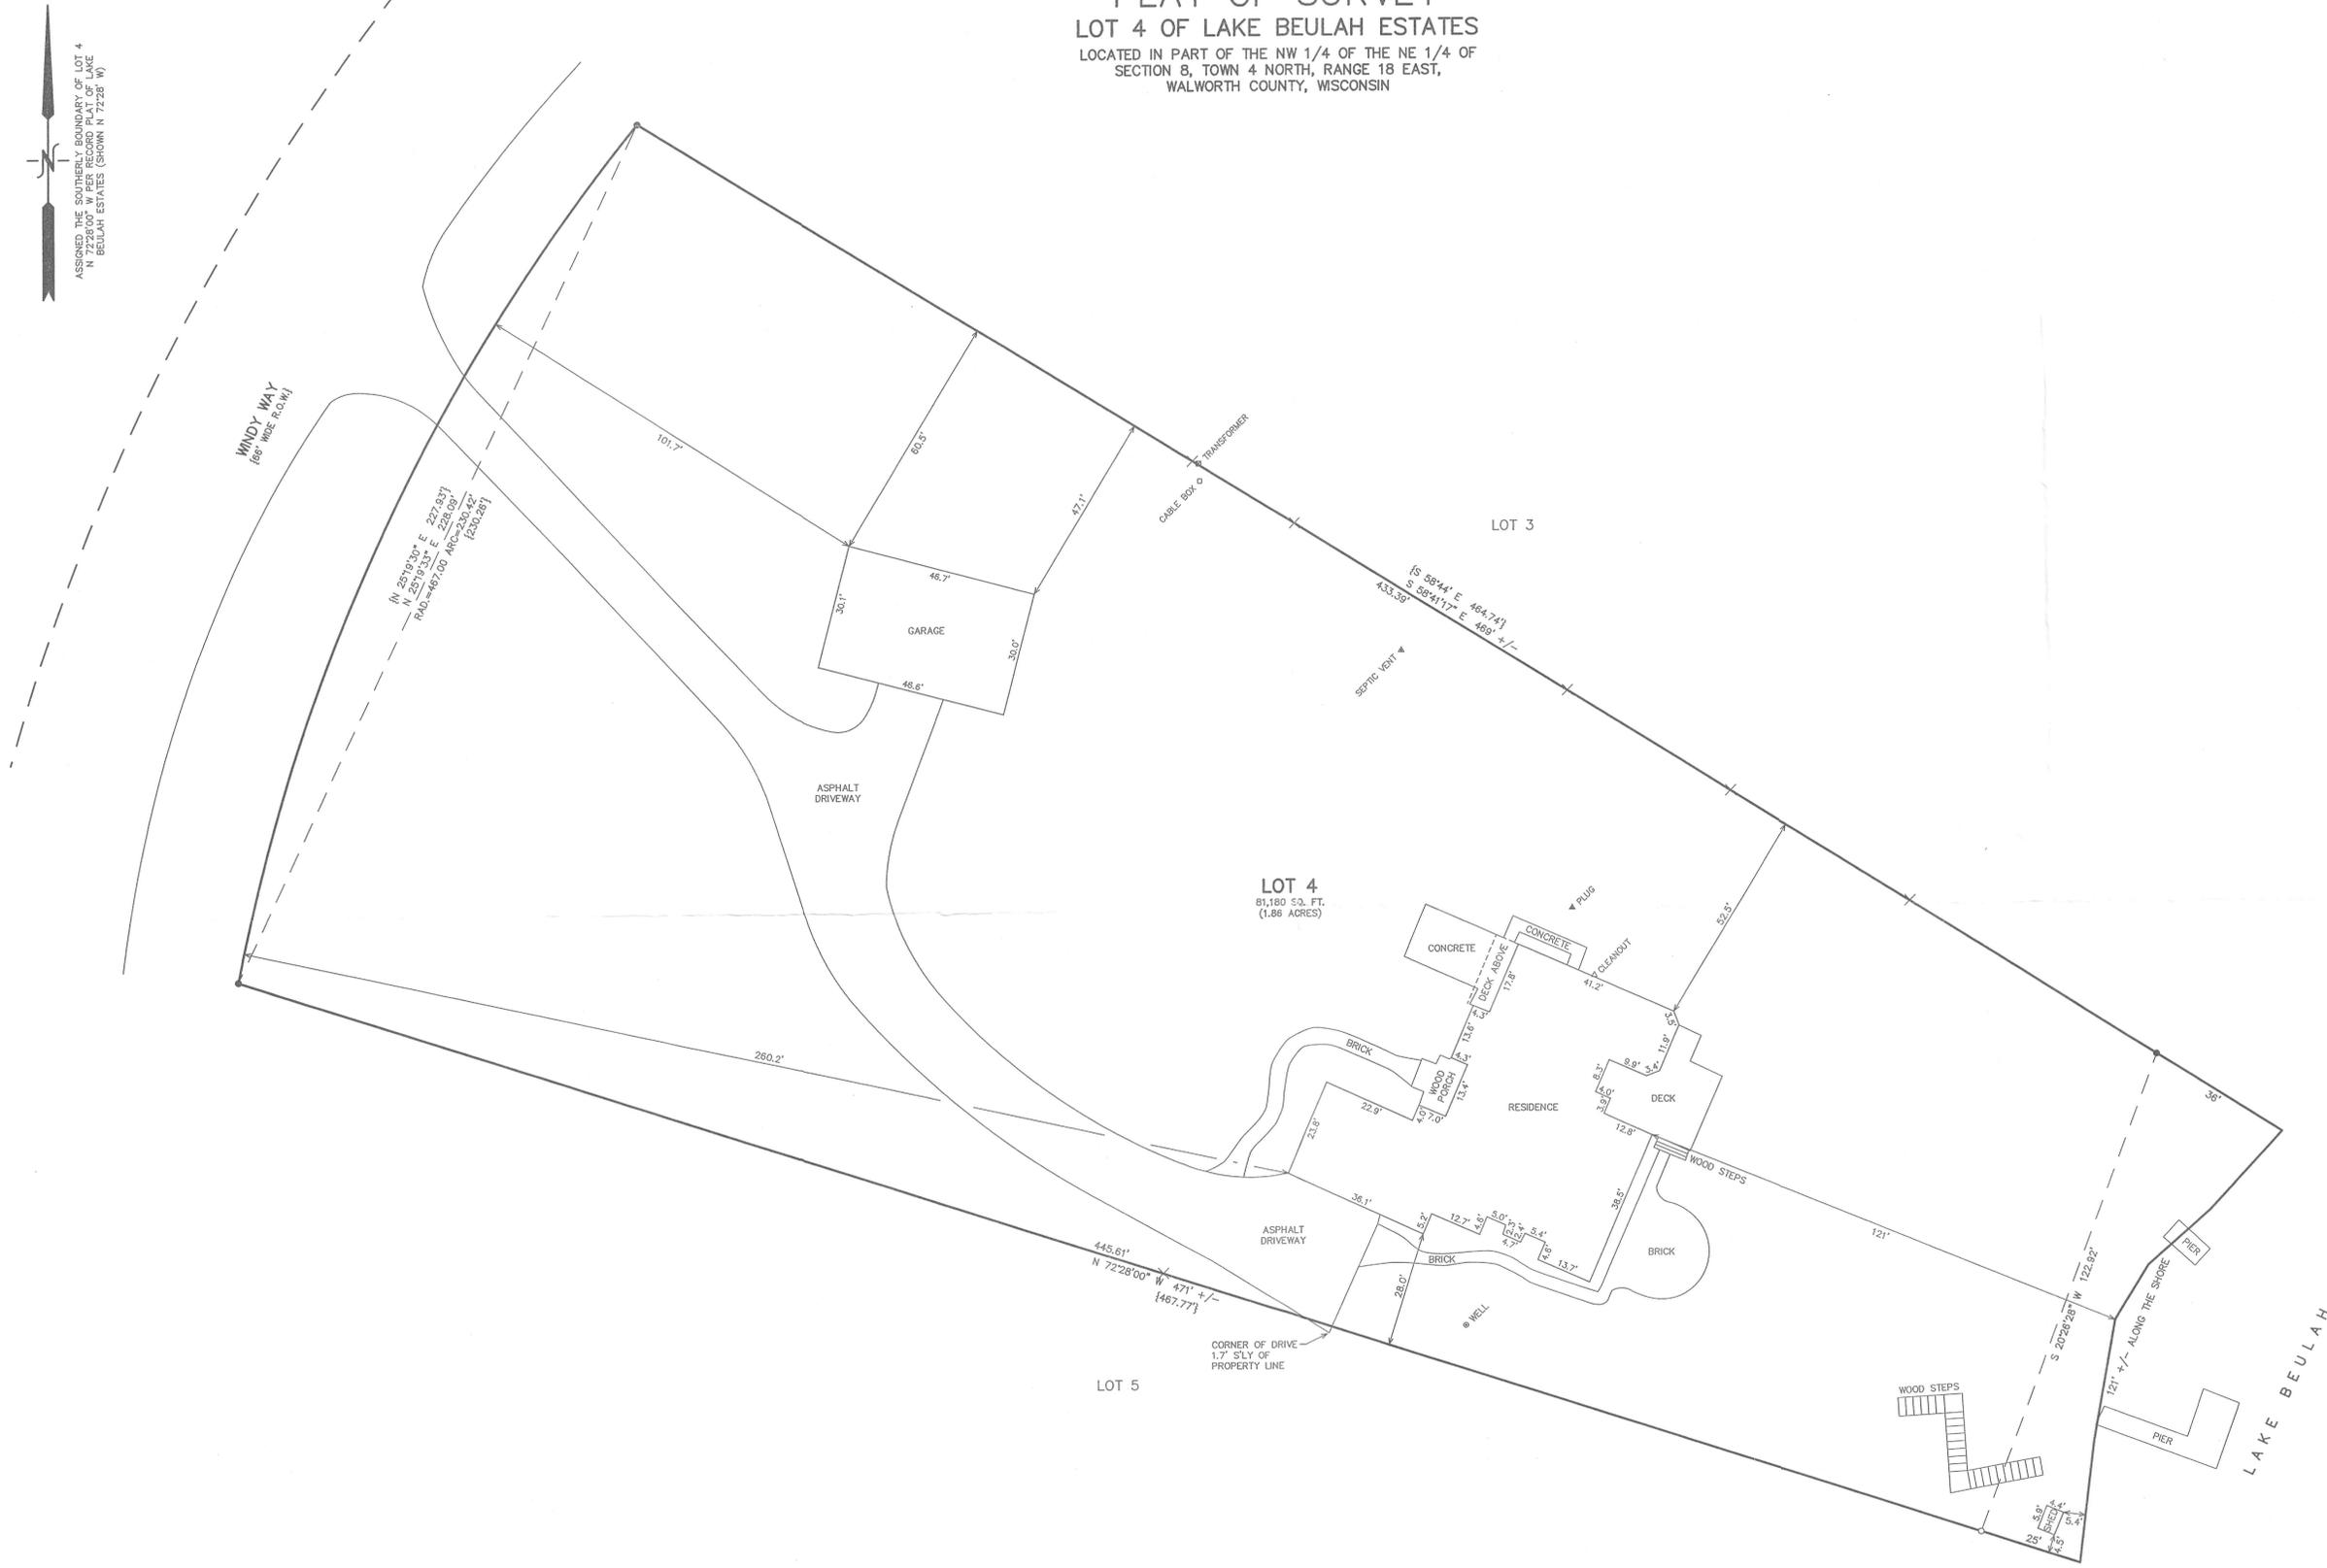

ASSIGNED THE SOUTHERLY BOUNDARY OF LOT 4
 IN PLAT OF SURVEY OF LOT 4 OF LAKE
 BEULAH ESTATES (SHOWN N 72°28' W)

WINDY WAY
 165' WIDE P.C. & W.I.

IN 20719.1301' E 227.837'
 N 25°19'33" E 228.059'
 RAD. = 467.00' ARC = 230.427'
 [230.287']

TO S89°44' E 484.741'
 S 89°41' E 389' +/-

LOT 4
 81,180 SQ. FT.
 (1.86 ACRES)

445.61'
 N 72°28'00" W 471' +/-
 [467.77']

S 20°28'28" W 122.92'
 121' +/- ALONG THE SHORE

LOT 5

- LEGEND
- = FOUND IRON PIPE STAKE
 - = FOUND IRON REBAR STAKE
 - × = SET LATH ALONG PROPERTY LINE
 - {xxx} = RECORDED AS


RECEIVED
 OCT 9 4 2012
 SWK



NOTE: COPIES OF THIS MAP TO WHICH THE FOLLOWING CERTIFICATE
 WILL APPLY SHOW THE SURVEYOR'S ORIGINAL SEAL AND SIGNATURE
 IN RED INK. COPIES BY ANY OTHER MEANS MAY HAVE ALTERATIONS
 WHICH DO NOT REPRESENT THE SURVEYOR'S WORK PRODUCT.

I HEREBY CERTIFY THAT THE ABOVE DESCRIBED PROPERTY HAS BEEN
 SURVEYED UNDER MY DIRECTION AND THAT THE ABOVE MAP IS A TRUE
 REPRESENTATION THEREOF AND SHOWS THE SIZE AND LOCATION OF
 THE PROPERTY AND ITS EXTERIOR BOUNDARIES. THIS SURVEY IS
 MADE FOR THE USE OF THE PRESENT OWNERS OF THE PROPERTY, AND
 ALSO THOSE WHO PURCHASE, MORTGAGE OR GUARANTEE THE TITLE
 THERETO WITHIN ONE YEAR FROM THE DATE HEREOF.

DATED: 08/20/2012
 Peter S. Gordon
 PETER S. GORDON R.L.S. 2101

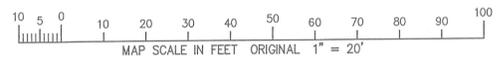

AME 8.1 2012

8/20/2012 X:\Projects\3360\CAD\2012SURVEY

PLB-4

418-3303