
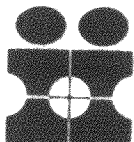
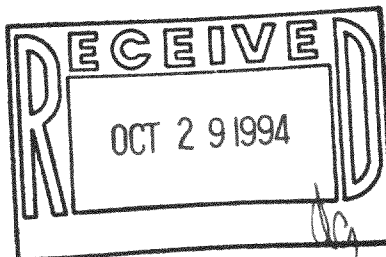


Plat of Survey

Survey For: Ed Komorowski

Location: W2162 Wilmer Grove Road

Description: LOT 39 BLOCK 1 WILMER GROVE BEACH, lying and being in the East 1/2 of Section 13, Town 4 North, Range 13 East, in the Town of East Troy, Walworth County, Wisconsin.

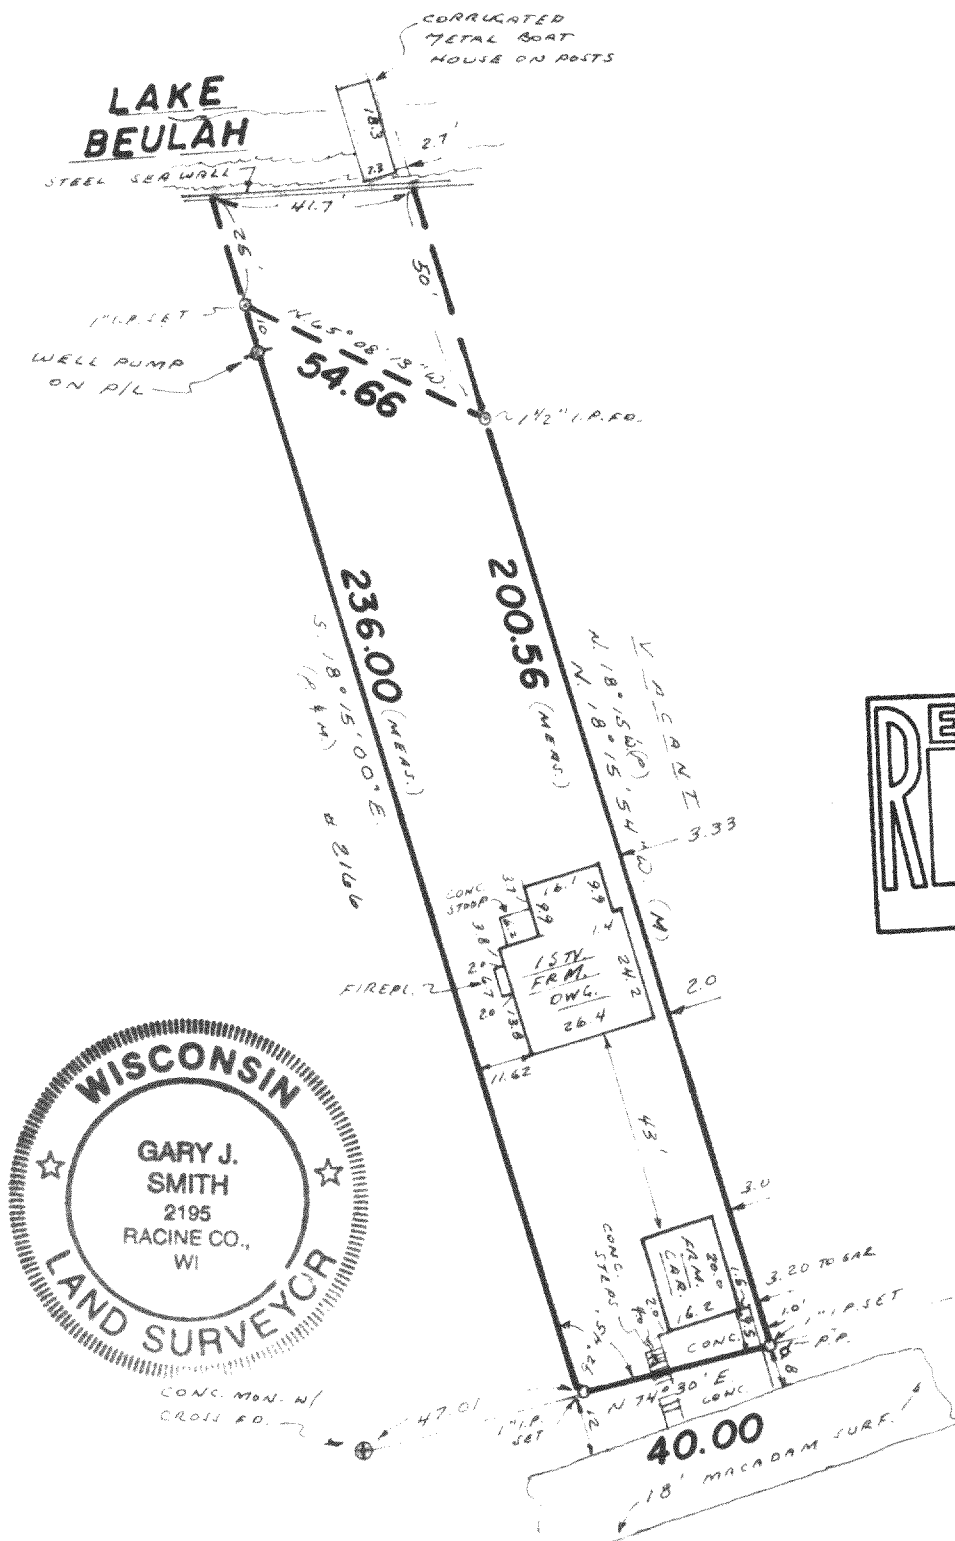

INTERLINE SURVEY SERVICES, INC.
11221 W. FOREST HOME AVE
HALES CORNERS, WISCONSIN 53130
PHONE 425-2060

SURVEY CERTIFICATE

Scale: 1" = 40'

State of Wisconsin) ss
Milwaukee County

We, Interline Survey Services, Inc., certify that we have surveyed the above described property and the above map is a true representation thereof, and shows the size and location of the property, its exterior boundaries, the location and dimensions of all visible structures thereon, fences, apparent easements and roadways and visible encroachments, if any.

This survey is made for the exclusive use of the present owners of the Property, and also those who purchase, mortgage, or guarantee the title thereto, within one (1) year from date hereof.

Gary J. Smith S-2195
Wisconsin Registered Land Surveyor

Date: 9/19/94
Job No.: 23301

PWW-27

418-1006