

PLAT OF SURVEY




DATE: 3/24/93

FOR: RICHARD K. AND MICHELLE E. BRAUNSCHWEIG


DESCRIPTION: LOT 7 IN BLOCK 2 IN MIRAMAR SUBDIVISION, BEING A PART OF SECTIONS 10 AND 11, TOWNSHIP 4 NORTH, RANGE 18 EAST, *TOWN N* VILLAGE OF EAST TROY, WALWORTH COUNTY, WISCONSIN.

LEGEND

- IRON PIPE FOUND
- IRON PIPE SET
- ▨ GRAVEL
- P/L PROPERTY LINE

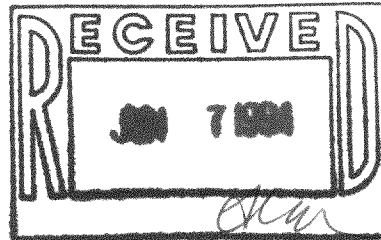


BASIS OF BEARING -
THE EAST LINE OF LOT 7
WAS TAKEN TO BEAR
N44°39'59"E.

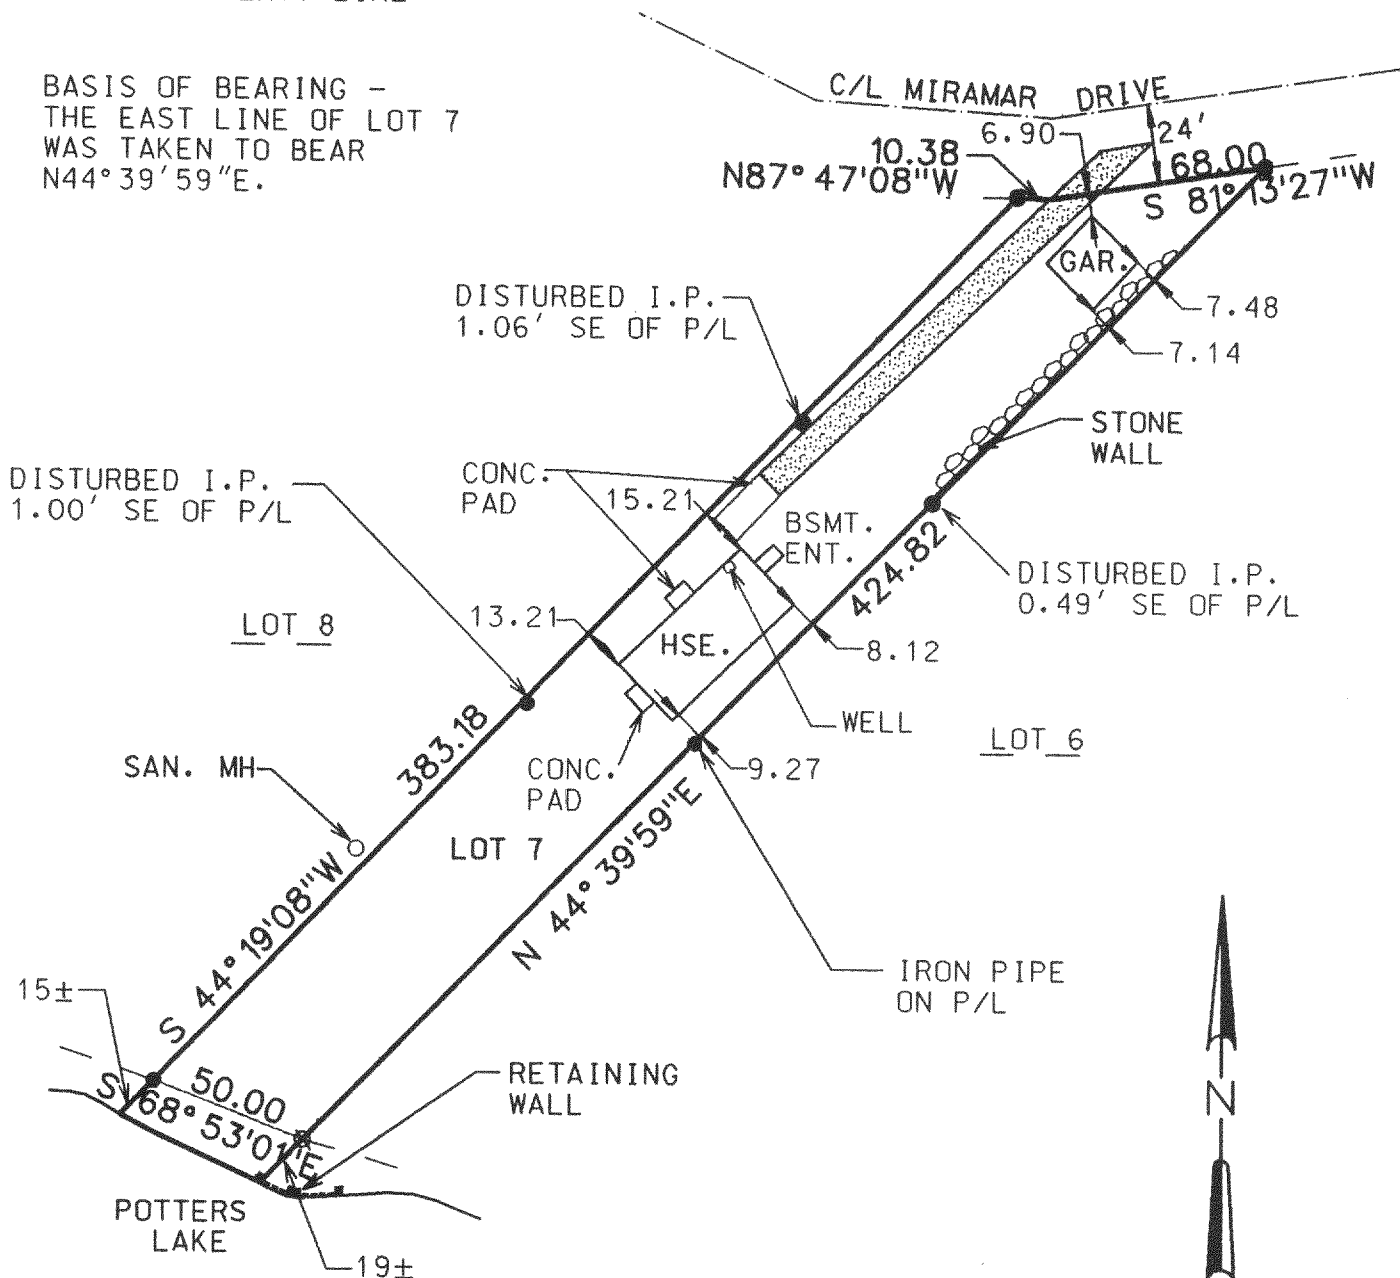

THE ABOVE MAP IS A TRUE REPRESENTATION THEREOF AND SHOWS THE SIZE AND LOCATION OF ALL THE PROPERTY, EXTERIOR BOUNDARIES, THE LOCATION OF ALL VISIBLE BOUNDARY FENCES, APPARENT EASEMENTS, ROADWAYS AND VISIBLE ENCROACHMENTS, IF ANY.

THIS SURVEY IS MADE FOR THE USE OF THE PRESENT OWNERS OF THE PROPERTY, AND ALSO THOSE WHO PURCHASE, MORTGAGE OR GUARANTEE TITLE THERETO WITHIN ONE (1) YEAR FROM DATE HERETO.

THIS IS ORIGINAL
PRINT ONLY IF
SEAL IS IMPRINTED
IN RED

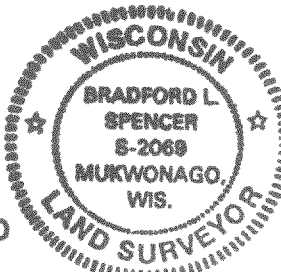

BRADFORD L. SPENCER, R.L.S. 2069
94097.DGN

PMR-31

418-1008