
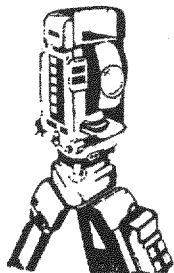


PLAT OF SURVEY
-OF-

LOT 3, CERTIFIED SURVEY MAP No. 30, located in part of the East 1/2 of Section 9, Township 4 North, Range 18 East in the Township of East Troy, County of Walworth and State of Wisconsin.

Survey For: Hackbarth Builders

BEULAH LAKE

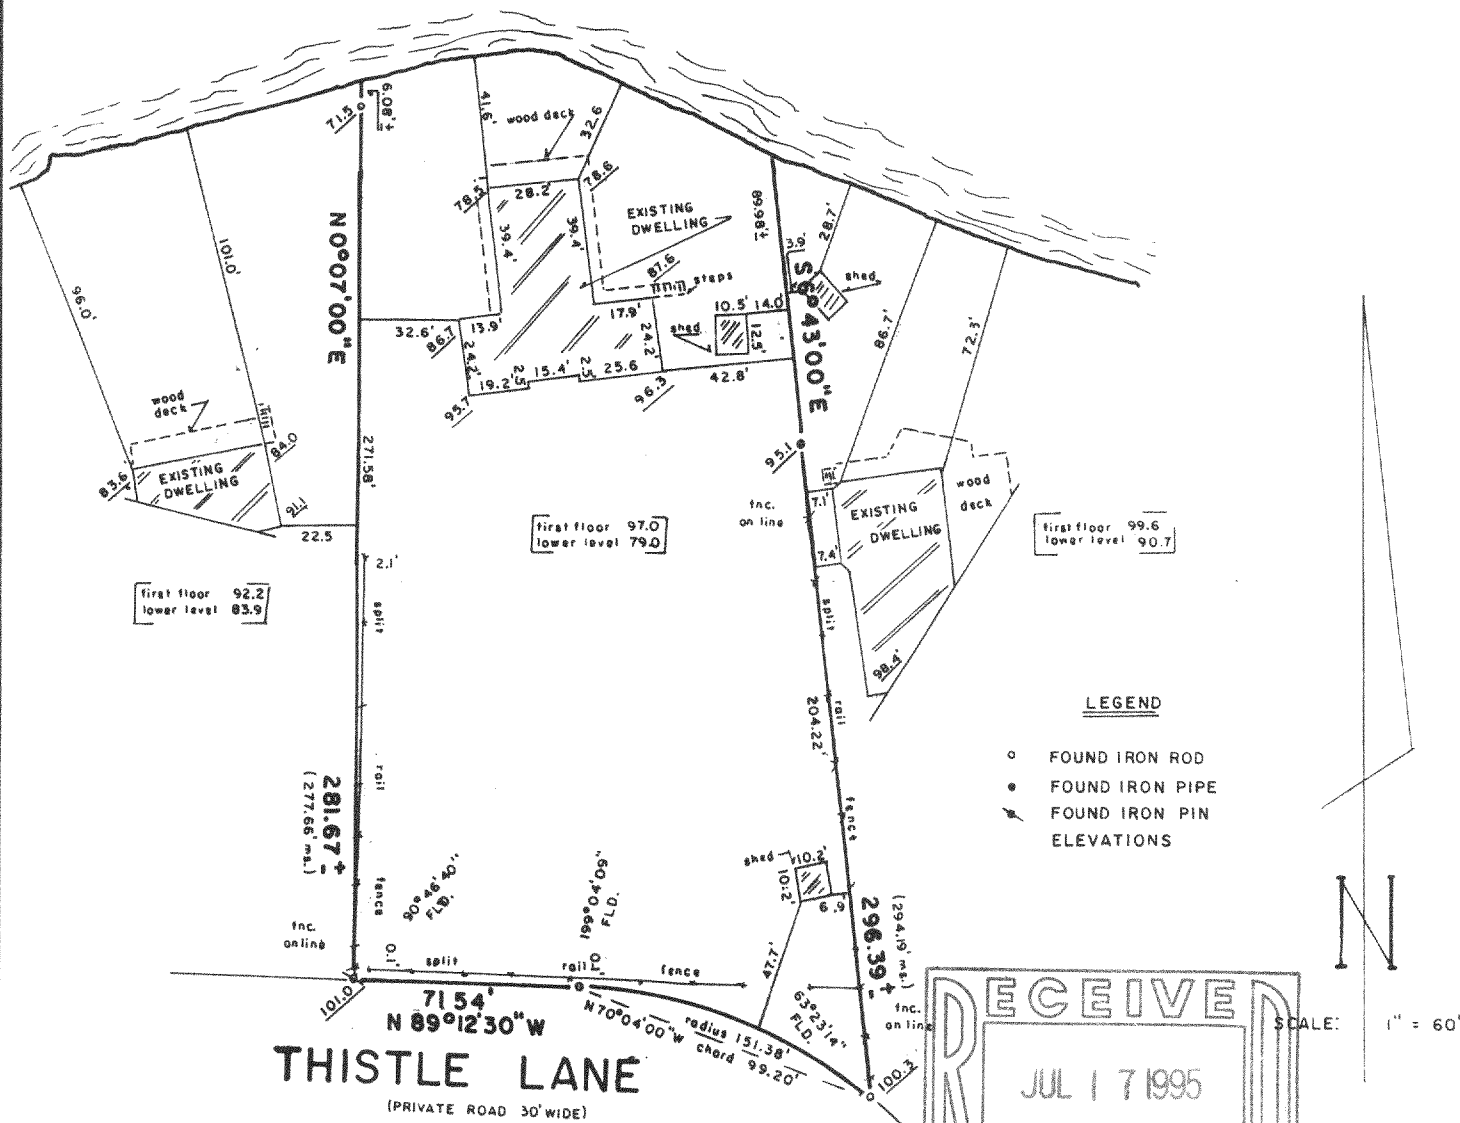

B.W. SURVEYING

Land Surveys
Mapping And Planning
425 Milwaukee Avenue
Burlington, WI 53105
(414) 767-0225

"I hereby certify that I have surveyed the above described property and that the above map is a true representation thereof and shows the size and location of the property, its exterior boundaries, the location of all visible structures and dimensions of all principal buildings thereon, boundary fences, apparent easements, roadways and encroachments, if any."

"This survey is made for the use of the present owners of the property, and those who purchase, mortgage, or guarantee the title thereto within one year from the date hereof."

PA-30-3