

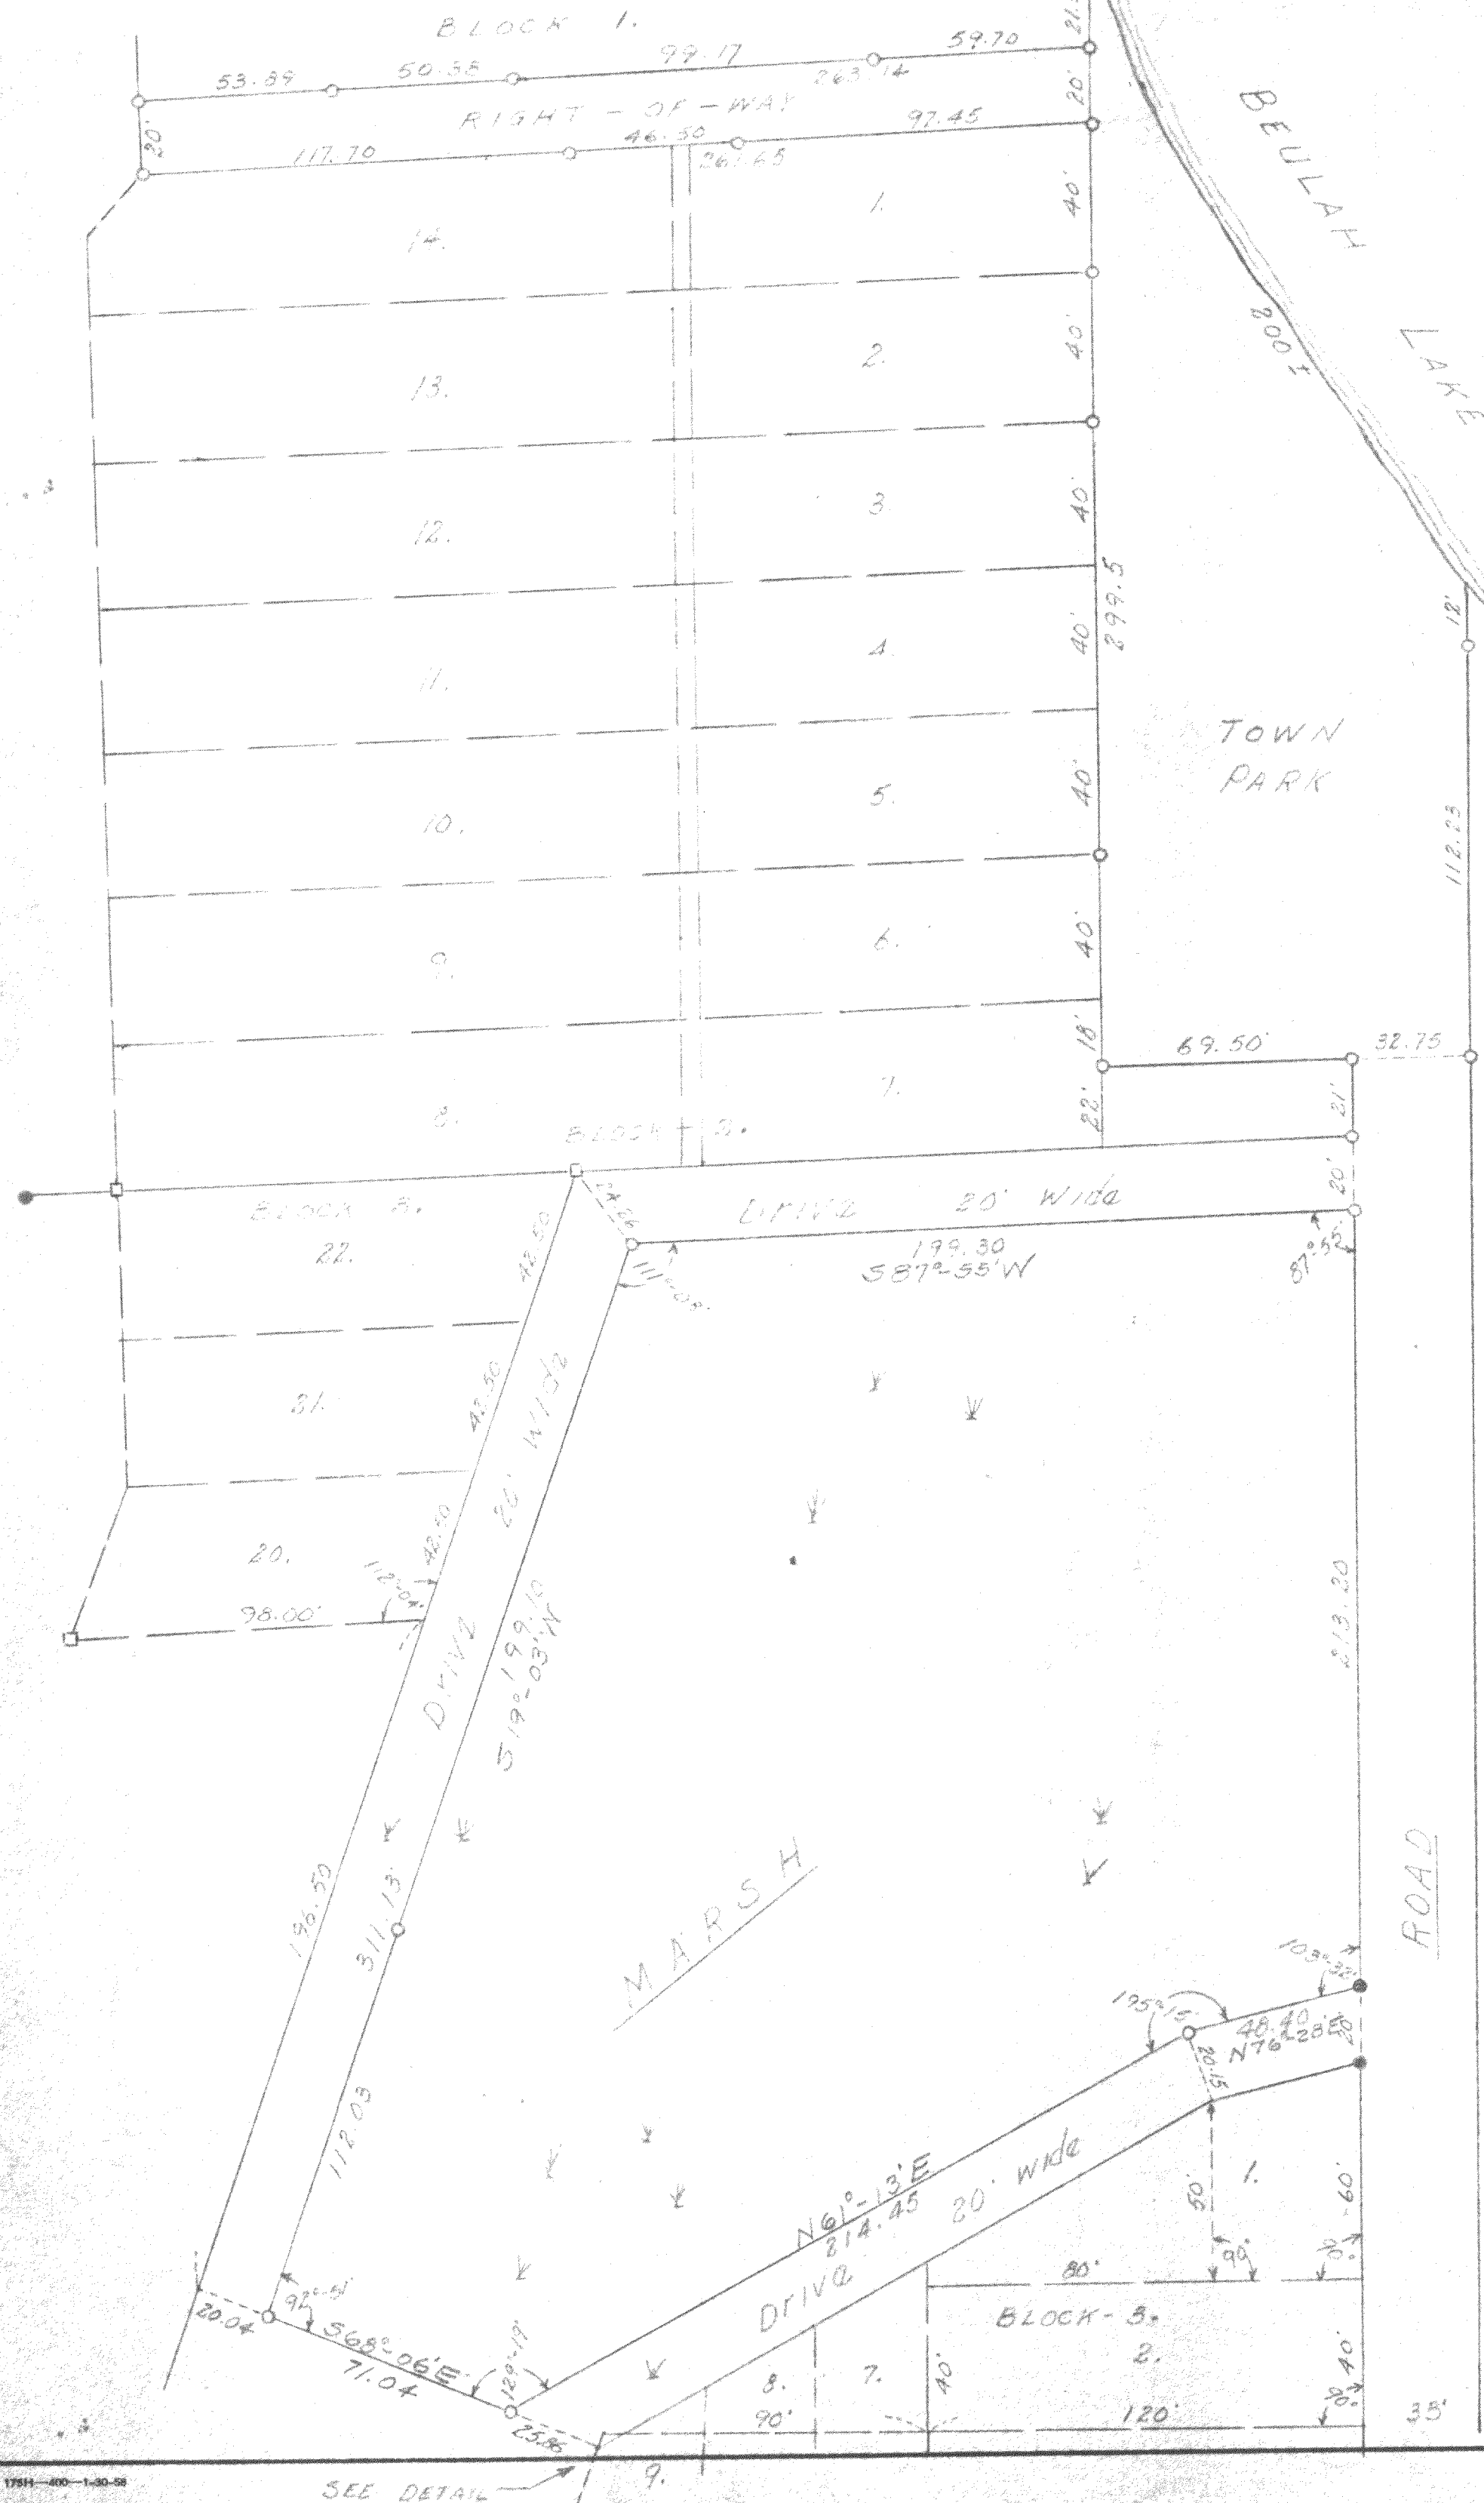


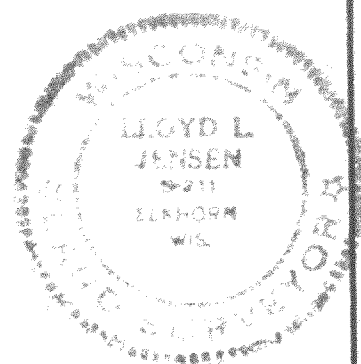

LEGEND

- - OLD WOOD STAKE
- - IRON PIPE
- - EXISTING IRON BAR

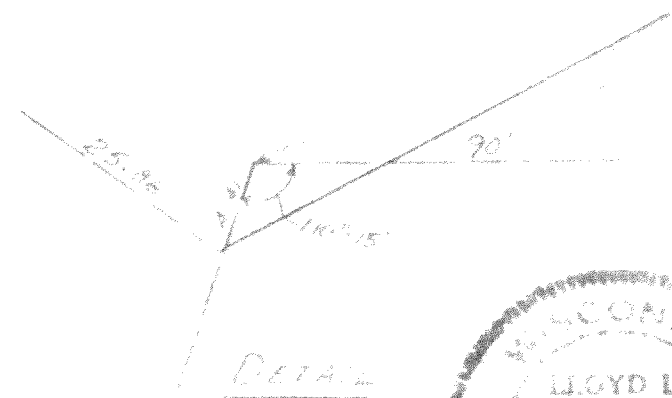

PLAT OF SURVEY OF

TOWN PARK, 20 FOOT RIGHT OF WAY
TO LAKE BETWEEN BLOCK 1 & 2, AND THE
OPEN BLOCK SOUTHWEST OF THE TOWN
PARK - LOCATED IN "WILMER GROVE BEACH"
E 1/2 SEC. 18, T4N, R18E,
WALWORTH COUNTY, WISCONSIN.

Lloyd L. Jensen
SURVEYOR

SCALE 1" = 40'

DATE August 31, 1963