


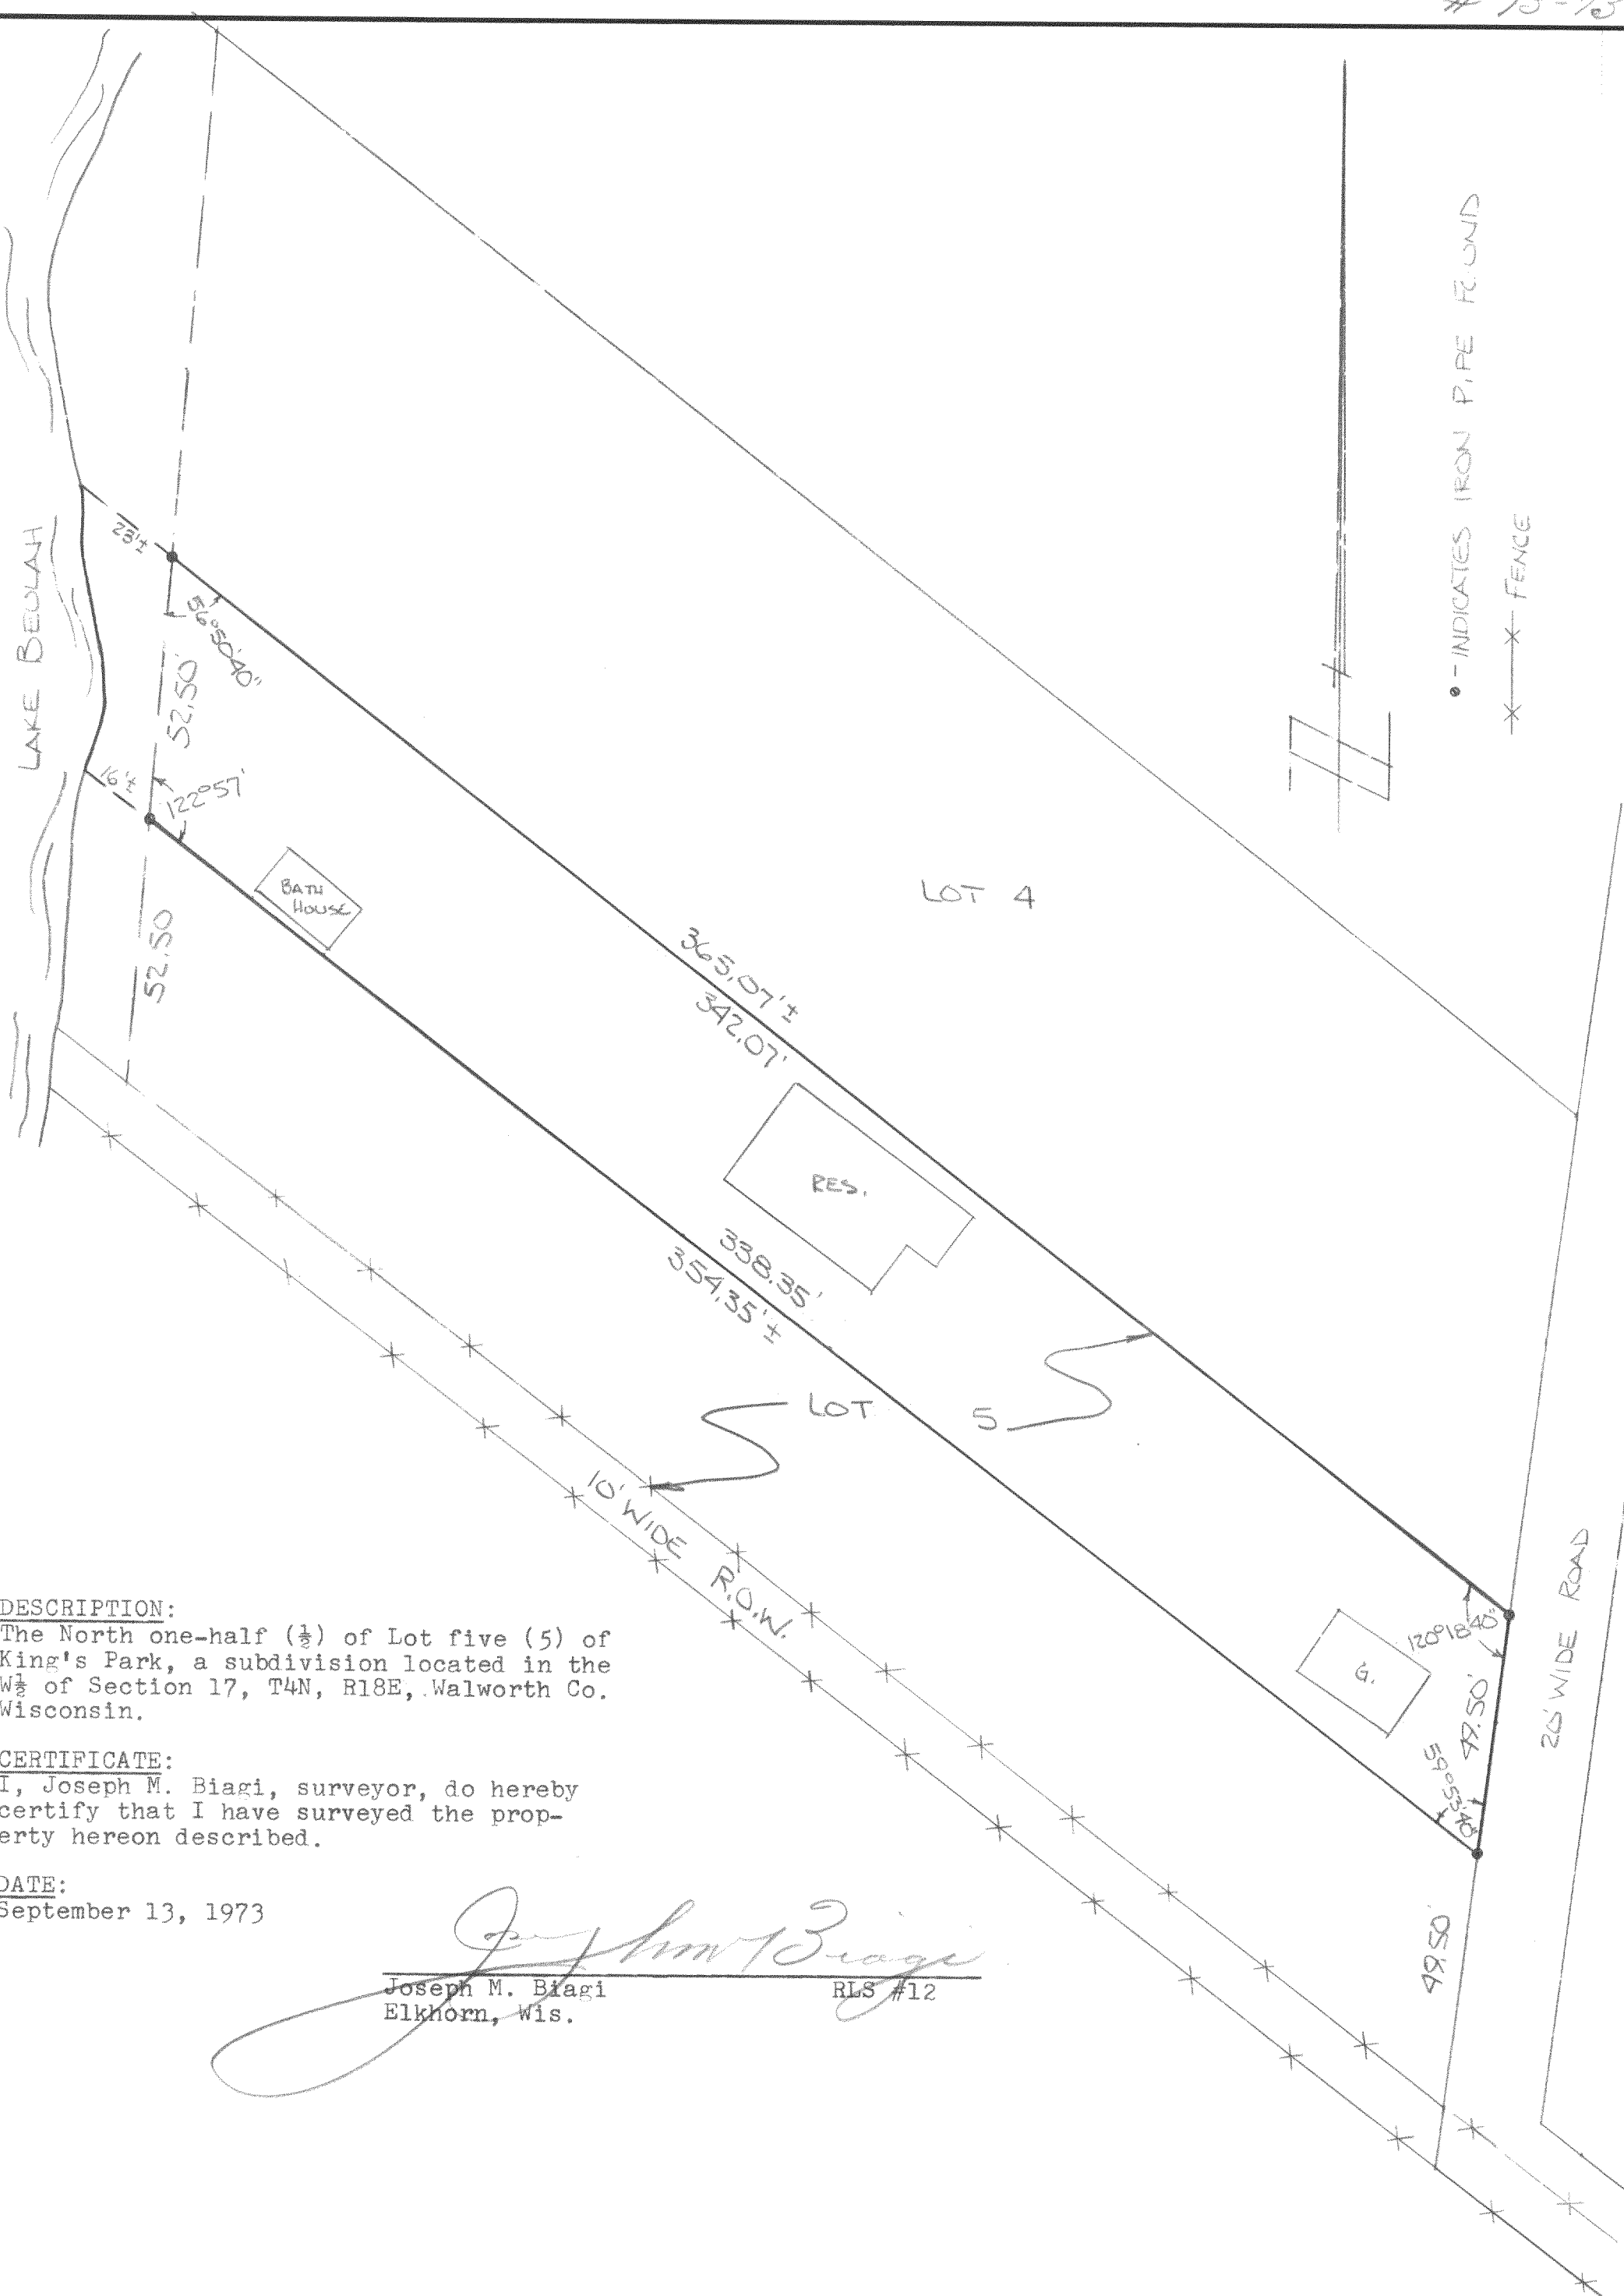

DESCRIPTION:

The North one-half ($\frac{1}{2}$) of Lot five (5) of King's Park, a subdivision located in the W $\frac{1}{2}$ of Section 17, T4N, R18E, Walworth Co. Wisconsin.

CERTIFICATE:

I, Joseph M. Biagi, surveyor, do hereby certify that I have surveyed the property hereon described.

DATE:

September 13, 1973

Joseph M. Biagi
Elkhorn, Wis.

RLS #12