



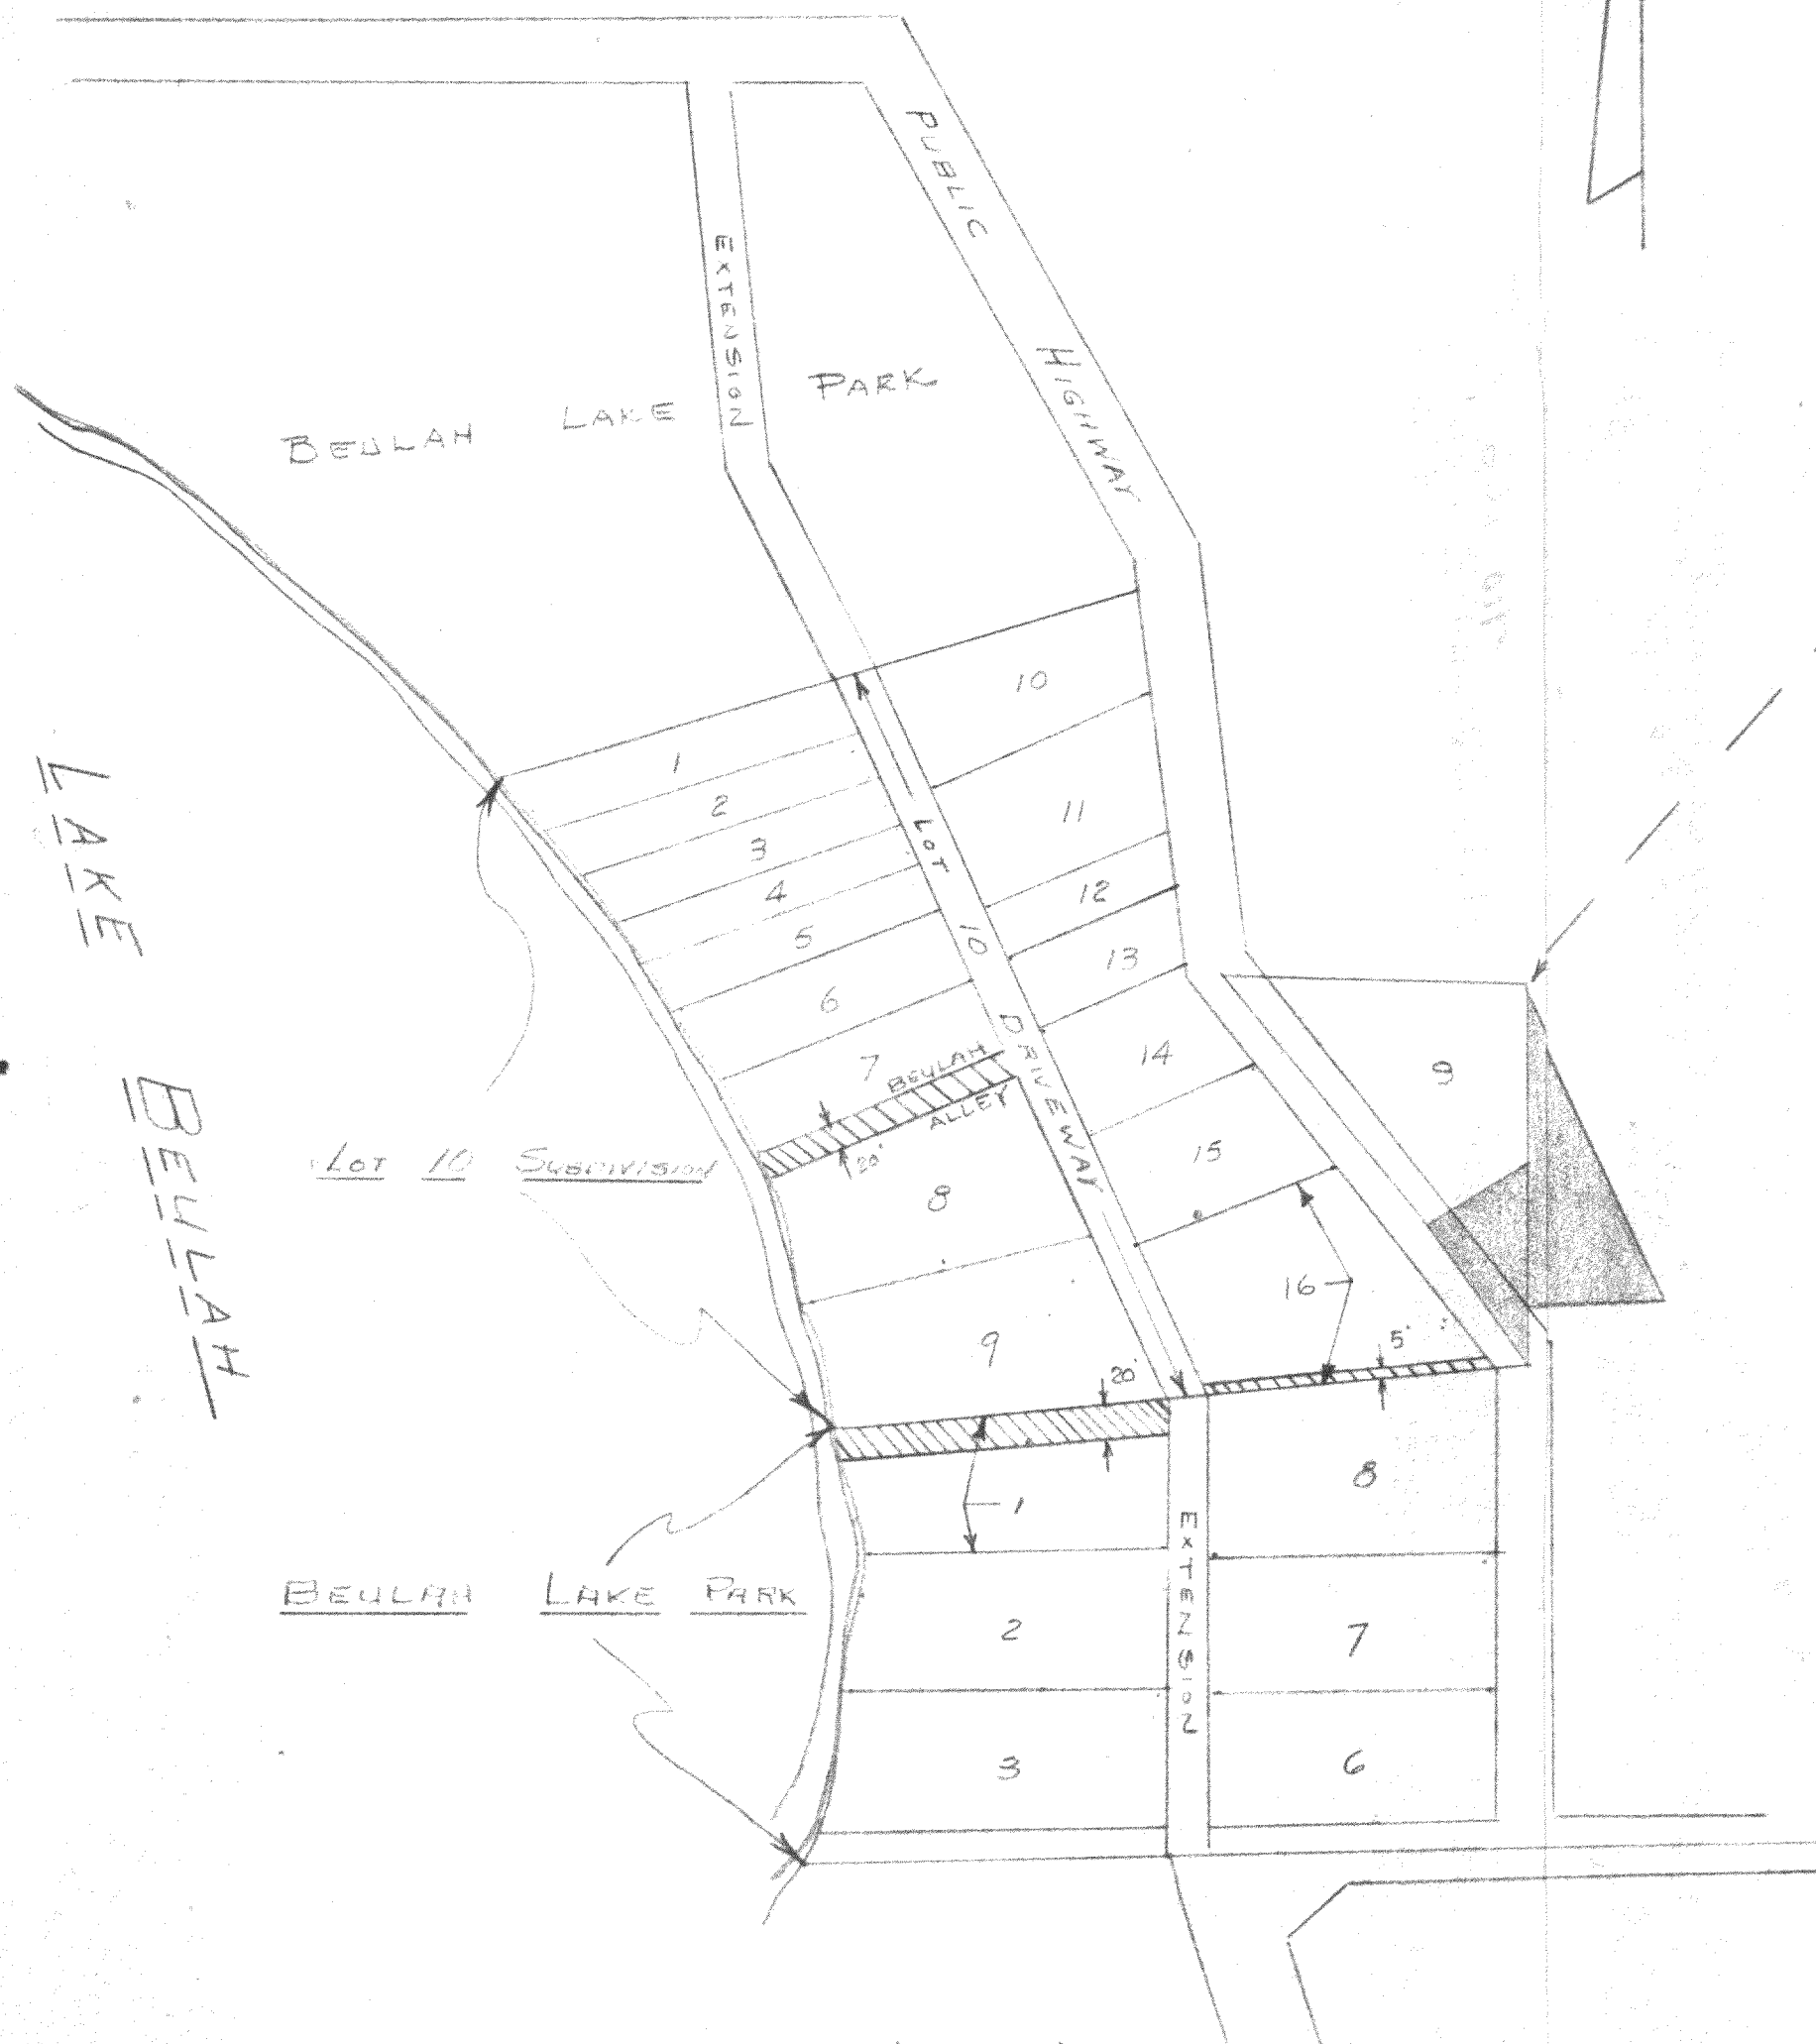

SKETCH SHOWING EASEMENTS

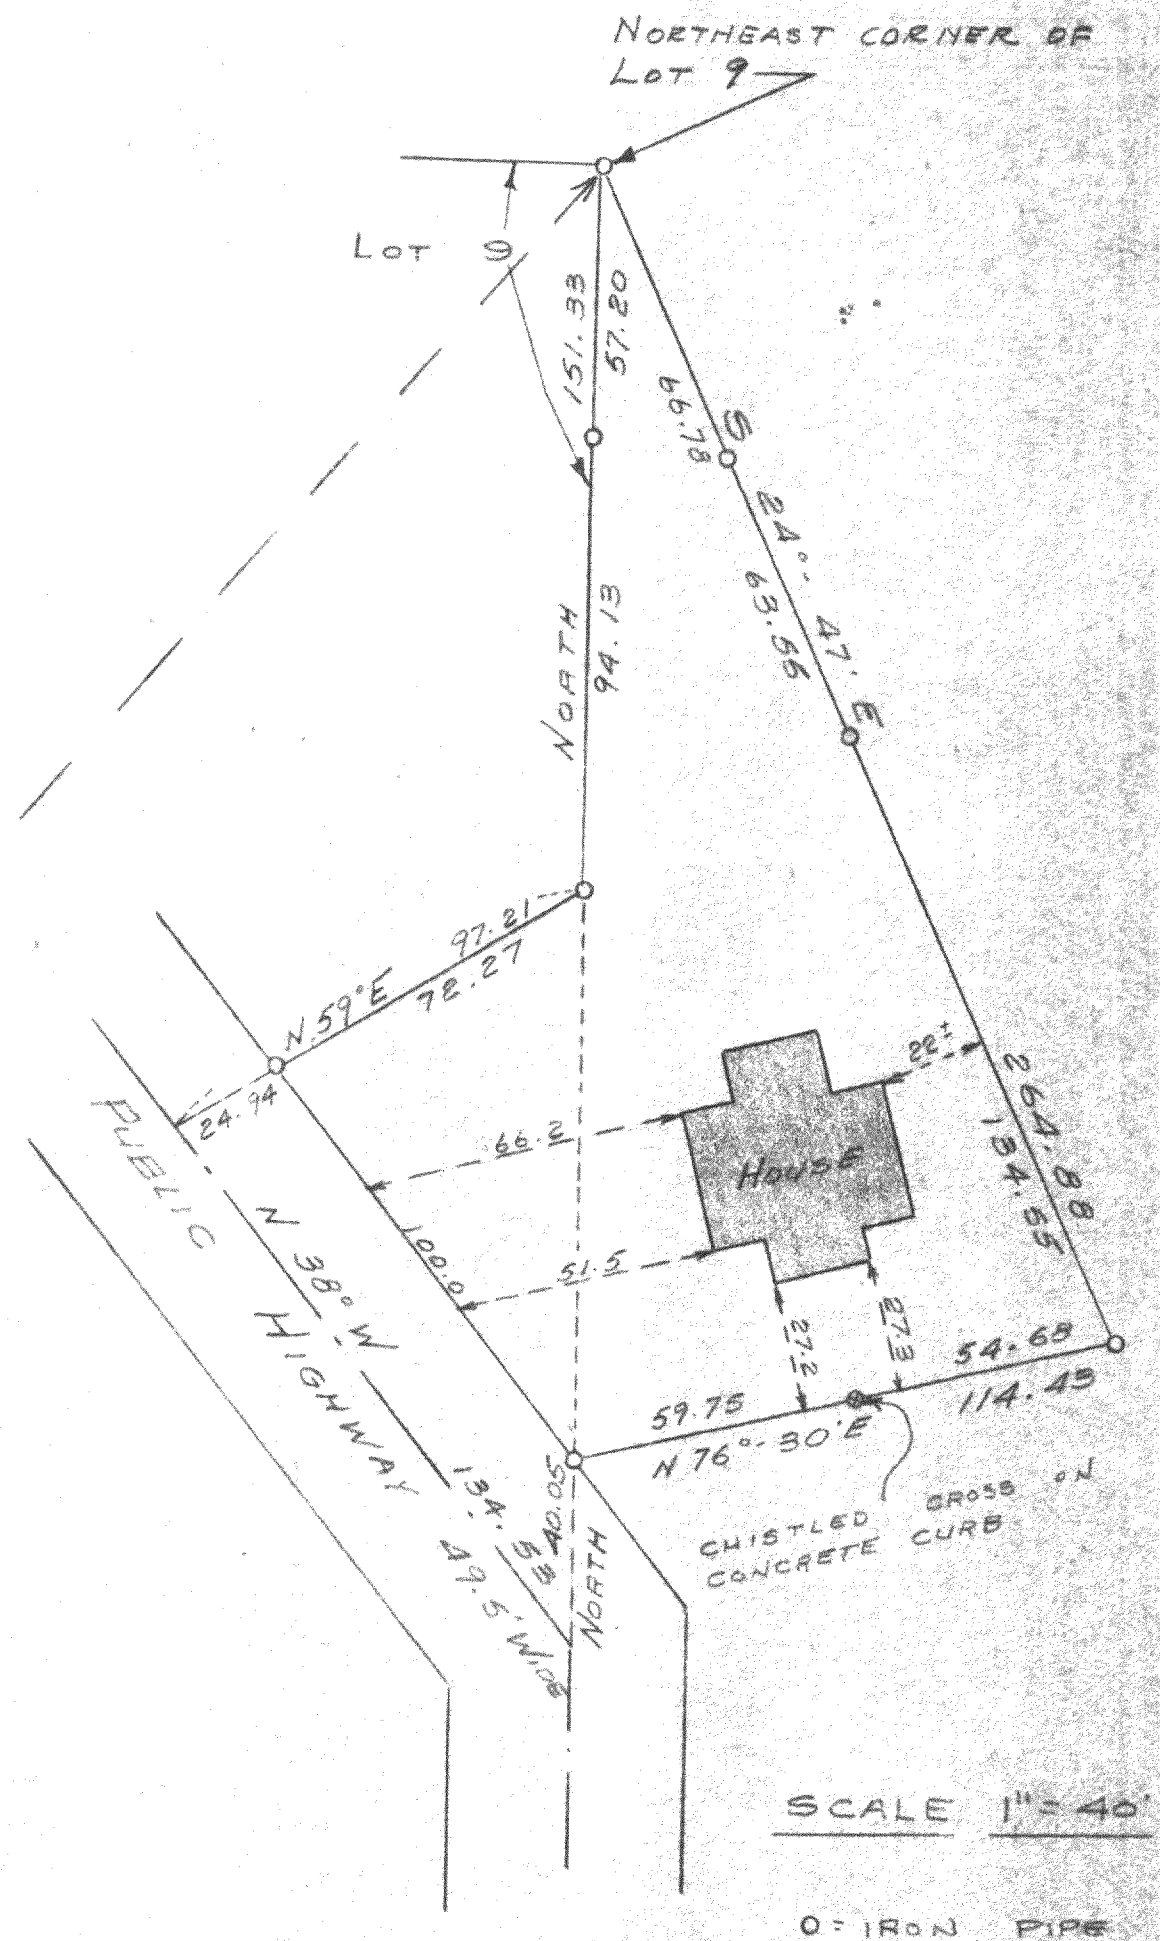

PLAT OF SURVEY OF

PART OF LOT 9 - BEULAH LAKE PARK -
LAND LOCATED IN SECTION 4
T 4 N - R 18 E - TOWN OF EAST TROY
WALWORTH COUNTY, WISCONSIN

Lloyd P. Jensen
SURVEYOR

SCALE 1" = AS SHOWN

DATE, DEC. 1963