
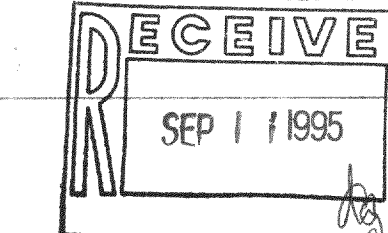
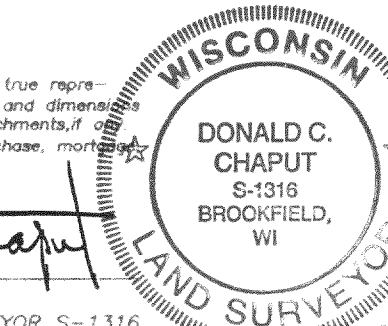
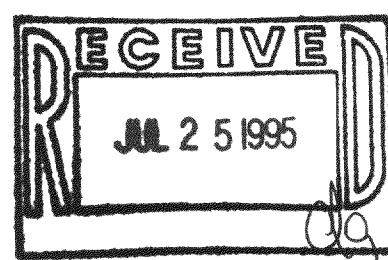


PLAT OF SURVEY

THAT PART OF THE NORTHEAST 1/4 AND THE SOUTHEAST 1/4 OF THE NORTHEAST 1/4 OF SECTION 17 AND THAT PART OF BLOCK "B" IN OAK PARK SUBDIVISION IN THE SOUTHWEST 1/4 OF THE NORTHWEST 1/4 OF SECTION 16, IN TOWNSHIP 4 NORTH, RANGE 18 EAST, IN THE TOWN OF EAST TROY, WALWORTH COUNTY, WISCONSIN, WHICH IS BOUNDED AND DESCRIBED AS FOLLOWS:
BEGINNING AT THE EAST 1/4 CORNER OF SAID SECTION 17; THENCE SOUTH 88°41'42" WEST ALONG THE SOUTH LINE OF THE NORTHEAST 1/4 OF SAID SECTION 1321.275 FEET TO THE SOUTHWEST CORNER OF THE SOUTHEAST 1/4 OF SAID 1/4 SECTION; THENCE NORTH 00°02'49" WEST 1313.285 FEET TO THE NORTHWEST CORNER OF THE SOUTHEAST 1/4 OF SAID 1/4 SECTION; THENCE NORTH 88°42'29" EAST 660.68 FEET TO A POINT ON THE WEST LINE OF THE EAST 1/2 OF THE NORTHEAST 1/4 OF SAID 1/4 SECTION; THENCE NORTH 00°02'42" WEST 1313.135 FEET TO A POINT ON THE NORTH LINE OF SAID 1/4 SECTION; THENCE NORTH 88°43'16" EAST 660.72 FEET TO THE NORTHEAST 1/4 OF SAID 1/4 SECTION; THENCE SOUTH 00°02'35" EAST ALONG THE EAST LINE OF SAID 1/4 SECTION 1312.985 FEET TO A POINT; THENCE NORTH 88°42'28" EAST 225.00 FEET TO A POINT ON A MEANDER LINE OF ARMY LAKE; THENCE SOUTH 17°23'45" EAST ALONG SAID MEANDER LINE 168.19 FEET TO A POINT; THENCE SOUTH 67°07'24" WEST ALONG SAID MEANDER LINE 212.59 FEET TO A POINT; THENCE SOUTH 15°31'42" EAST ALONG SAID MEANDER LINE 130.51 FEET TO A POINT; THENCE SOUTH 14°06'40" EAST ALONG SAID MEANDER LINE 147.66 FEET TO A POINT; THENCE SOUTH 43°09'15" EAST ALONG SAID MEANDER LINE 53.24 FEET TO A POINT; THENCE SOUTH 89°01'22" EAST ALONG SAID MEANDER LINE 78.05 FEET TO A POINT; THENCE SOUTH 20°14'47" WEST 560.37 FEET TO A POINT ON THE EAST LINE OF THE NORTHEAST 1/4 OF SAID SECTION 17; THENCE SOUTH 00°02'35" EAST ALONG SAID EAST LINE 240.00 FEET TO THE POINT OF BEGINNING.
TOGETHER WITH THOSE LANDS LYING BETWEEN SAID MEANDER LINE AND THE SHORE LINE OF ARMY LAKE.
SAID PARCEL CONTAINS 62.6235 ACRES EXCLUSIVE OF THOSE LANDS LYING BETWEEN SAID MEANDER LINE AND THE SHORE LINE OF ARMY LAKE.

MAY 12, 1995 SALVATION ARMY SURVEY NO. 156517

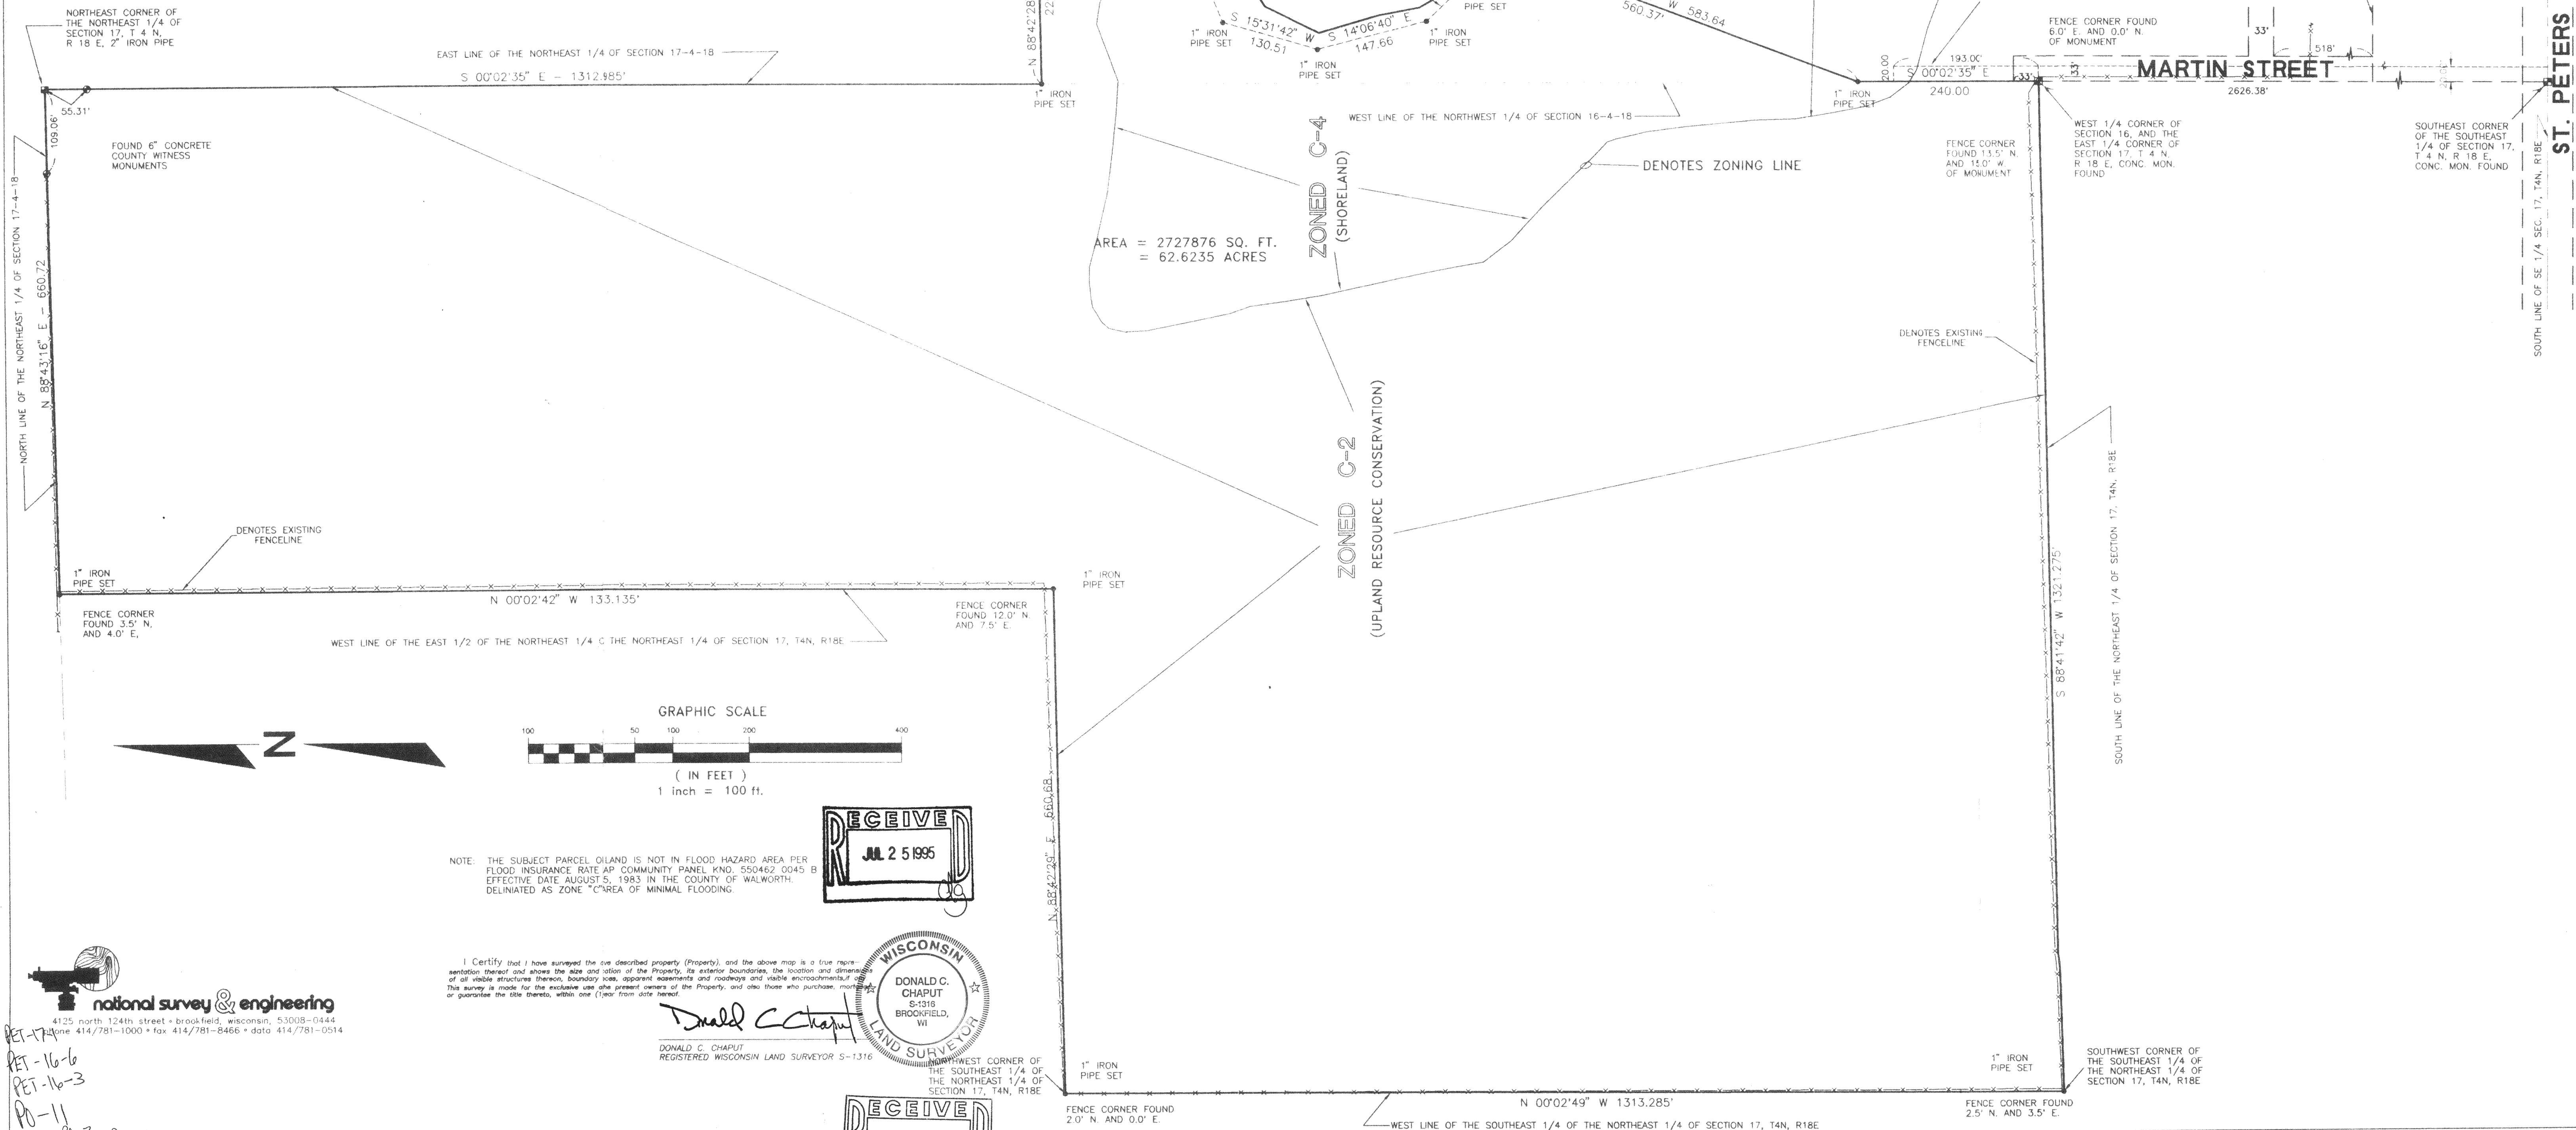

national survey & engineering
4125 north 124th street • brookfield, wisconsin, 53008-0444
phone 414/781-1000 • fax 414/781-8466 • data 414/781-0514