


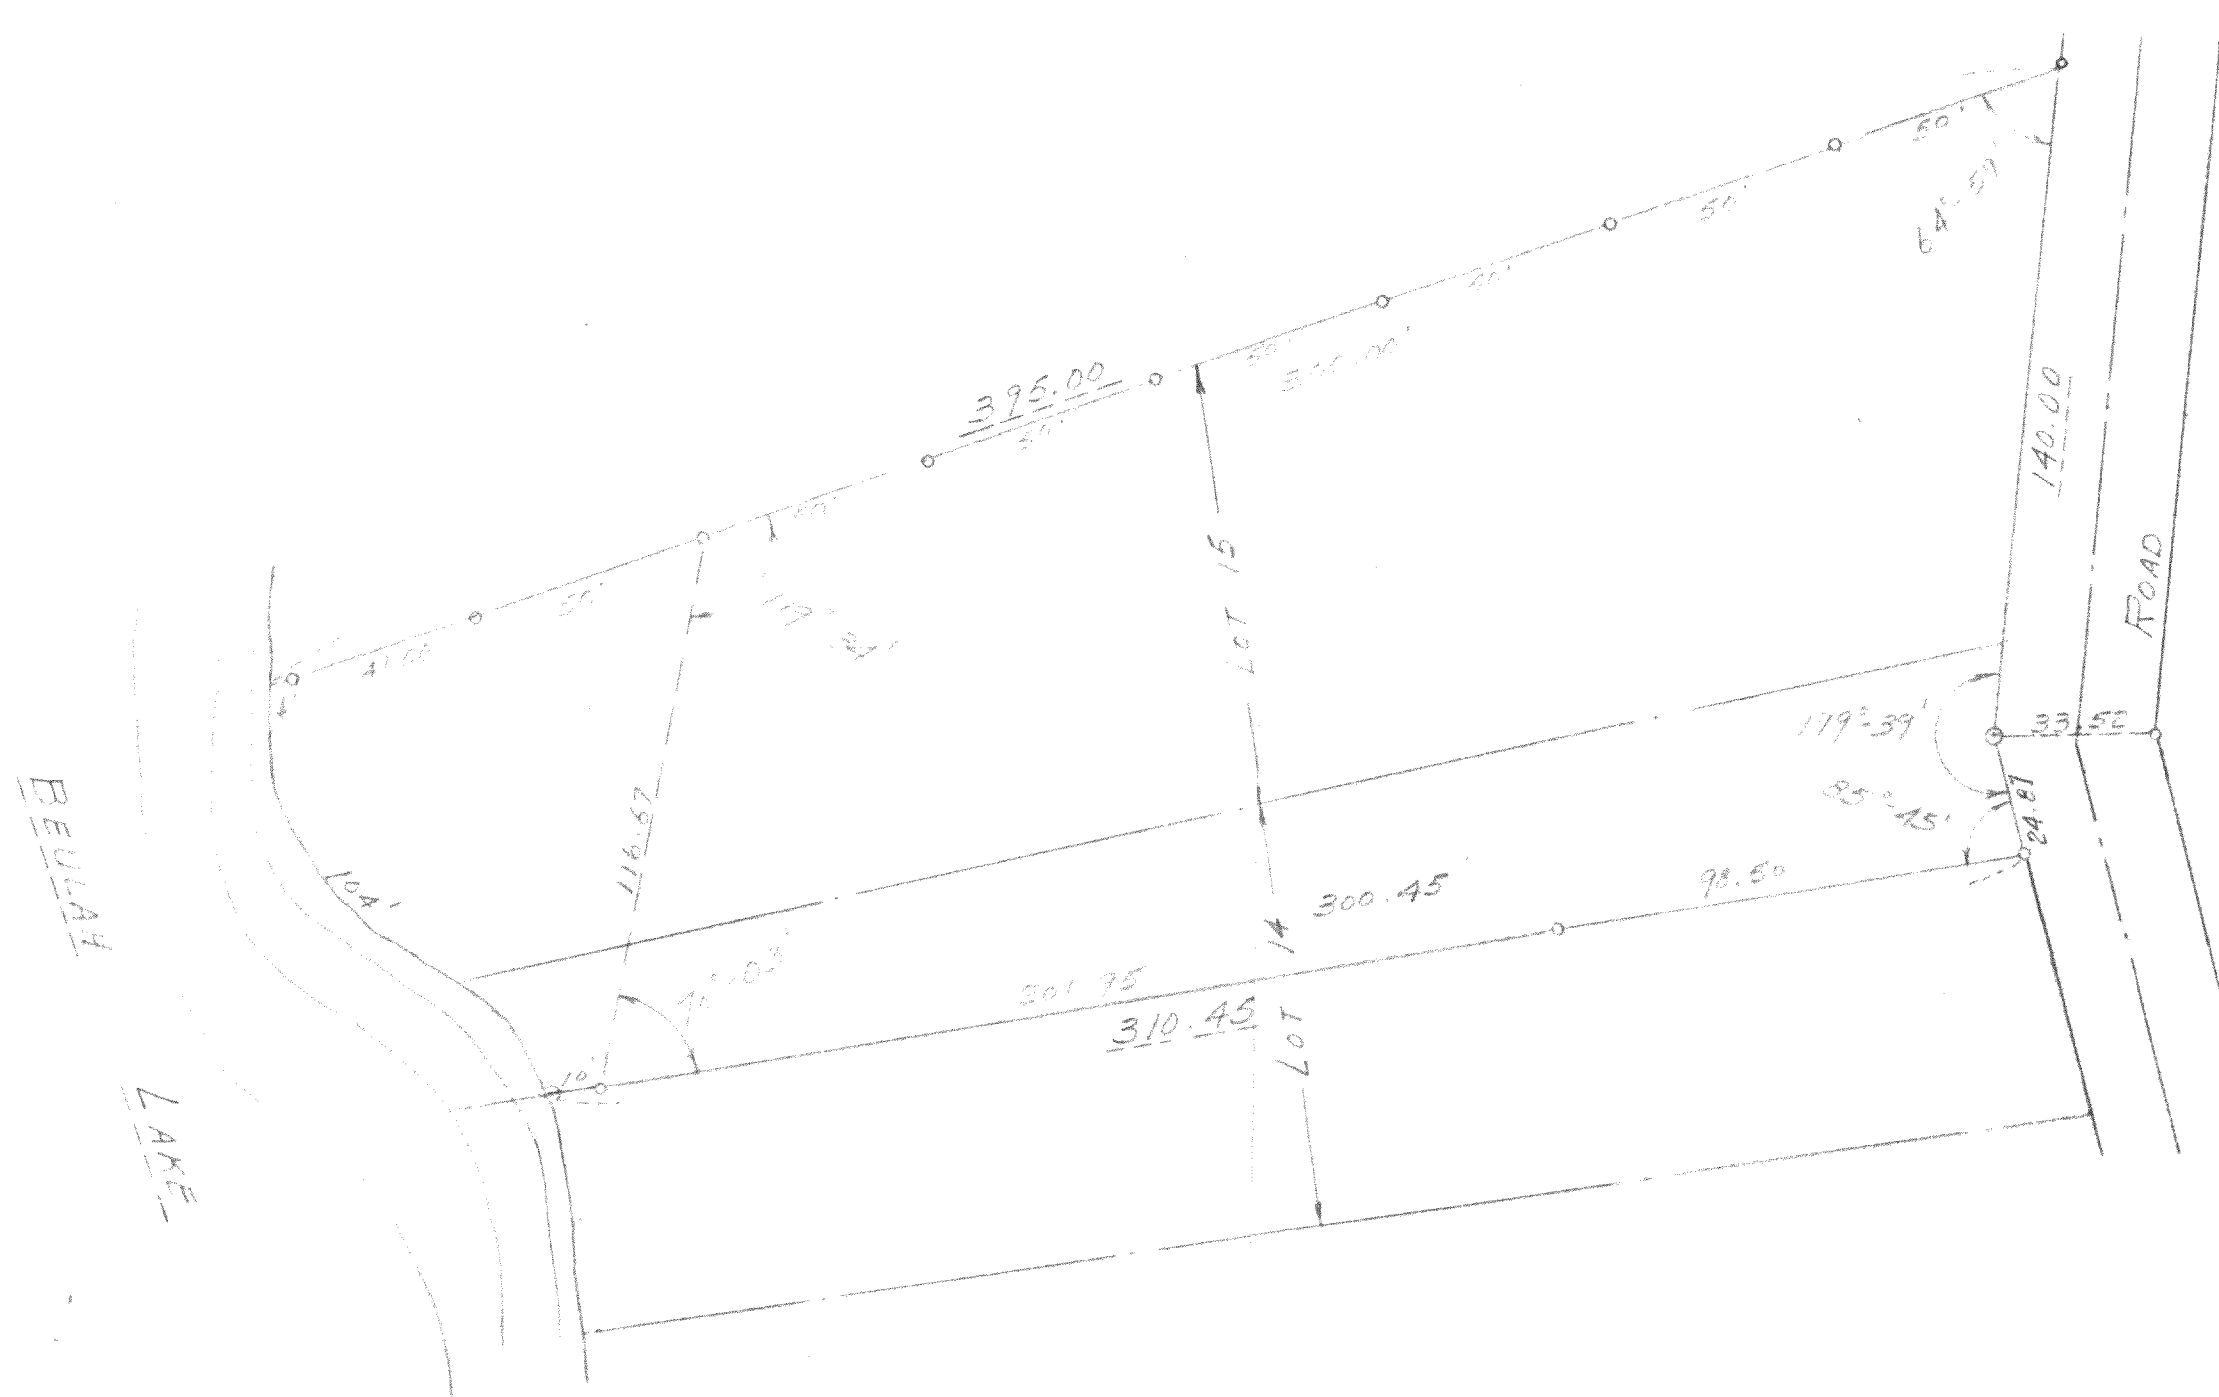

LEGEND

- IRON STAKE
- ⊙ CROSS CUT IN CONCRETE

PLAT OF SURVEY OF

LOT 15 AND PART OF LOT 14 OF BEULAH
LAKE PARK - LOCATED IN SECTION 4,
T4N, R18E, WALWORTH COUNTY, WISCONSIN.

Clyde Jensen
SURVEYOR

SCALE 1" = 40'

DATE SEPT 1964

Key No — PBL-16

418-109J