
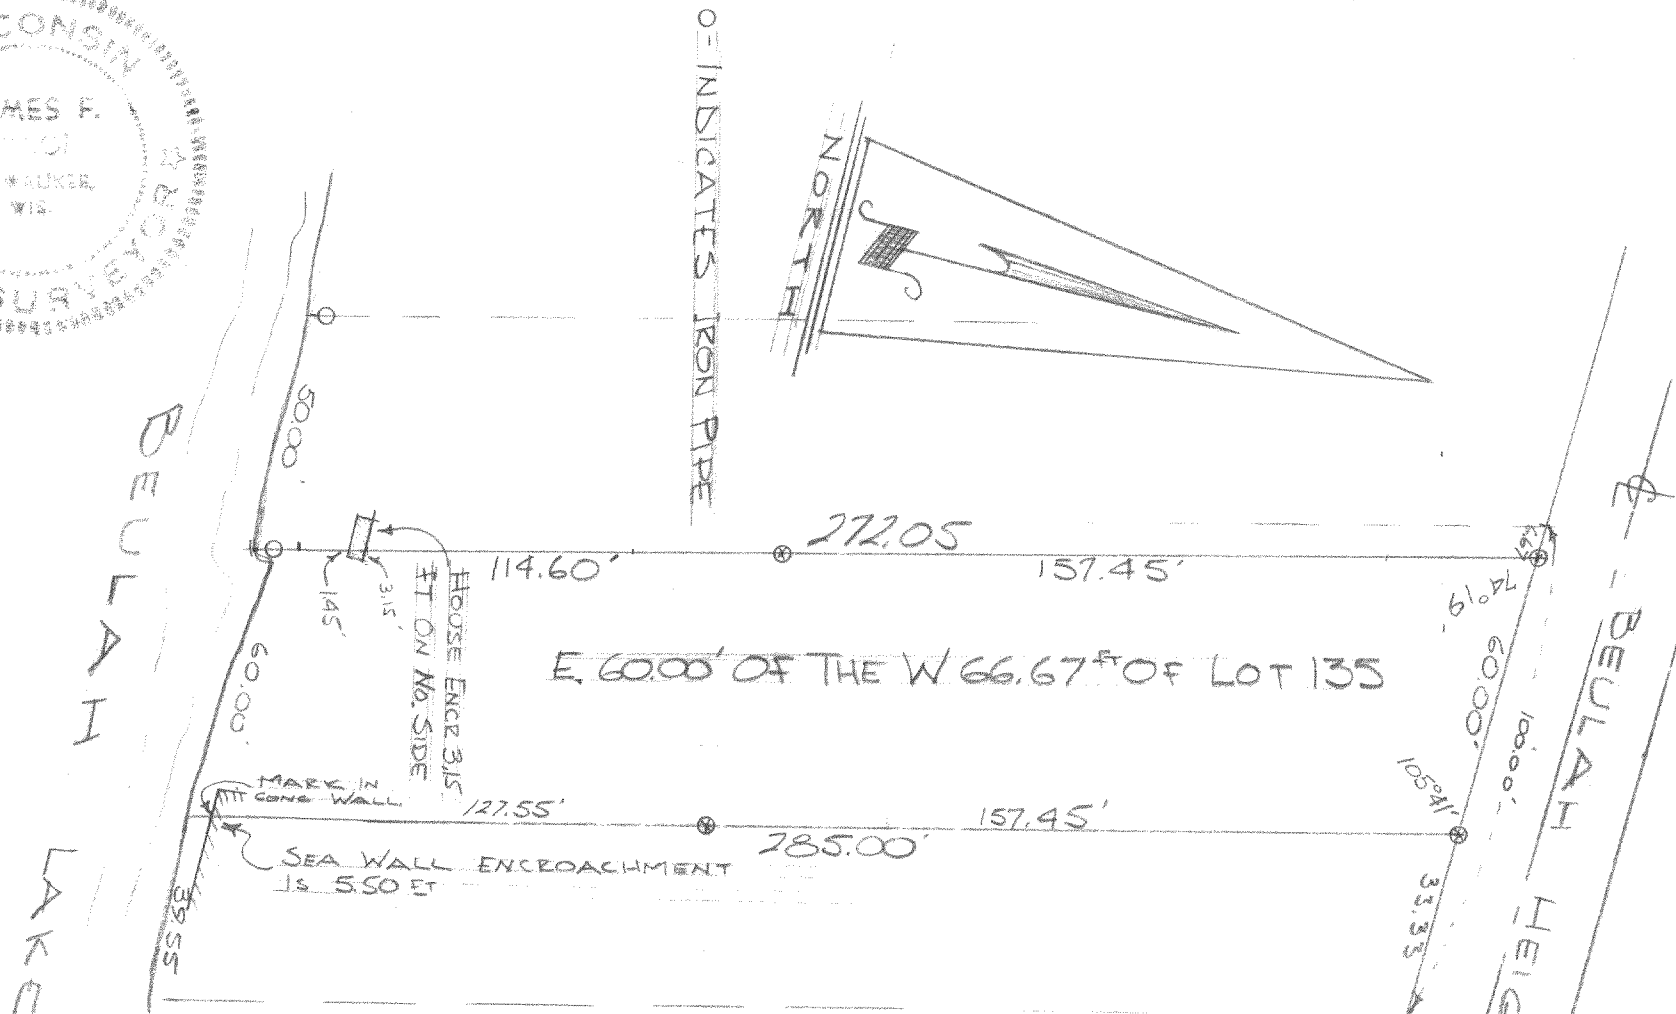


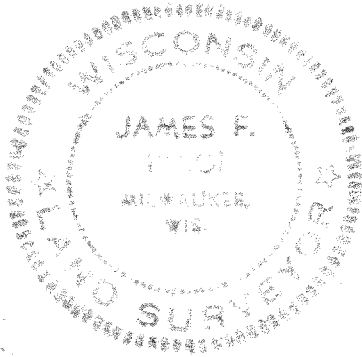


DESCRIPTION: The east 60 feet of the west 66.67 feet of Lot 135 Beulah Heights Subdivision of a portion of Sections 7, 8, 17 & 18; Town 4 north, Range 18 east, East Troy Township, Walworth County, Wisconsin.

CERTIFICATE: I, James F. Biagi, surveyor hereby certify that I have on this the 25th day of October, 1963, surveyed the above described property.

Date: October 28th 1963.

James F. Biagi
James F. Biagi, RLS 272
Elkhorn, Wisconsin.

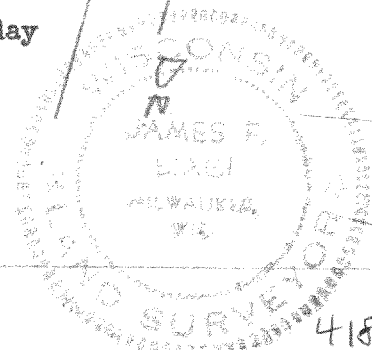

Key No. PBH-19A

418-112B

#126-63