


FOR: WM. & JANET KASKA
LOCATION: 1116 HUMPHREY LA.
LEGAL DESCRIPTION: LOT 6 IN THE PLAT OF BEULAH MANOR BEING A SUBDIVISION OF PART OF THE WEST 1/2 OF SECTION 9, T.4N., R. 18E., IN THE TOWN OF EAST TROY, WALWORTH CO., WISC.

FOR: WM. & JANET KASKA
LOCATION: 1116 HUMPHREY LA.

LEGAL DESCRIPTION: LOT 6 IN THE PLAT OF BEULAH MANOR BEING A SUBDIVISION OF PART OF THE WEST 1/2 OF SECTION 9, T. 4 N., R. 18 E., IN THE TOWN OF EAST TROY, WALWORTH CO., WISC.

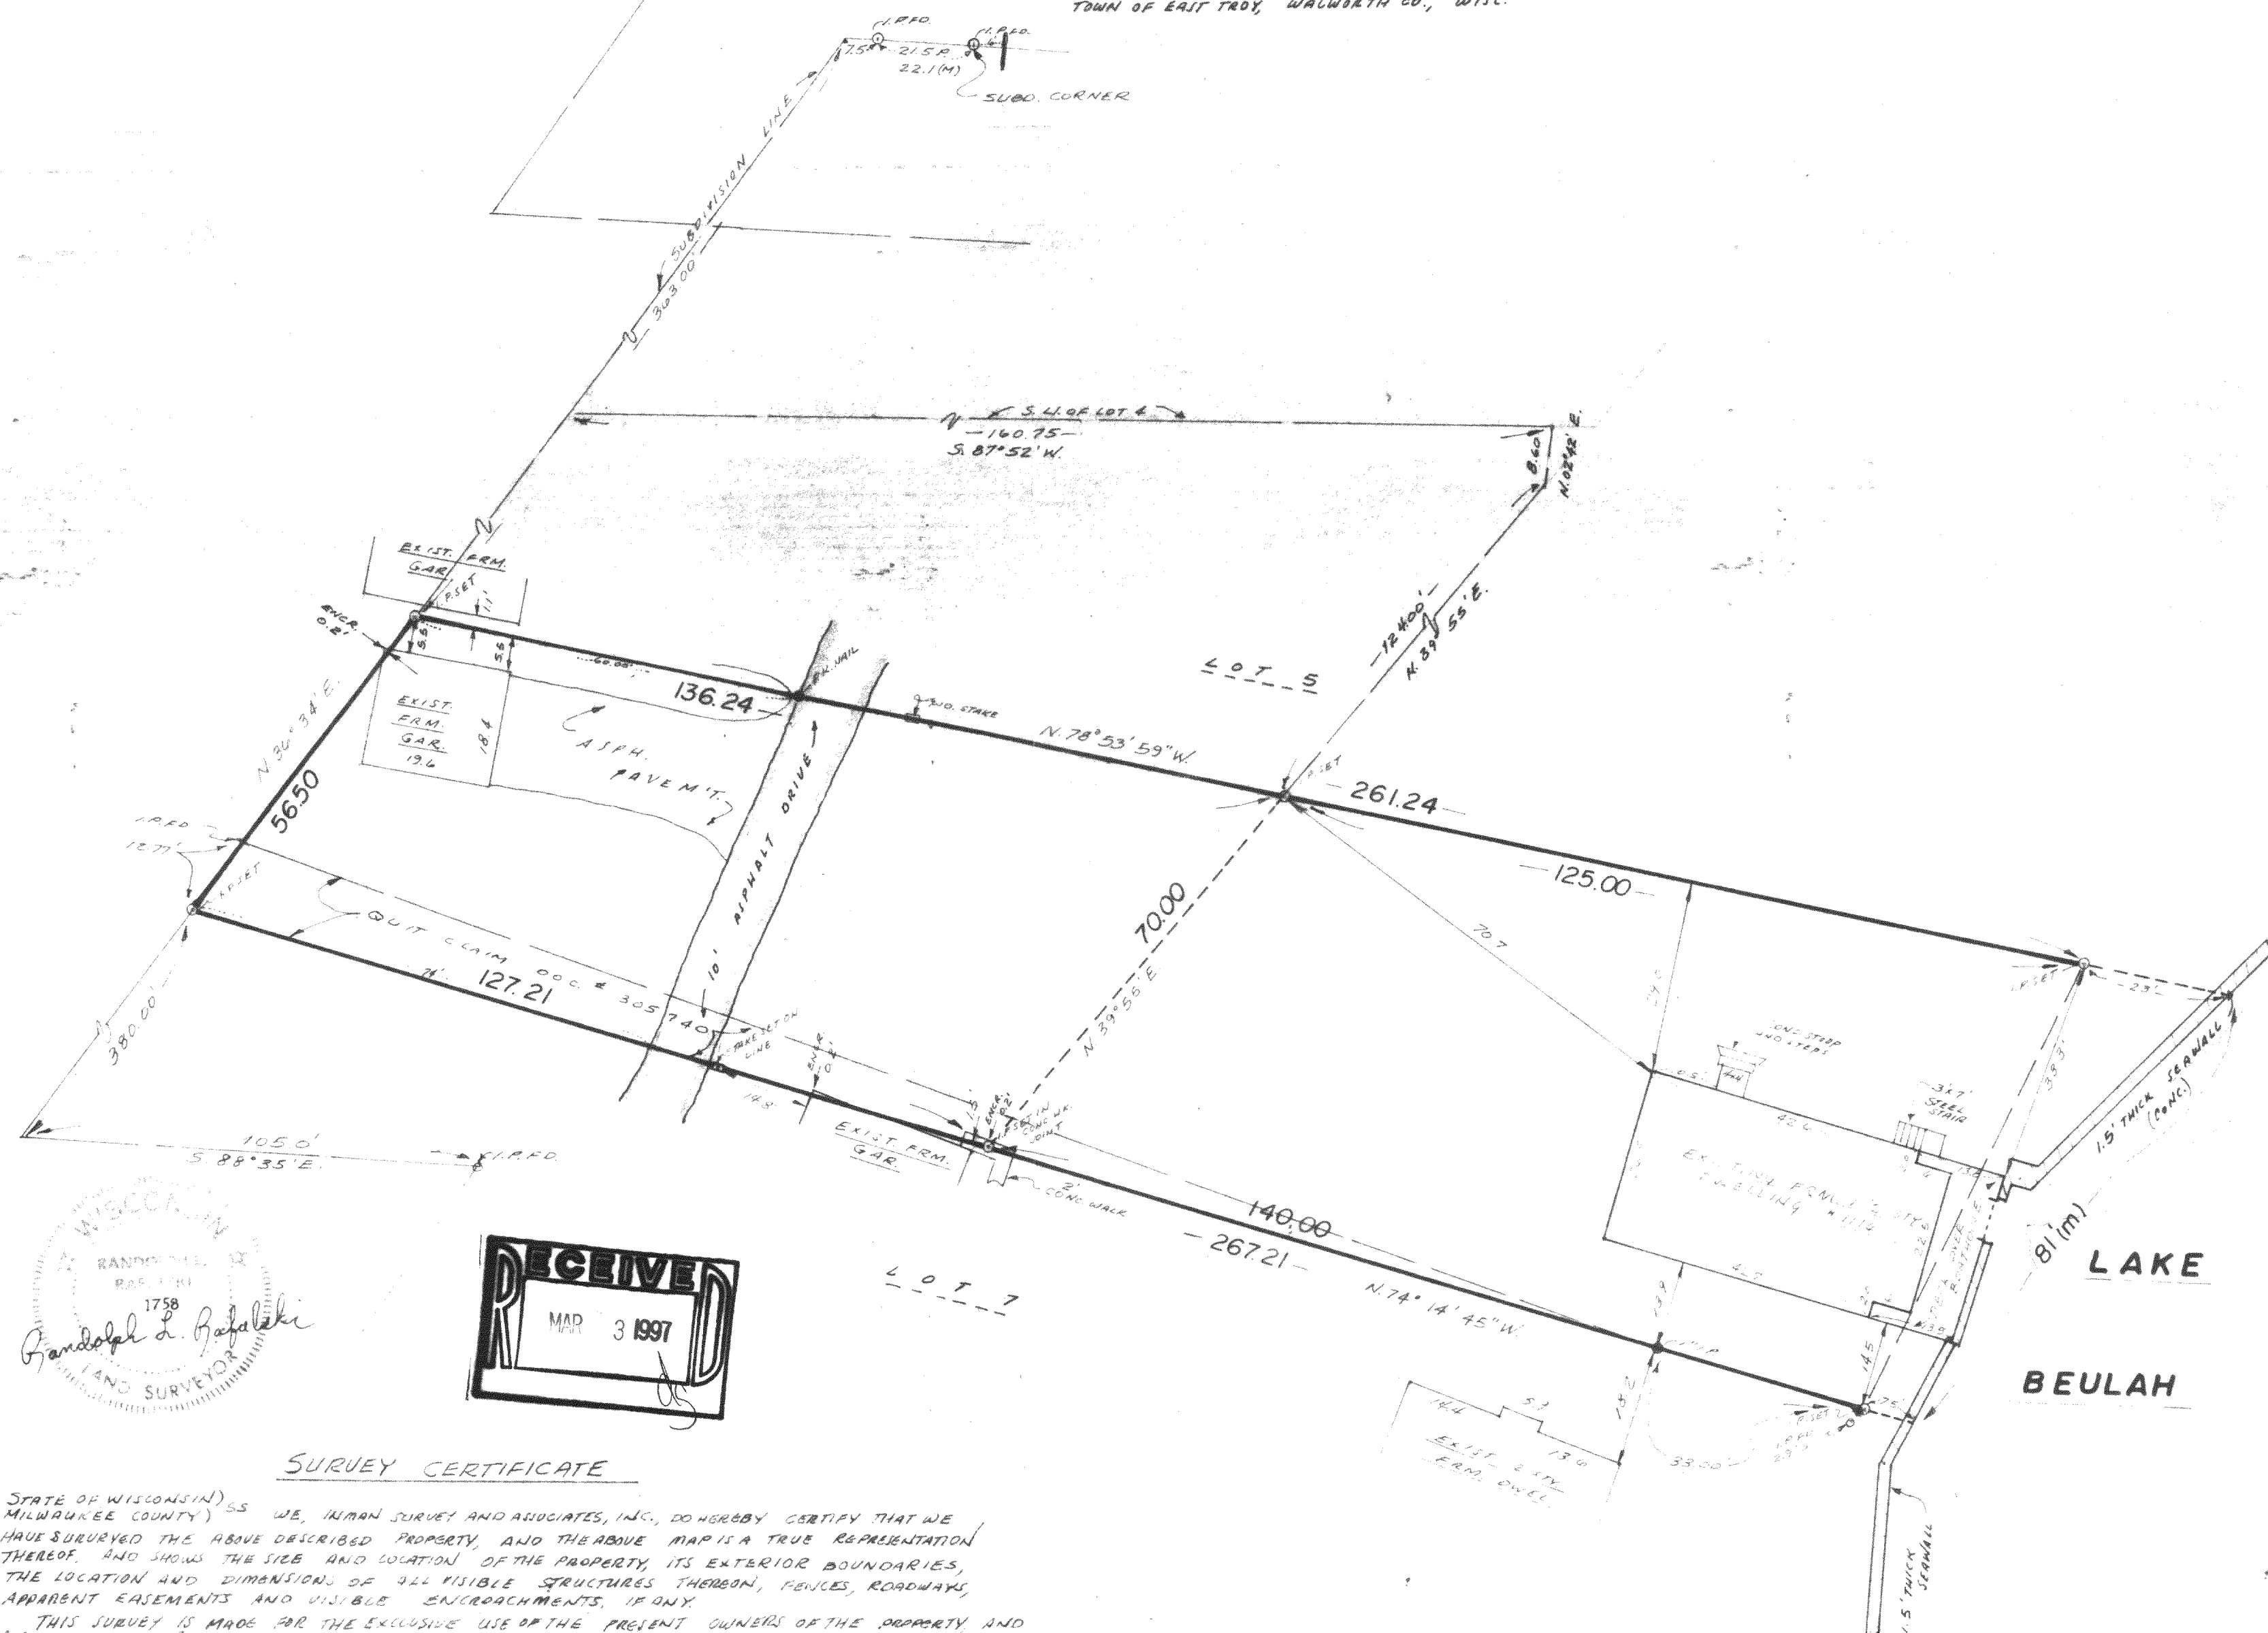

STATE OF WISCONSIN) SS WE, INMAN SURVEY AND ASSOCIATES, INC., DO HEREBY CERTIFY THAT WE
MILWAUKEE COUNTY) HAVE SURVEYED THE ABOVE DESCRIBED PROPERTY, AND THE ABOVE MAP IS A TRUE REPRESENTATION
THEREOF, AND SHOWS THE SIZE AND LOCATION OF THE PROPERTY, ITS EXTERIOR BOUNDARIES,
THE LOCATION AND DIMENSIONS OF ALL VISIBLE STRUCTURES THEREON, FENCES, ROADWAYS,
APPARENT EASEMENTS AND VISIBLE ENCROACHMENTS, IF ANY.

THIS SURVEY IS MADE FOR THE EXCLUSIVE USE OF THE PRESENT OWNERS OF THE PROPERTY AND
ALSO THOSE WHO PURCHASE, MORTGAGE, OR GUARANTEE THE TITLE THERETO, WITHIN ONE (1) YEAR
FROM DATE HEREOF.

REV. 12-12-76
DATED 8-23-84
JOB NO 11411

PBM-5
418-1142