
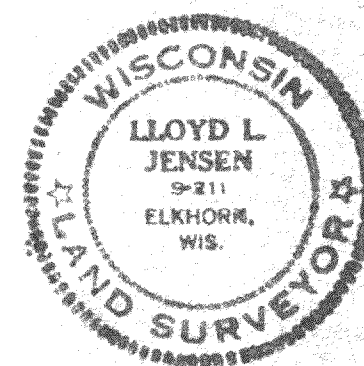


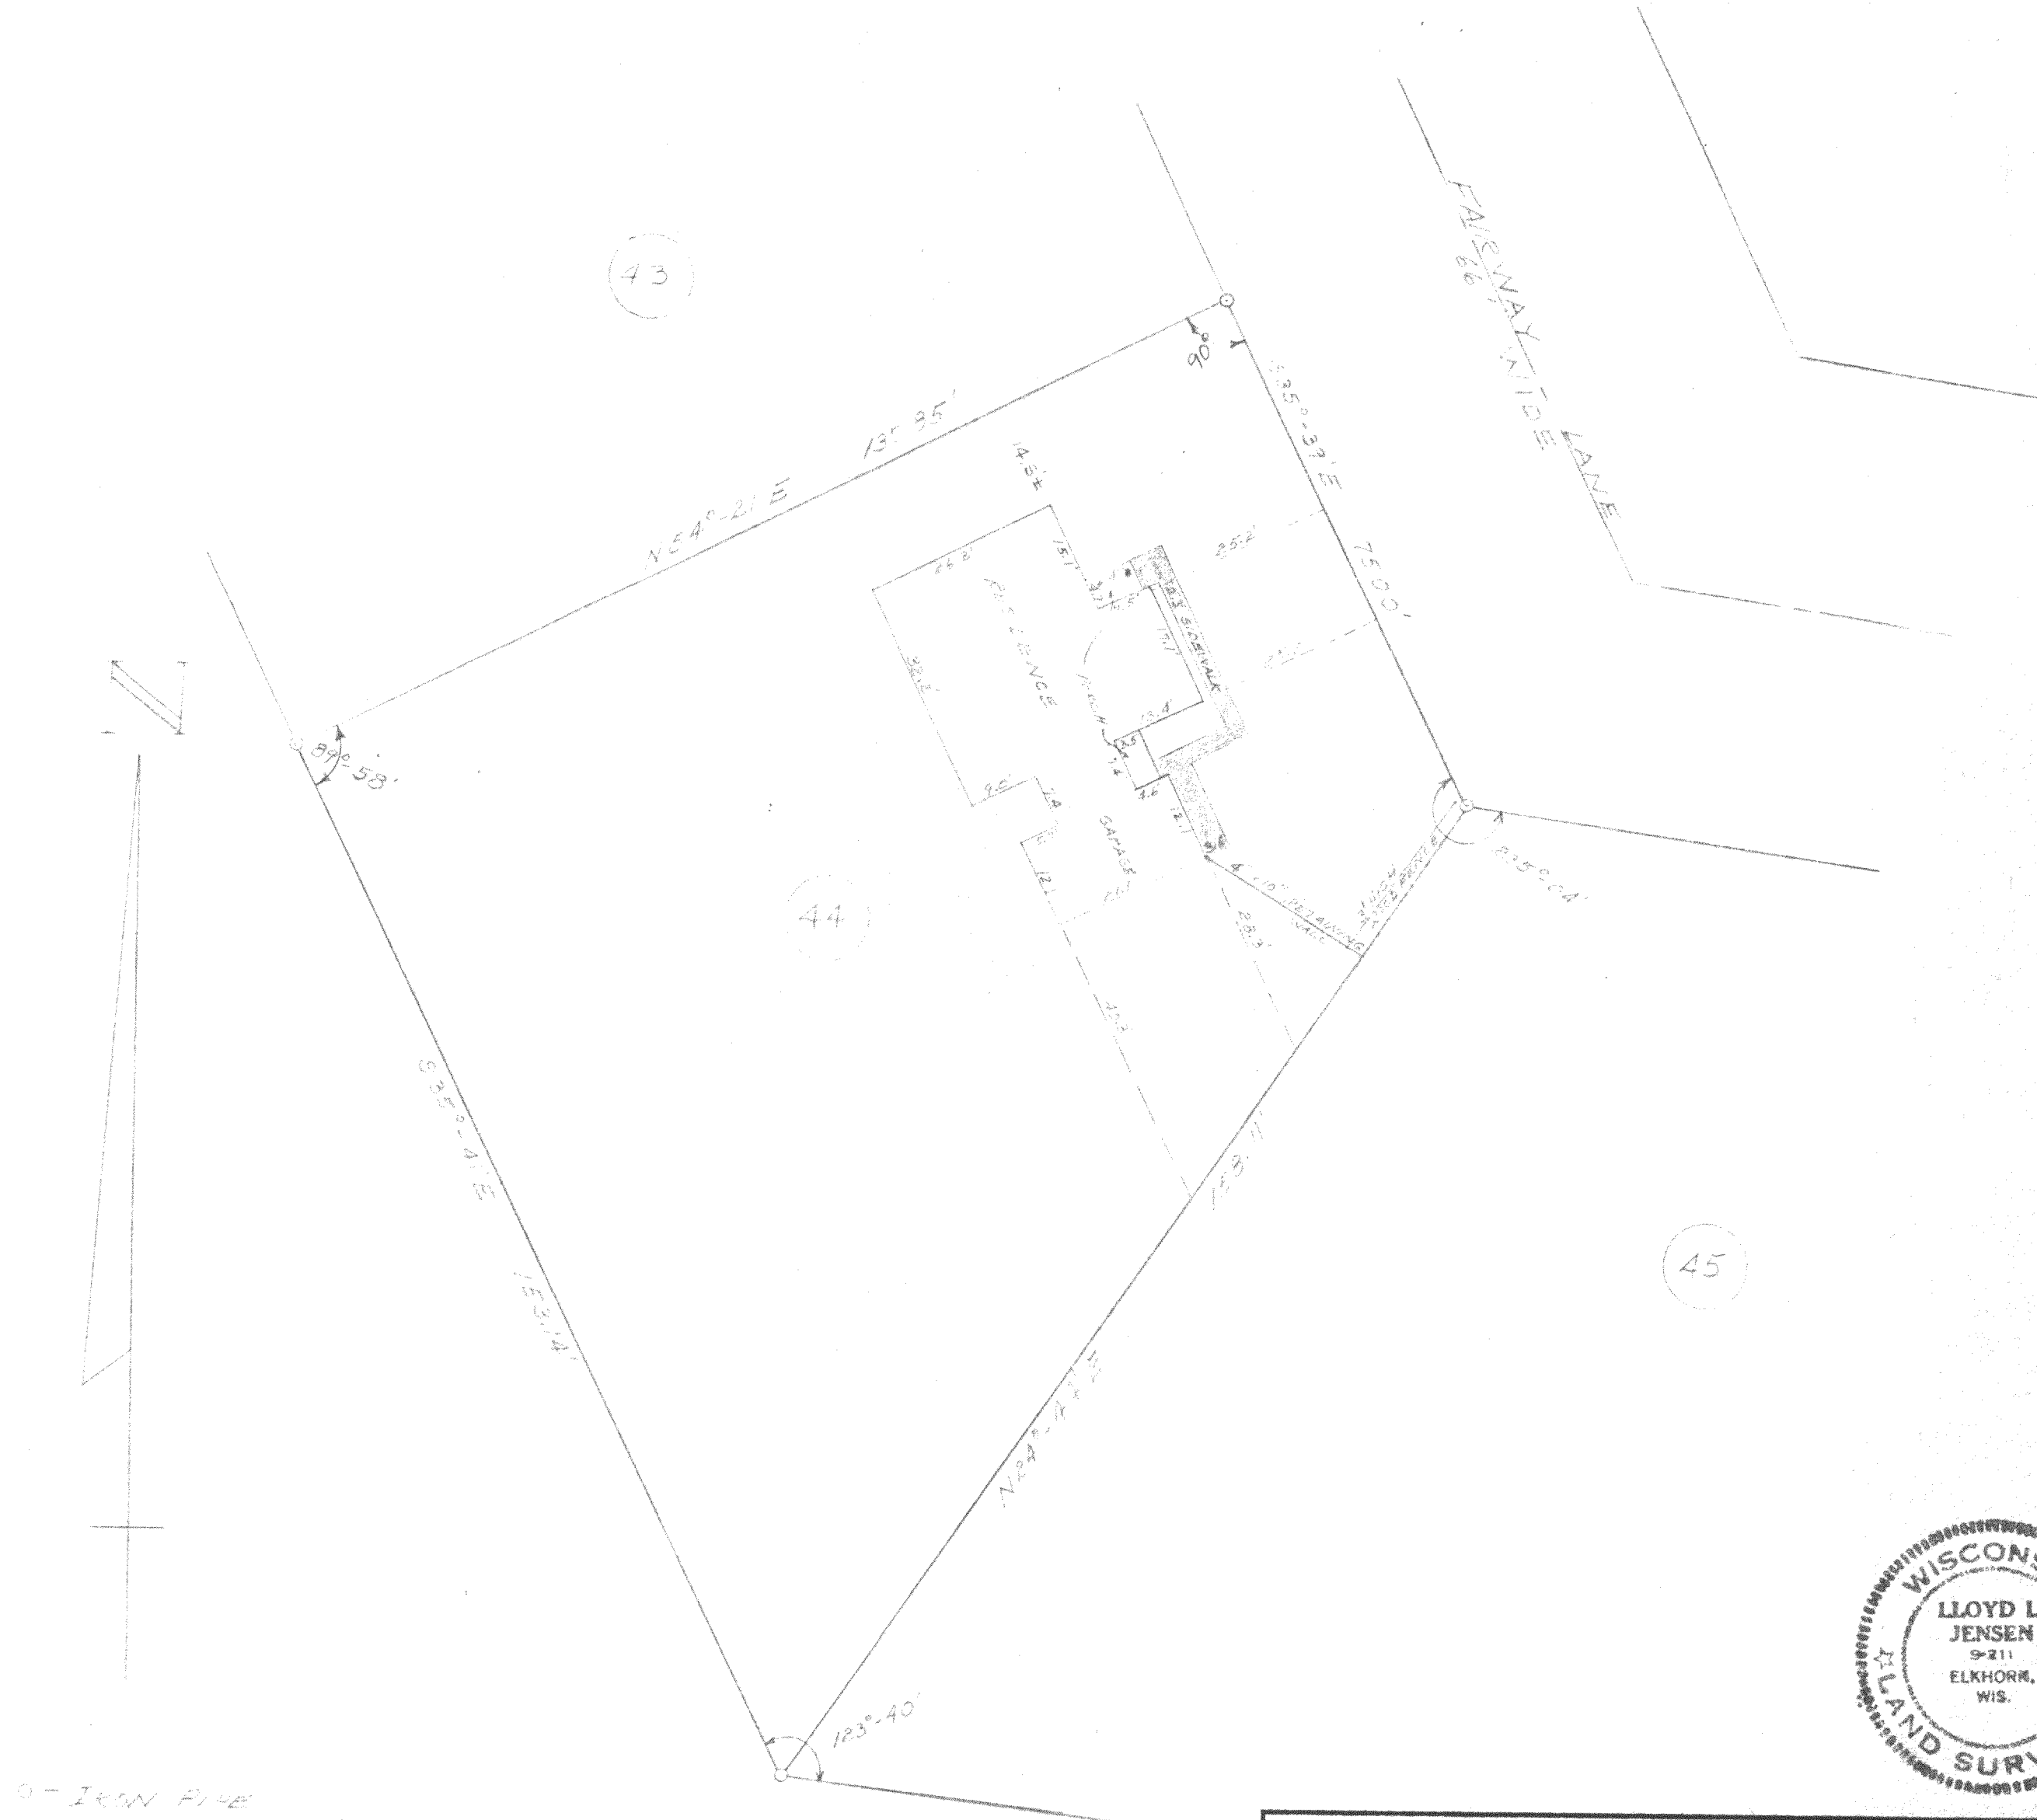

PLAT OF SURVEY OF

LOT 44 FAIRWAY SUBDIVISION BEING A RESUBDIVISION
OF WILLIAMS PARK SUBDIVISION, LOCATED IN THE
SW 1/4 NW 1/4 AND THE SE 1/4 NW 1/4 OF SECTION 4,
T4N R18E, WALWORTH COUNTY, WISCONSIN.

Lloyd L. Jensen
SURVEYOR

I certify that I have surveyed the property described hereon and that the above plat
is an accurate survey and a true representation thereof and correctly shows the exterior
boundary lines and location of buildings and other improvements on said property and the
correct measurements thereof.

Dated this 12th day of August 1964.

Lloyd L. Jensen
Lloyd L. Jensen, Surveyor