


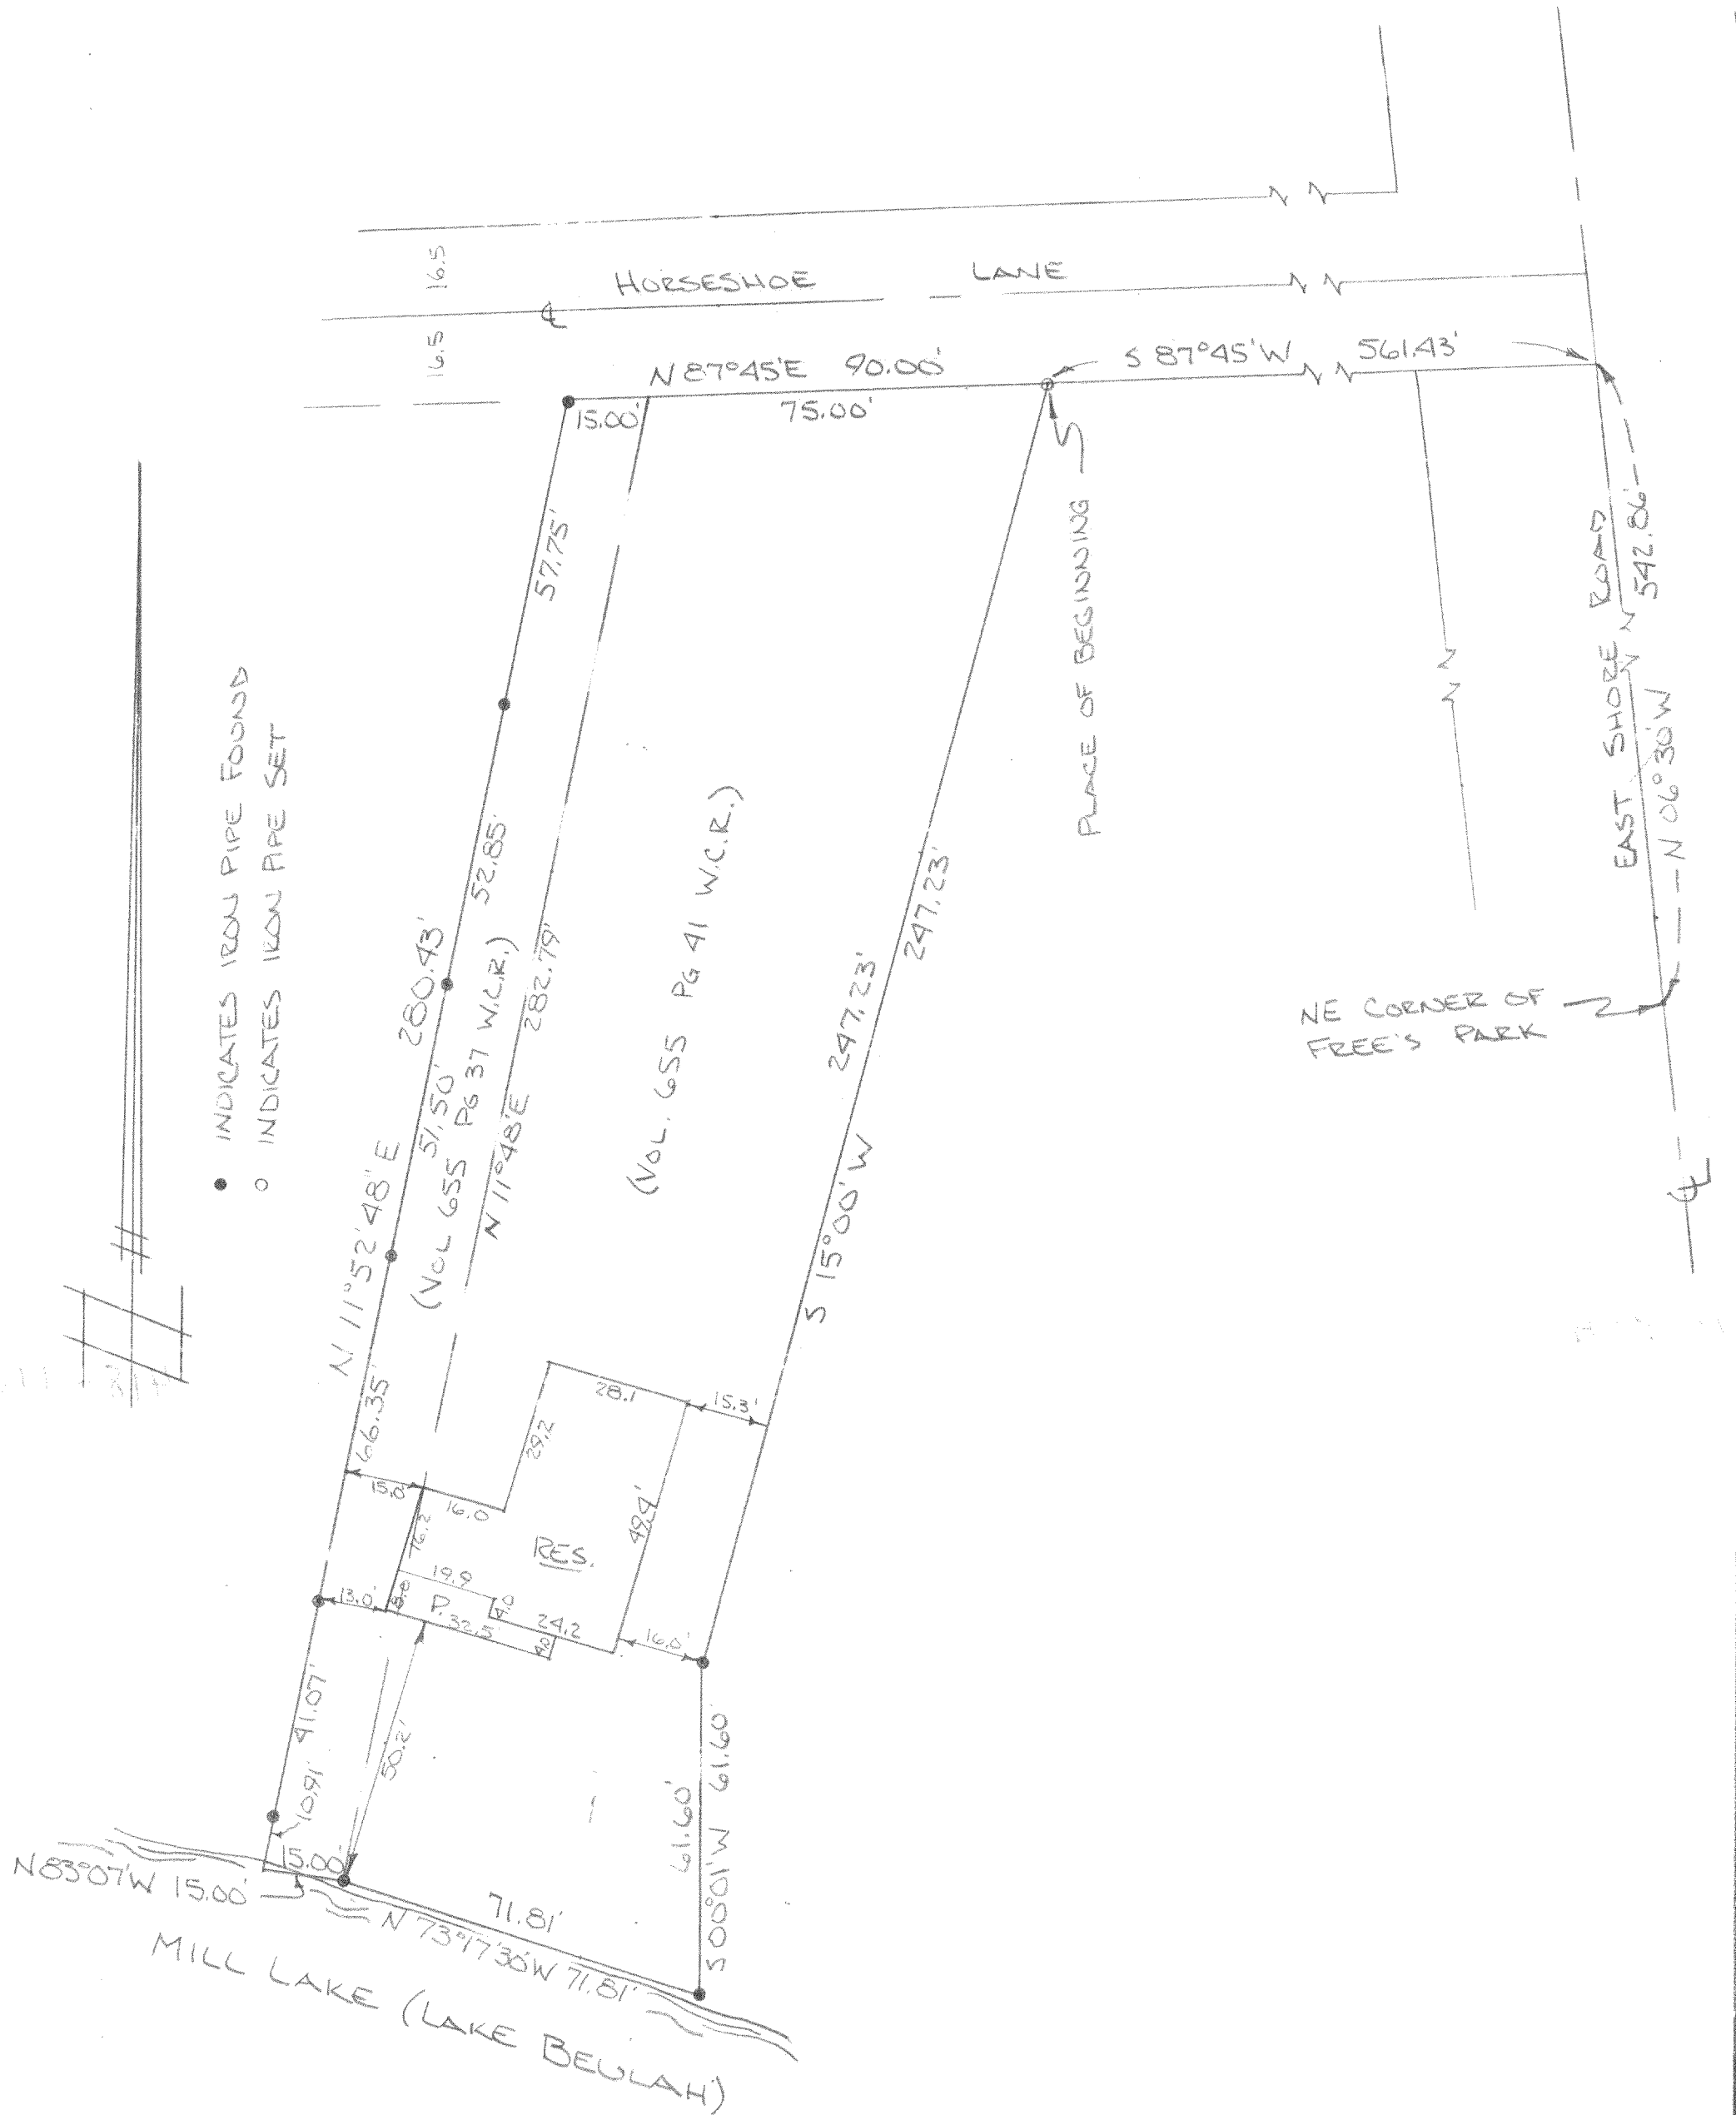

DESCRIPTION:

Commencing at the NE corner of Free's Park, a subdivision located in Section 4, T4N, R18E, Walworth County, Wisconsin; thence N 6°30' W 542.86 feet along the centerline of East Shore Road, thence S 87°45' W 561.43 feet along the South line of Horseshoe Lane to the Place of Beginning of the lands hereinafter described to-wit: Thence S 15°00' W 247.23 feet, thence S 00°01' W 61.60 feet to the shore of Mill Lake (Lake Beulah), thence N 73°17'30" W 71.81 feet along said shore, thence N 83°07' W 15.00 feet along said shore, thence N 11°52'48" E 280.43 feet to a point in the South line of aforementioned Horseshoe Lane, thence N 87°45' E 90.00 feet along said South road line to the Place of Beginning, containing 0.54 acres of land, more or less.

CERTIFICATE:

CERTIFICATE. I, Joseph M. Biagi, surveyor, do hereby certify that I have surveyed the lands here-
on described.

DATE:

August 7, 1973

~~Joseph M. Biagi
Elkhorn, Wisconsin~~

RLS #12