


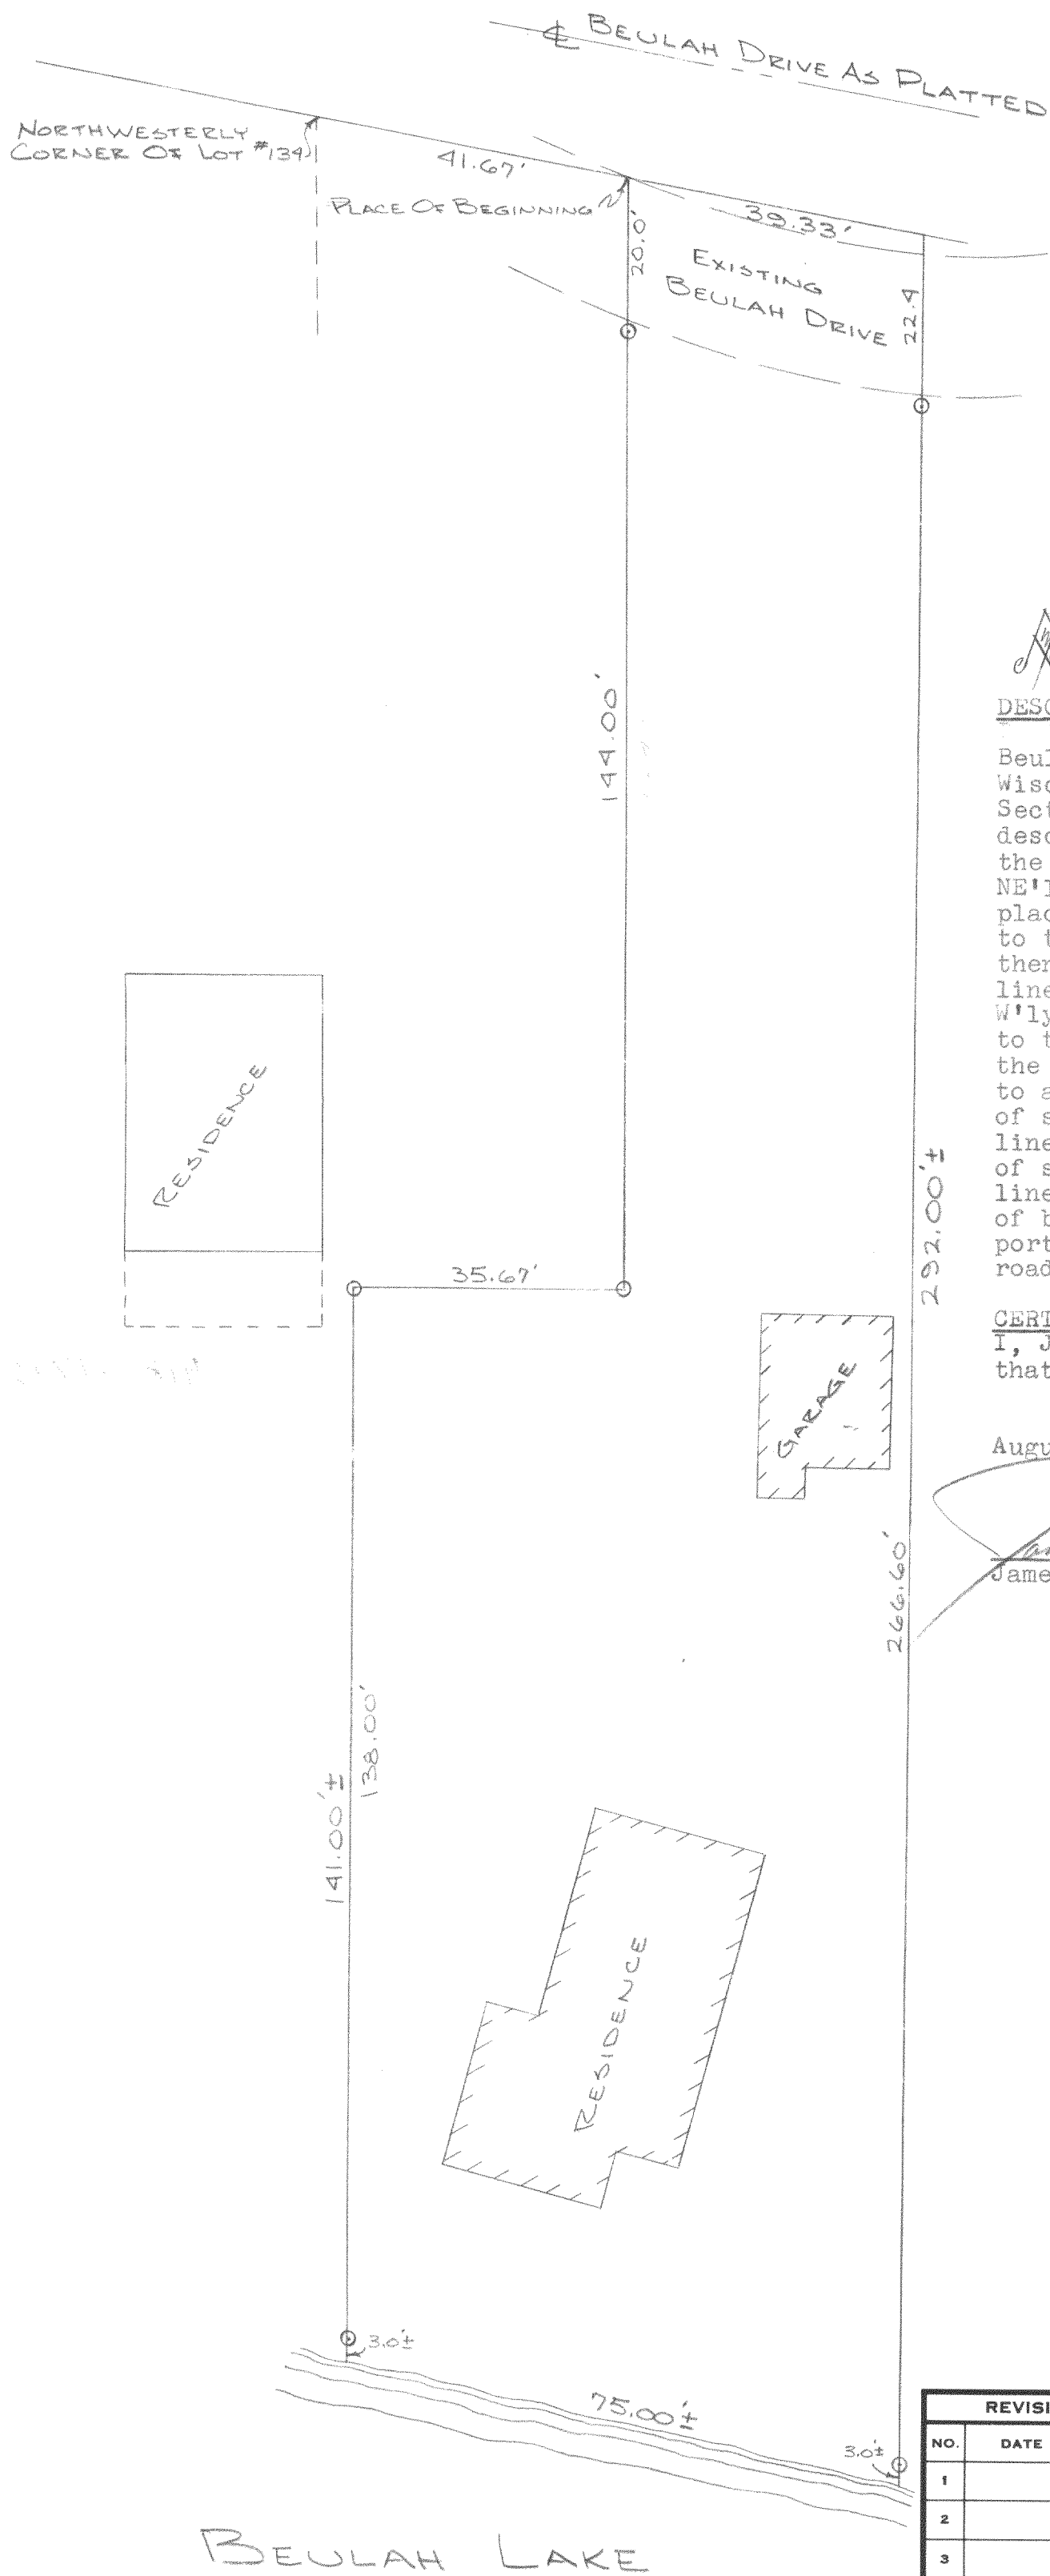

O-INDICATES IRON PIPE

DESCRIPTION:

Part of Lot 134 of the Plat of Beulah Heights Subdivision, Walworth County, Wisconsin, which subdivision is located in Sections 7, 8, 17, and 18, of T4N, R18E, described as follows, to-wit: Commencing at the NW'ly corner of said Lot 134; thence NE'ly along the Lot line 41.67 feet to the place of beginning; thence SE'ly parallel to the W'ly line of said Lot 134, 144 feet; thence W'ly at right angles to the last mentioned line 35.67 feet; thence SE'ly parallel to the W'ly line of said Lot 134, 141 feet more or less to the shore of Beulah Lake; thence NE'ly along the shore of Beulah Lake 75 feet more or less to a point on the East line of the W'ly 81 feet of said Lot 134; thence NW'ly along said East line 292 feet more or less to the N'ly line of said Lot 134; thence SW'ly along the N'ly line of said Lot 134, 39.33 feet to the place of beginning, except the extreme Northern portion of said land that is occupied by a roadway recorded as Beulah Drive.

CERTIFICATE:

I, James F. Biagi, surveyor, do hereby certify that I have surveyed the lands hereon described.

August 26, 1971

Revised Feb. 23, 1972

James F. Biagi

R.L.S. 272



ENGINEERS ASSOCIATED, INC.

100 NORTH STREET
MILWAUKEE, WISCONSIN 53201

REVISIONS					
NO.	DATE	BY			
1					
2					
3			DRAWN BY	SCALE	MATERIAL
4			CHK'D	DATE	DRAWING NO.
5			TRACED	APP'D	