


4121.05.02

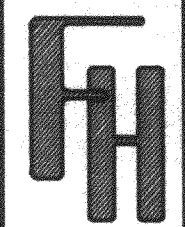

SITE GRADING & EROSION
CONTROL PLAN
TOWN OF EAST TROY
WALWORTH COUNTY, WI.

WORK ORDERED BY: JOHN THEISEN
PO BOX 1385
WAUKESHA, WI. 53187



FARRIS, HANSEN & ASSOCIATES, INC.
Engineering, Architecture, Surveying
7 Ridgway Court P.O. Box 437
ELKHORN, WISCONSIN 53121
Office: (414) 723-2098
Fax: (414) 723-5886

REVISIONS
05-19-97 SLD
SOIL ABSORP.
NOTES, HOUSE


PROJECT NO.
4121.05-2
DATE:
05/05/97
SHEET NO.
1 OF 1

PLAT OF SURVEY

LOT 5 OF BLOCK 2 OF CLEARVIEW
A SUBDIVISION LOCATED IN SECTION
18, TOWN 4 NORTH, RANGE 18 EAST,
WALWORTH COUNTY, WISCONSIN

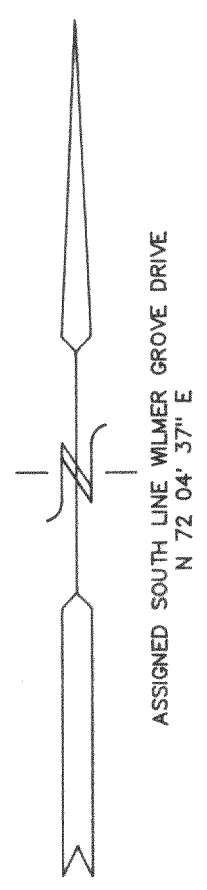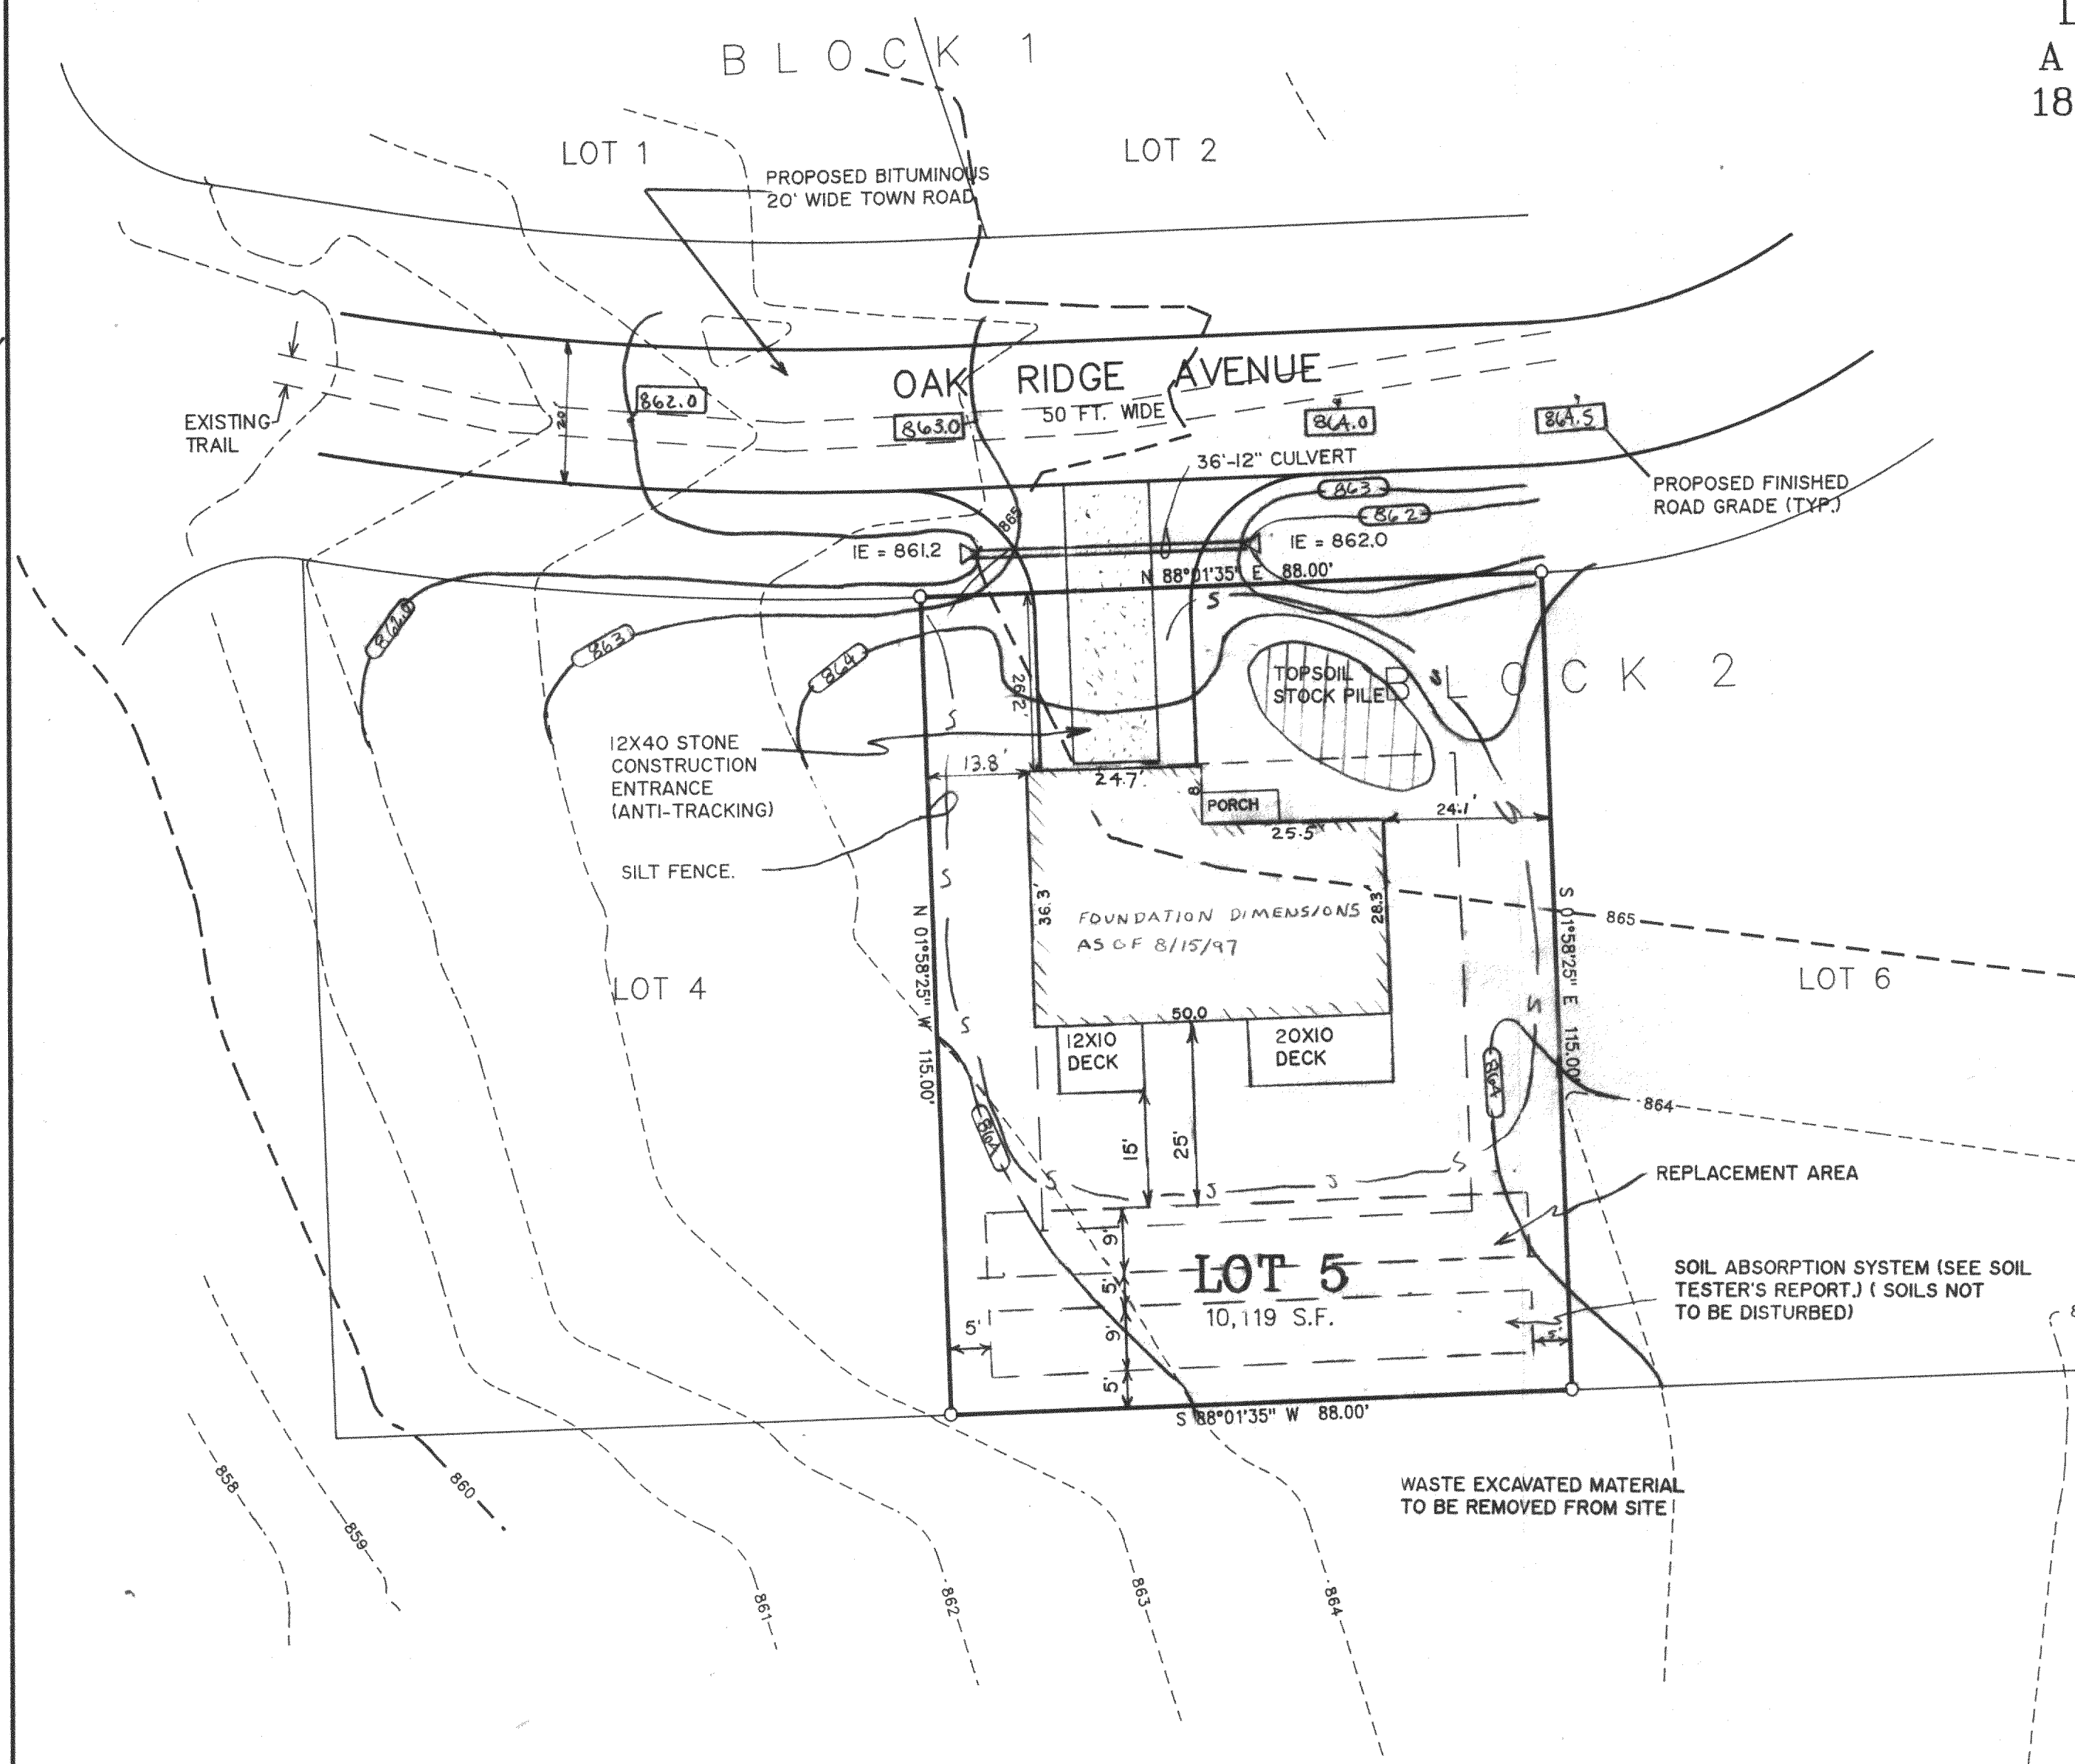

O = FOUND IRON PIPE STAKE
(XXX) = RECORDED AS

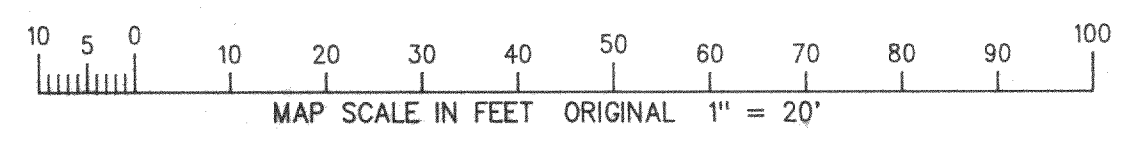


NOTE: COPIES OF THIS MAP TO WHICH THE FOLLOWING CERTIFICATE WILL APPLY ARE BLUE LINE PRINTS SHOWING SURVEYOR'S ORIGINAL SEAL AND SIGNATURE IN BLACK INK. COPIES BY ANY OTHER MEANS MAY HAVE ALTERATIONS WHICH DO NOT REPRESENT THE SURVEYOR'S WORK PRODUCT.

I HEREBY CERTIFY THAT THE ABOVE DESCRIBED PROPERTY HAS BEEN SURVEYED UNDER MY DIRECTION AND THAT THE ABOVE MAP IS A TRUE REPRESENTATION THEREOF AND SHOWS THE SIZE AND LOCATION OF THE PROPERTY AND ITS EXTERIOR BOUNDARIES. THIS SURVEY IS MADE FOR THE USE OF THE PRESENT OWNERS OF THE PROPERTY, AND ALSO THOSE WHO PURCHASE, MORTGAGE, OR GUARANTEE THE TITLE THERETO WITHIN ONE YEAR FROM THE DATE HEREOF.

DATED: 05/05/97

Peter S. Gordon
PETER S. GORDON R.L.S. 2101
REV. 05/19/97
REV. 8/15/97

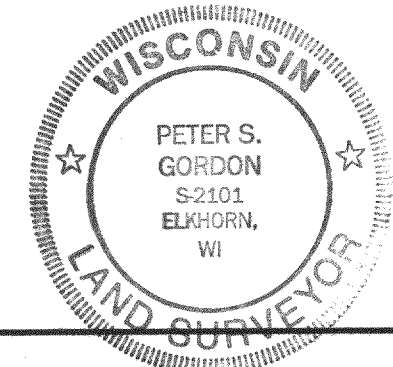

PCV-16 418-1185