
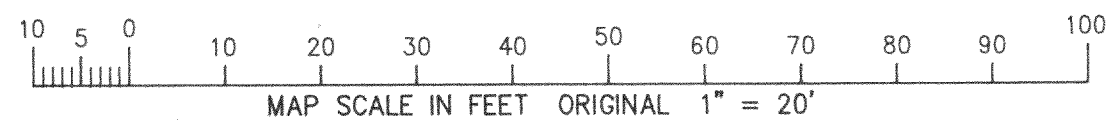




PLAT OF SURVEY  
 LOT 5 OF BLOCK 1 OF  
 CLEARVIEW  
 A SUBDIVISION LOCATED IN  
 SEC. 18, T4N, R18E  
 WALWORTH COUNTY, WISCONSIN

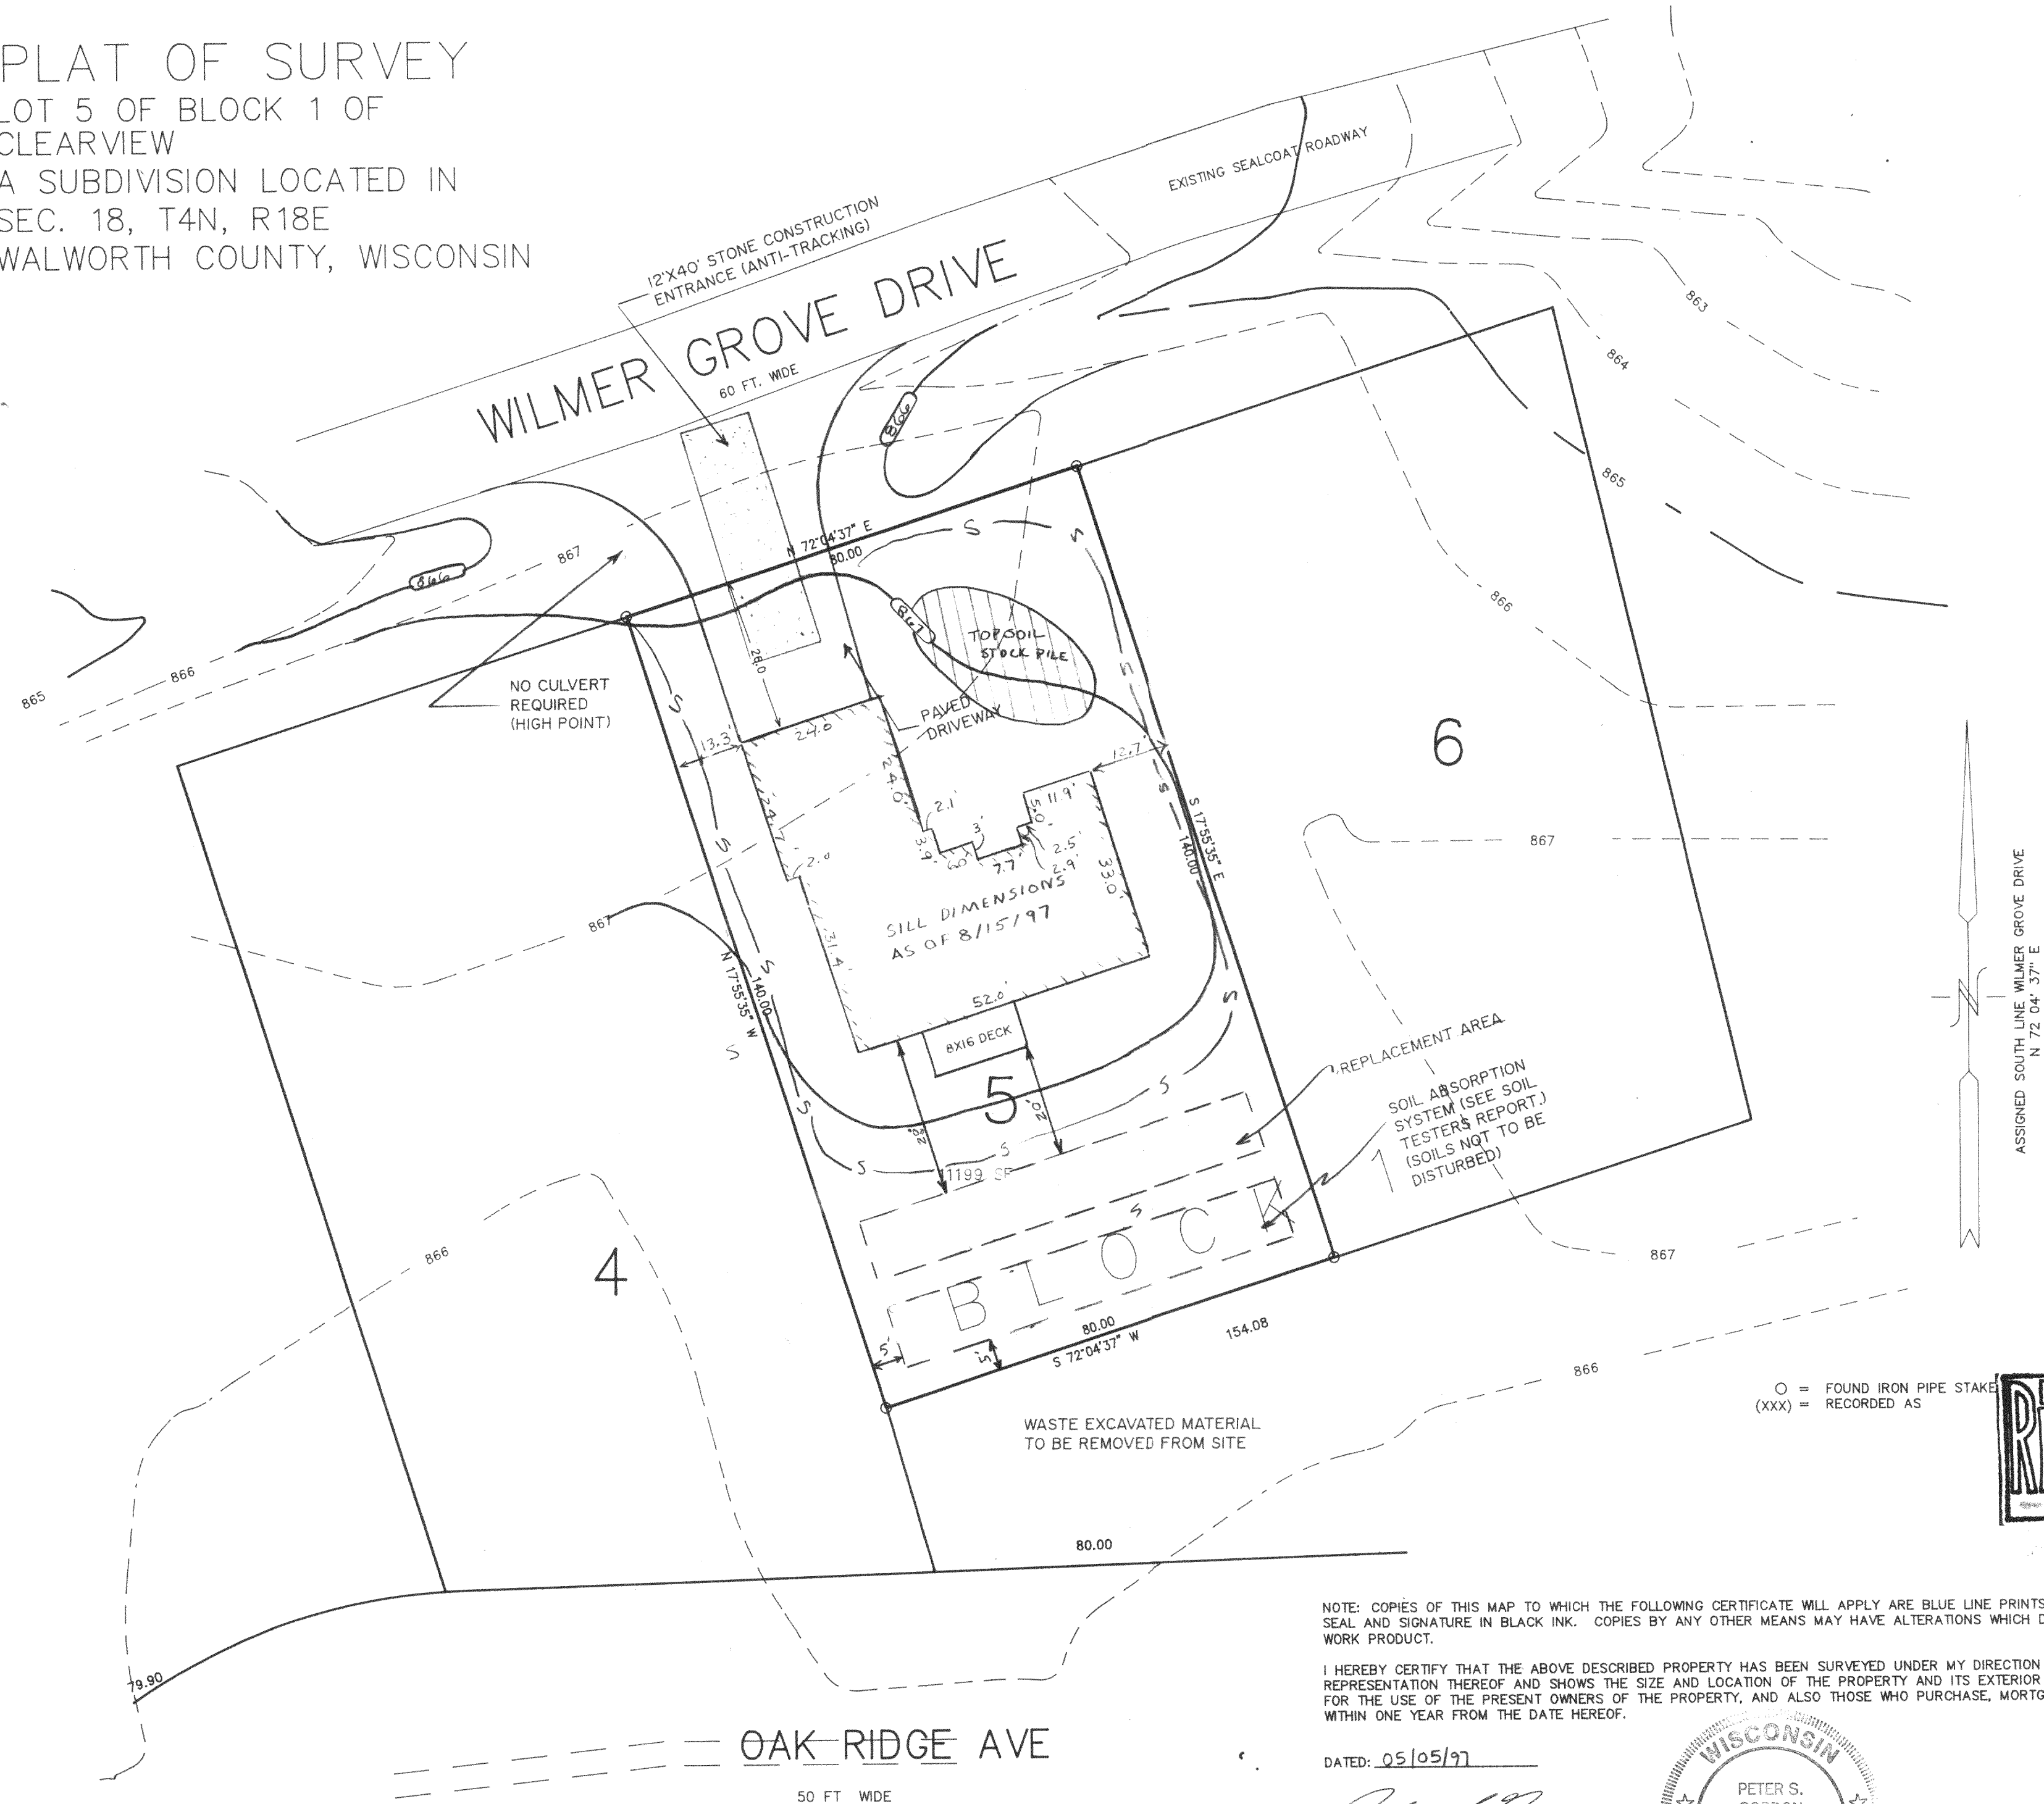

NOTE: COPIES OF THIS MAP TO WHICH THE FOLLOWING CERTIFICATE WILL APPLY ARE BLUE LINE PRINTS SHOWING SURVEYOR'S ORIGINAL SEAL AND SIGNATURE IN BLACK INK. COPIES BY ANY OTHER MEANS MAY HAVE ALTERATIONS WHICH DO NOT REPRESENT THE SURVEYOR'S WORK PRODUCT.

I HEREBY CERTIFY THAT THE ABOVE DESCRIBED PROPERTY HAS BEEN SURVEYED UNDER MY DIRECTION AND THAT THE ABOVE MAP IS A TRUE REPRESENTATION THEREOF AND SHOWS THE SIZE AND LOCATION OF THE PROPERTY AND ITS EXTERIOR BOUNDARIES. THIS SURVEY IS MADE FOR THE USE OF THE PRESENT OWNERS OF THE PROPERTY, AND ALSO THOSE WHO PURCHASE, MORTGAGE, OR GUARANTEE THE TITLE THERETO WITHIN ONE YEAR FROM THE DATE HEREOF.

DATED: 05/05/97  
 PETER S. GORDON R.L.S. 2101  
 REV. 5-7-97  
 REV. 5-14-97  
 REV. 8-15-97

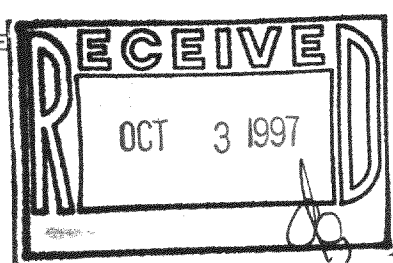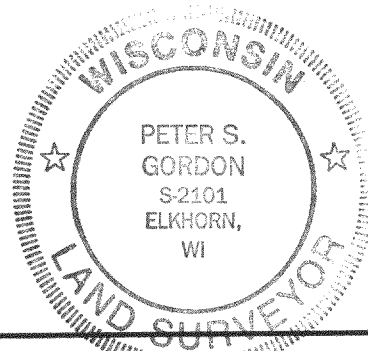

|                                                                                                                                                                                        |                                                                                     |
|----------------------------------------------------------------------------------------------------------------------------------------------------------------------------------------|-------------------------------------------------------------------------------------|
|                                                                                                                                                                                        | SITE GRADING & EROSION<br>CONTROL PLAN<br>TOWN OF EAST TROY<br>WALWORTH COUNTY, WI. |
|                                                                                                                                                                                        | WORK ORDERED BY: JOHN THEISEN<br>PO BOX 1385<br>WAUKESHA, WI. 53187                 |
| FARRIS, HANSEN & ASSOCIATES, INC.<br>Engineering, Architecture, Surveying<br>7 Ridgway Court P.O. Box 437<br>ELKHORN, WISCONSIN 53121<br>Office: (414) 723-2098<br>Fax: (414) 723-5886 |                                                                                     |
| REVISIONS<br>REV. NOTES<br>SILT FENCE<br>DECK<br>SOIL ABOR.<br>05/14/97 BLD                                                                                                            |                                                                                     |
| PROJECT NO.<br>4121                                                                                                                                                                    |                                                                                     |
| DATE:<br>5-02-97                                                                                                                                                                       |                                                                                     |
| SHEET NO.<br>1 OF 1                                                                                                                                                                    |                                                                                     |

4/21.05.01