
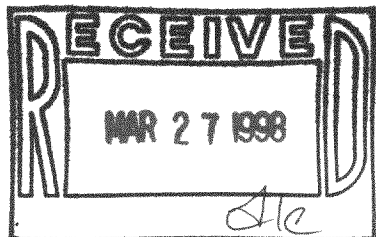


Lots 11 & 12, Block 8, Niagara Subdivision, being a part of the Northeast Quarter of Section 1, Township 4 North, Range 18 East, Town of East Troy, Walworth County, Wisconsin.

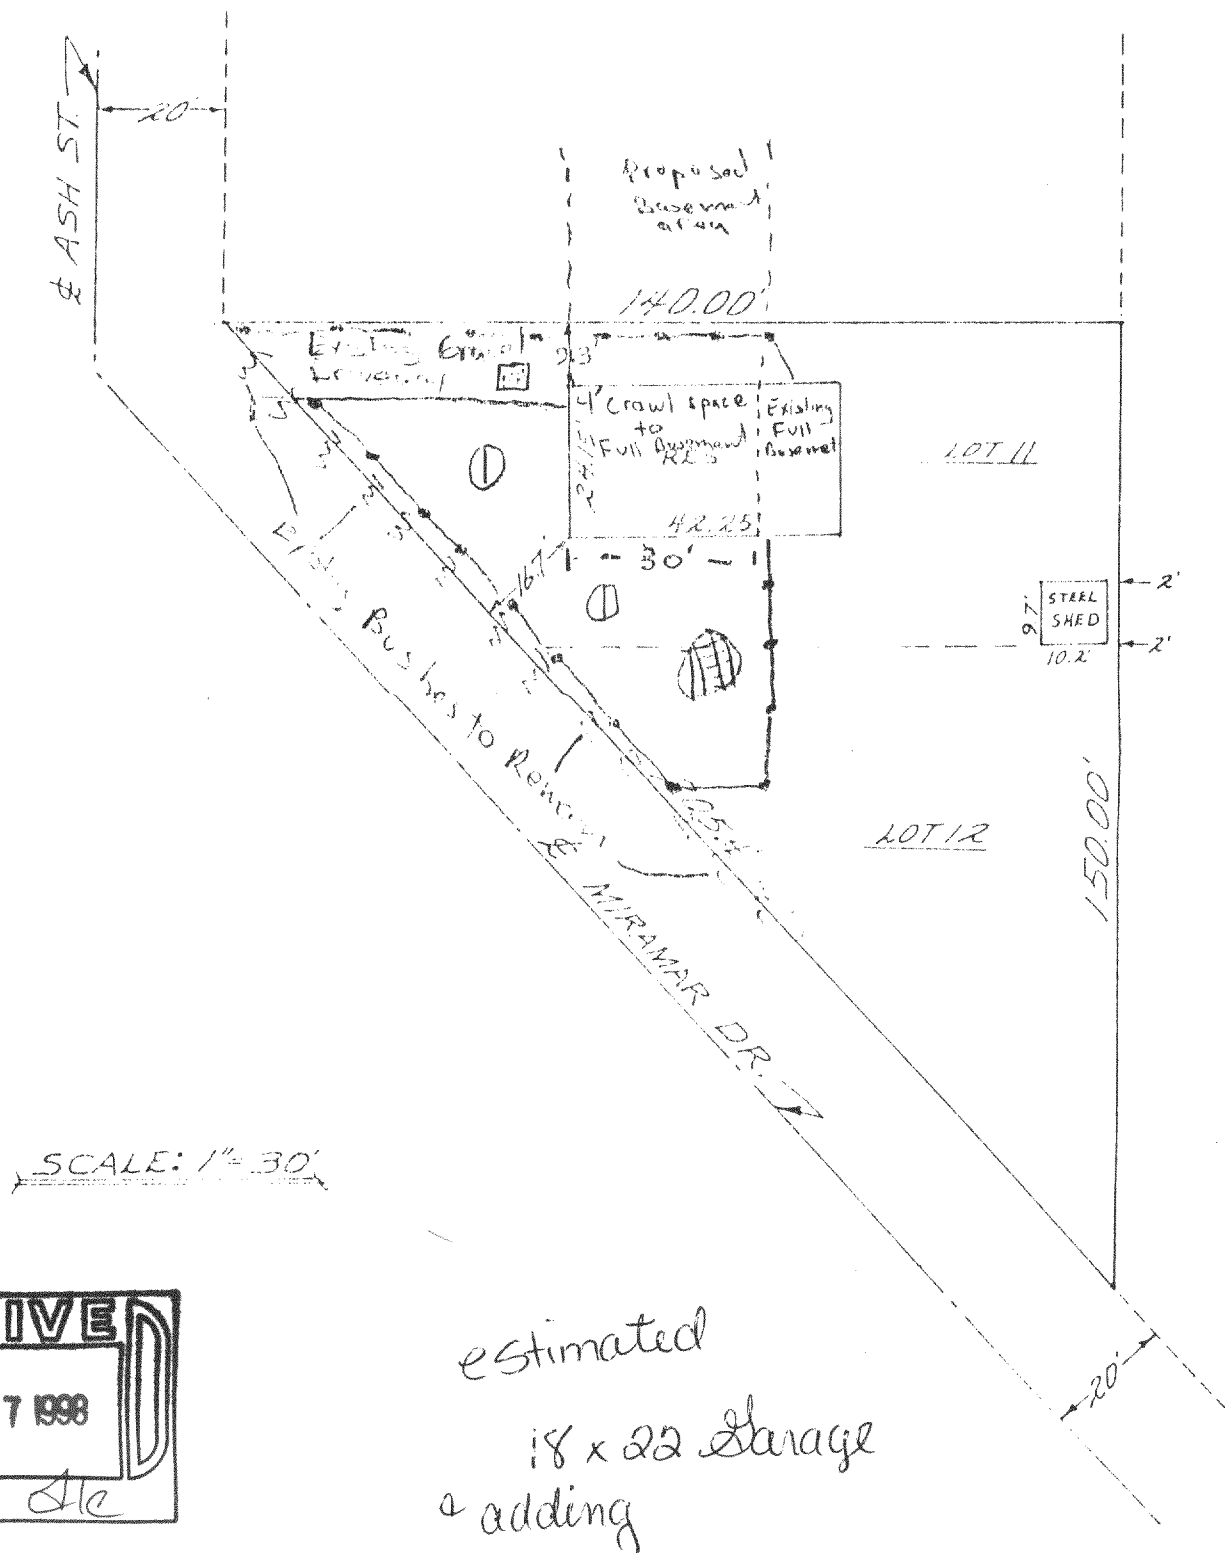

estimated
18 x 22 Garage
+ adding

ROBERT A. HILMER

I, ROBERT A. HALLMAN, DO HEREBY CERTIFY THAT THE ABOVE PLAT IS A TRUE AND CORRECT REPRESENTATION OF THE RELATIVE HORIZONTAL LOCATIONS AND DIMENSIONS OF ALL LINES AND STRUCTURES SHOWN, AS DETERMINED BY SURVEY THEREOF BASED UPON THE ABOVE DESCRIPTION AND COMPLETED THE 3TH DAY OF MAY 19 78

NOT VALID
UNLESS SEAL
IS IMPRESSED
HERE.

SIGNED

ROBERT A. HURLEY
REGISTERED WISCONSIN LAND SURVEYOR NO. 904
HURLEY ENGINEERING SERVICE
PHONE MILWAUKEE 2-8300

PMR-10ZE

418-1199