


PLAT OF SURVEY

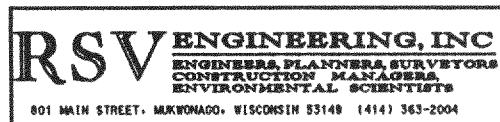

FOR: DAVE SCHMIDT REALTY

DATE: MAY 27, 1998


DESCRIPTION: LOTS 24 AND 25 OF OAKWOOD PARK, A SUBDIVISION LOCATED IN THE NORTHEAST $\frac{1}{4}$ OF SECTION 8, T4N, R18E, TOWN OF EAST TROY, WALWORTH COUNTY, WISCONSIN.

LEGEND

- IRON PIPE FOUND
- POWER POLE



SCALE 1" = 30'

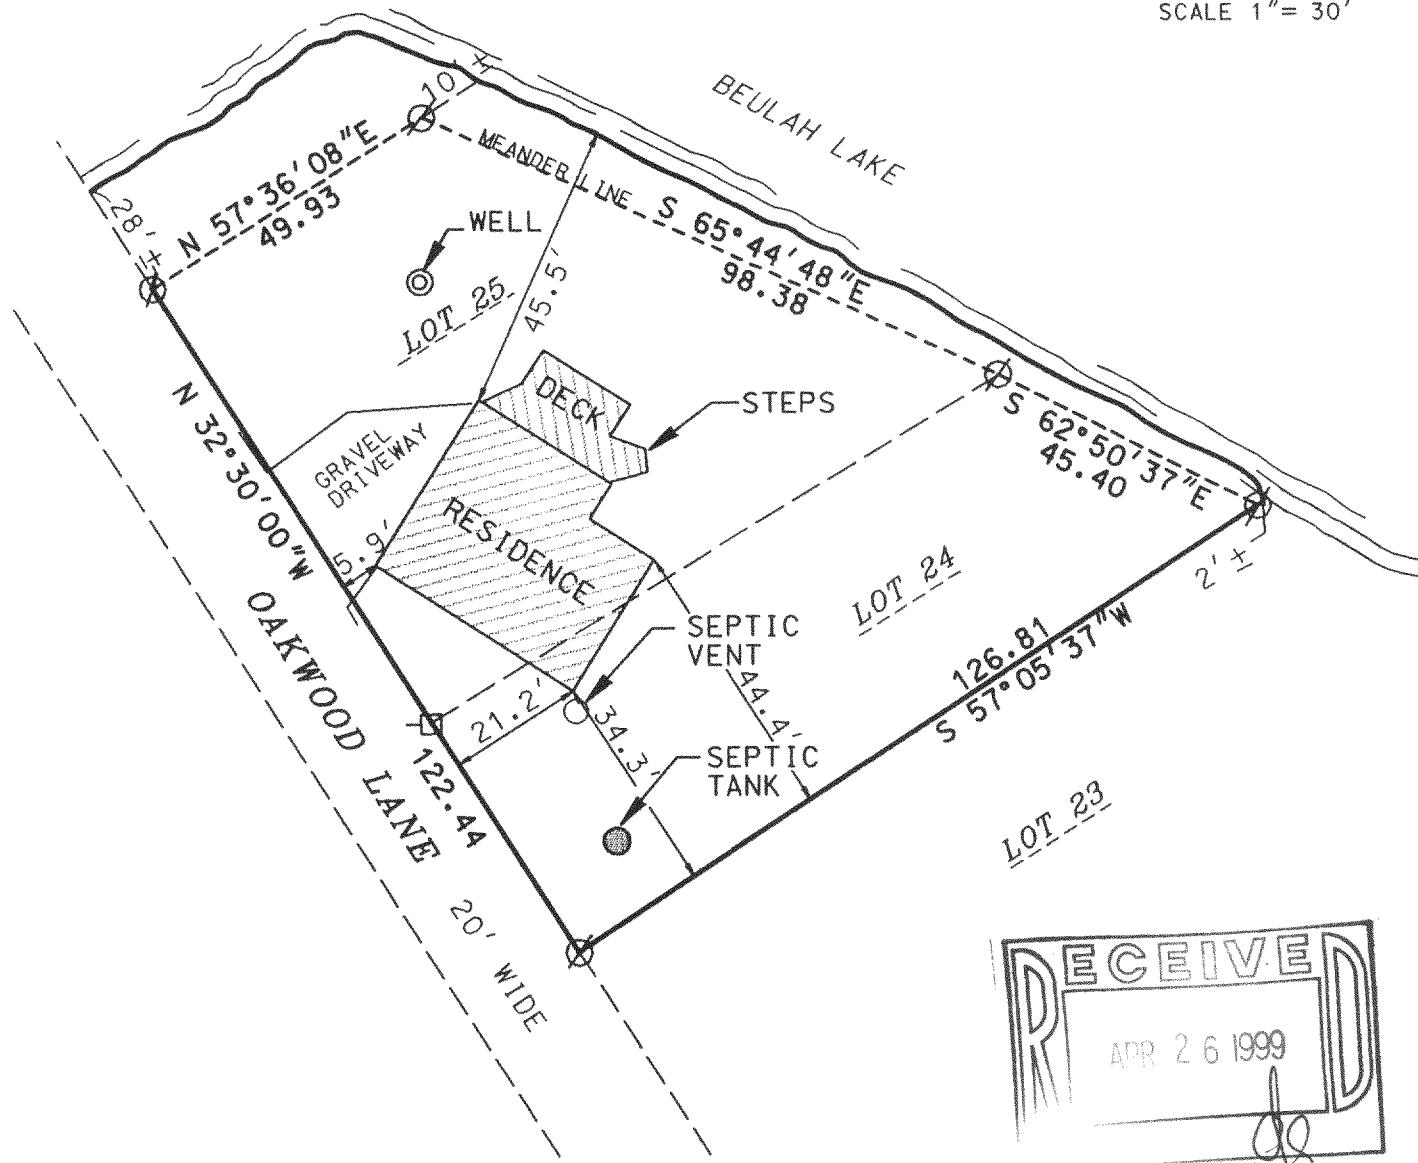

THE ABOVE MAP IS A TRUE REPRESENTATION THEREOF AND SHOWS THE SIZE AND LOCATION OF ALL THE PROPERTY, EXTERIOR BOUNDARIES, THE LOCATION OF ALL VISIBLE BOUNDARY FENCES, APPARENT EASEMENTS, ROADWAYS AND VISIBLE ENCROACHMENTS, IF ANY.

THIS SURVEY IS MADE FOR THE USE OF THE PRESENT OWNERS OF THE PROPERTY, AND ALSO THOSE WHO PURCHASE, MORTGAGE OR GUARANTEE TITLE THERETO WITHIN ONE (1) YEAR FROM DATE HERETO.

BRADFORD L. SPENCER, R.L.S. 2069
RSV# 98161

THIS IS ORIGINAL
PRINT ONLY IF
SEAL IS IMPRINTED
IN RED



418-1207

PLAT OF SURVEY



FOR: DAVE SCHMIDT REALTY

DATE: MAY 27, 1998



DESCRIPTION: LOTS 24 AND 25 OF OAKWOOD PARK, A SUBDIVISION LOCATED IN THE NORTHEAST $\frac{1}{4}$ OF SECTION 8, T4N, R18E, TOWN OF EAST TROY, WALWORTH COUNTY, WISCONSIN.

LEGEND

- IRON PIPE FOUND
- POWER POLE



SCALE 1" = 30'

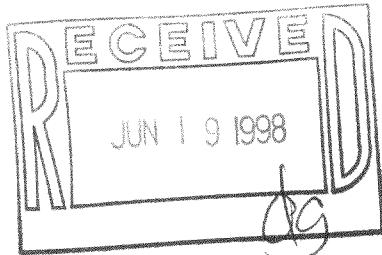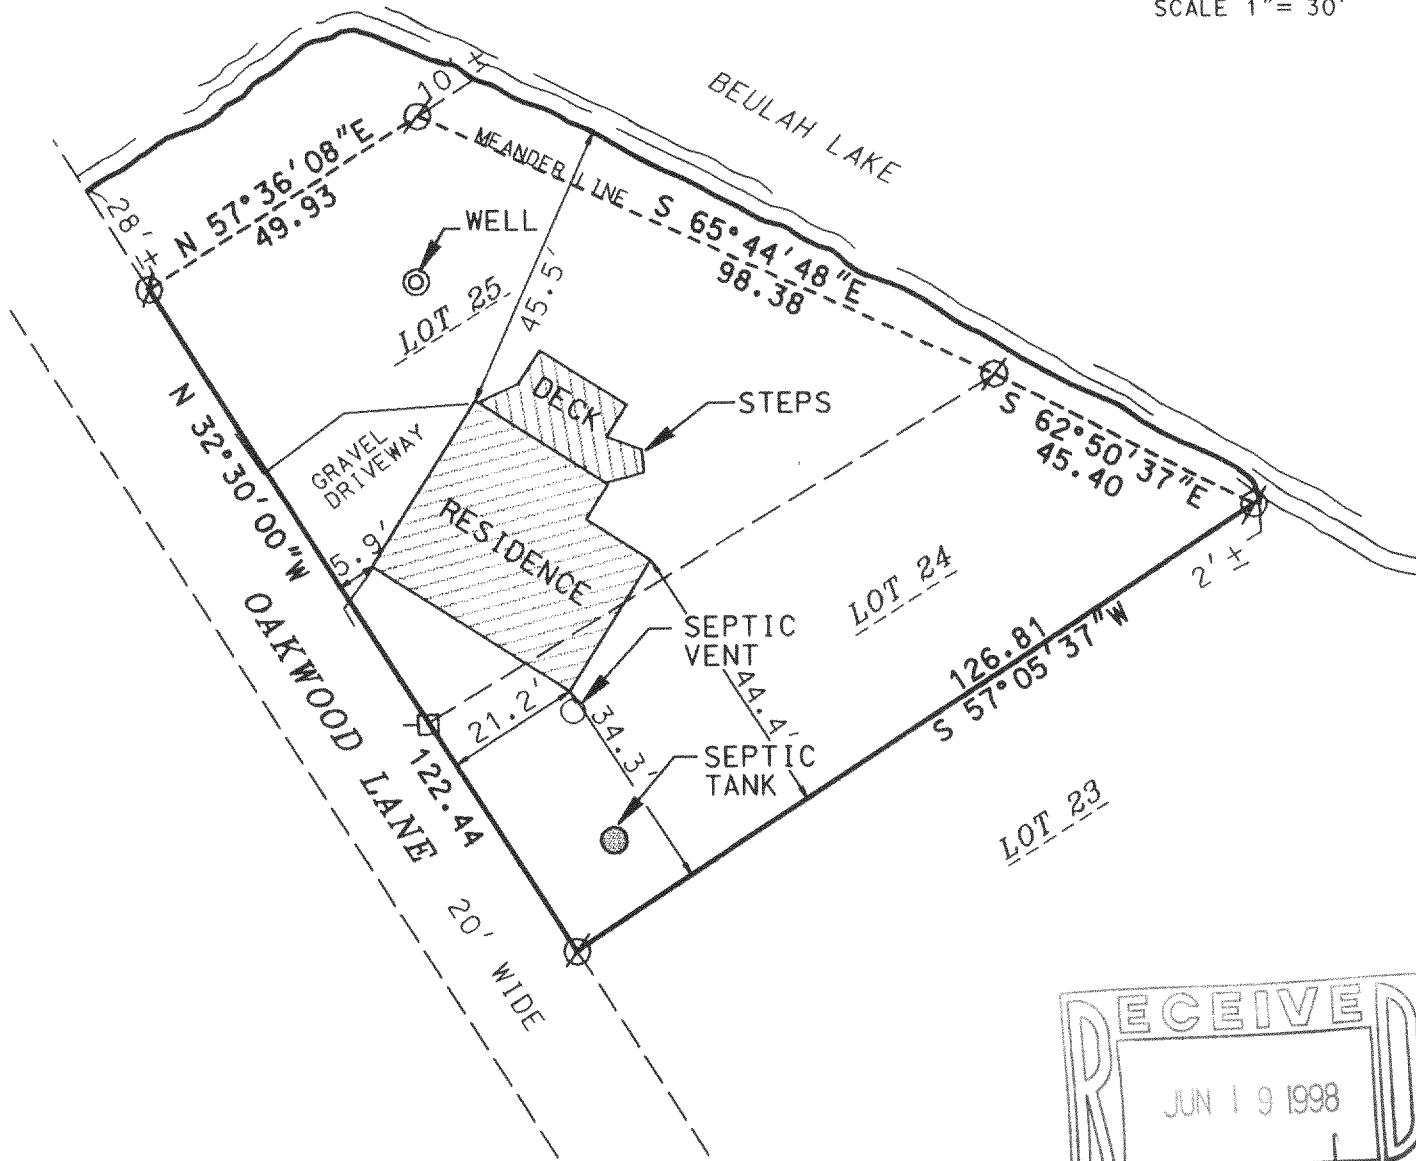

THE ABOVE MAP IS A TRUE REPRESENTATION THEREOF AND SHOWS THE SIZE AND LOCATION OF ALL THE PROPERTY, EXTERIOR BOUNDARIES, THE LOCATION OF ALL VISIBLE BOUNDARY FENCES, APPARENT EASEMENTS, ROADWAYS AND VISIBLE ENCROACHMENTS, IF ANY.

THIS SURVEY IS MADE FOR THE USE OF THE PRESENT OWNERS OF THE PROPERTY, AND ALSO THOSE WHO PURCHASE, MORTGAGE OR GUARANTEE TITLE THERETO WITHIN ONE (1) YEAR FROM DATE HERETO.

THIS IS ORIGINAL
PRINT ONLY IF
SEAL IS IMPRINTED
IN RED

BRADFORD L. SPENCER, R.L.S. 2069
RSV# 98161

418-1207

