



LAKE BEULAH

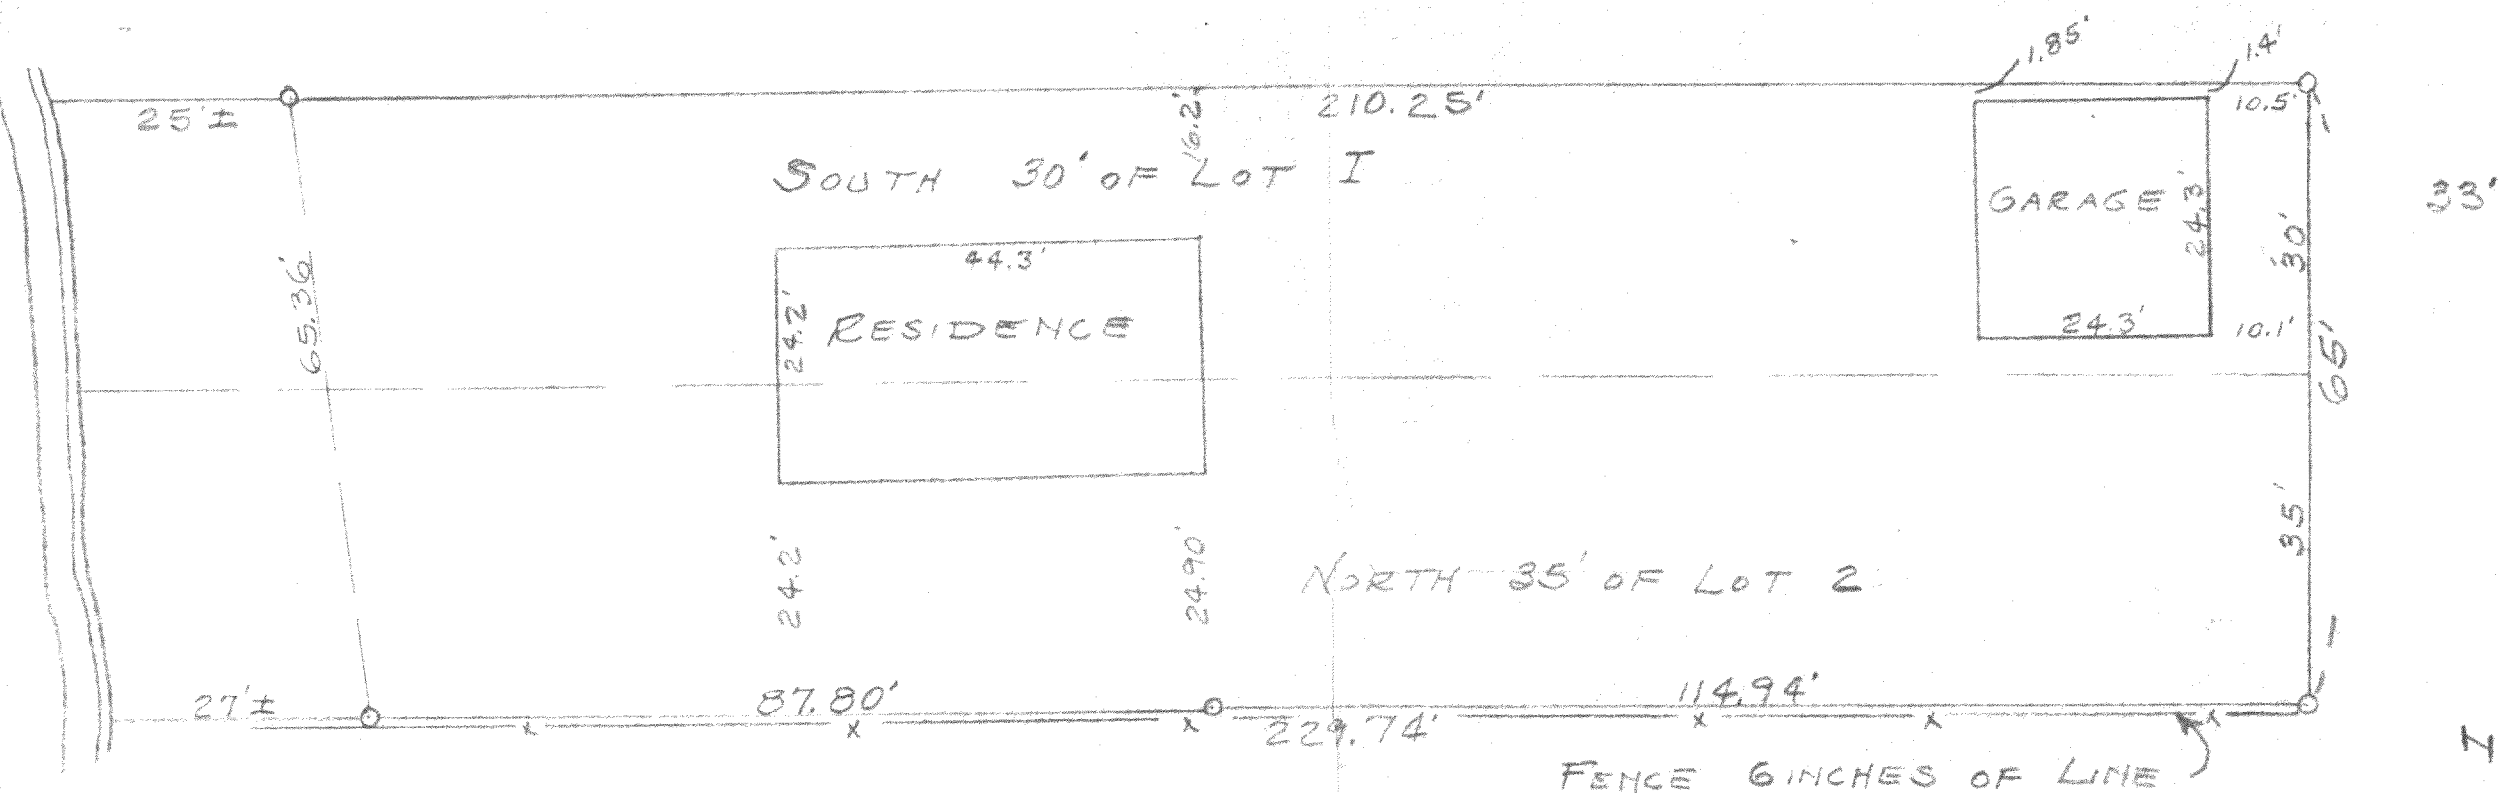

I hereby certify that I have surveyed the property described hereon
and that the above plat is an accurate survey and a true representation
thereof and correctly shows the exterior boundary lines and location and
size of the buildings on said property and the correct measurements thereof.
Dated this 13th. day of May 1965.

Lloyd L. Jensen
COUNTY SURVEYOR

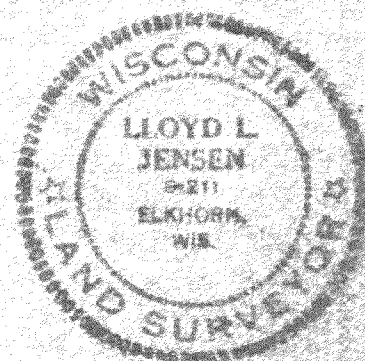

PLAT OF SURVEY OF

THE SOUTH 30 FEET OF LOT I AND
THE NORTH 35 FEET OF LOT 2 OF BEULAH
LAKE PARK SUBDIVISION LOCATED
IN SECTION 4, T4N R18E OF
WALWORTH CO., WISCONSIN.

Lloyd L. Jensen
SURVEYOR