

PLAT OF SURVEY

RSV ENGINEERING, INC
ENGINEERS, PLANNERS, SURVEYORS
CONSTRUCTION MANAGERS
ENVIRONMENTAL SCIENTISTS

FOR: THOMAS JENDERS

REVISION: 8-14-97
DATE: 7-8-97



DESCRIPTION: LOT 6, LAKE BEULAH ESTATES, BEING A DIVISION OF LOTS 4, 5, AND PART OF 3 OF STEVENS SUBDIVISION IN GOVERNMENT LOT 1, NORTH-EAST 1/4, SECTION 8, TOWNSHIP 4 NORTH, RANGE 18 EAST, IN THE TOWN OF EAST TROY, WALWORTH COUNTY, WISCONSIN.

LEGEND

- IRON PIPE FOUND
- IRON PIPE SET
- () RECORDED AS

CURVE DATA

NO.	C1
ARC	103.12
DELTA	78°46'51"
RADIUS	75.00
CH. LEN.	95.19
CH. BRG.	S20°51'00"E

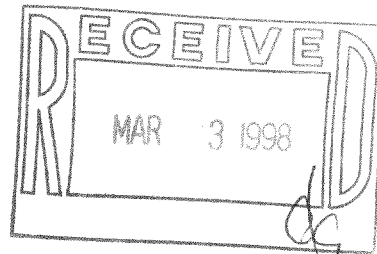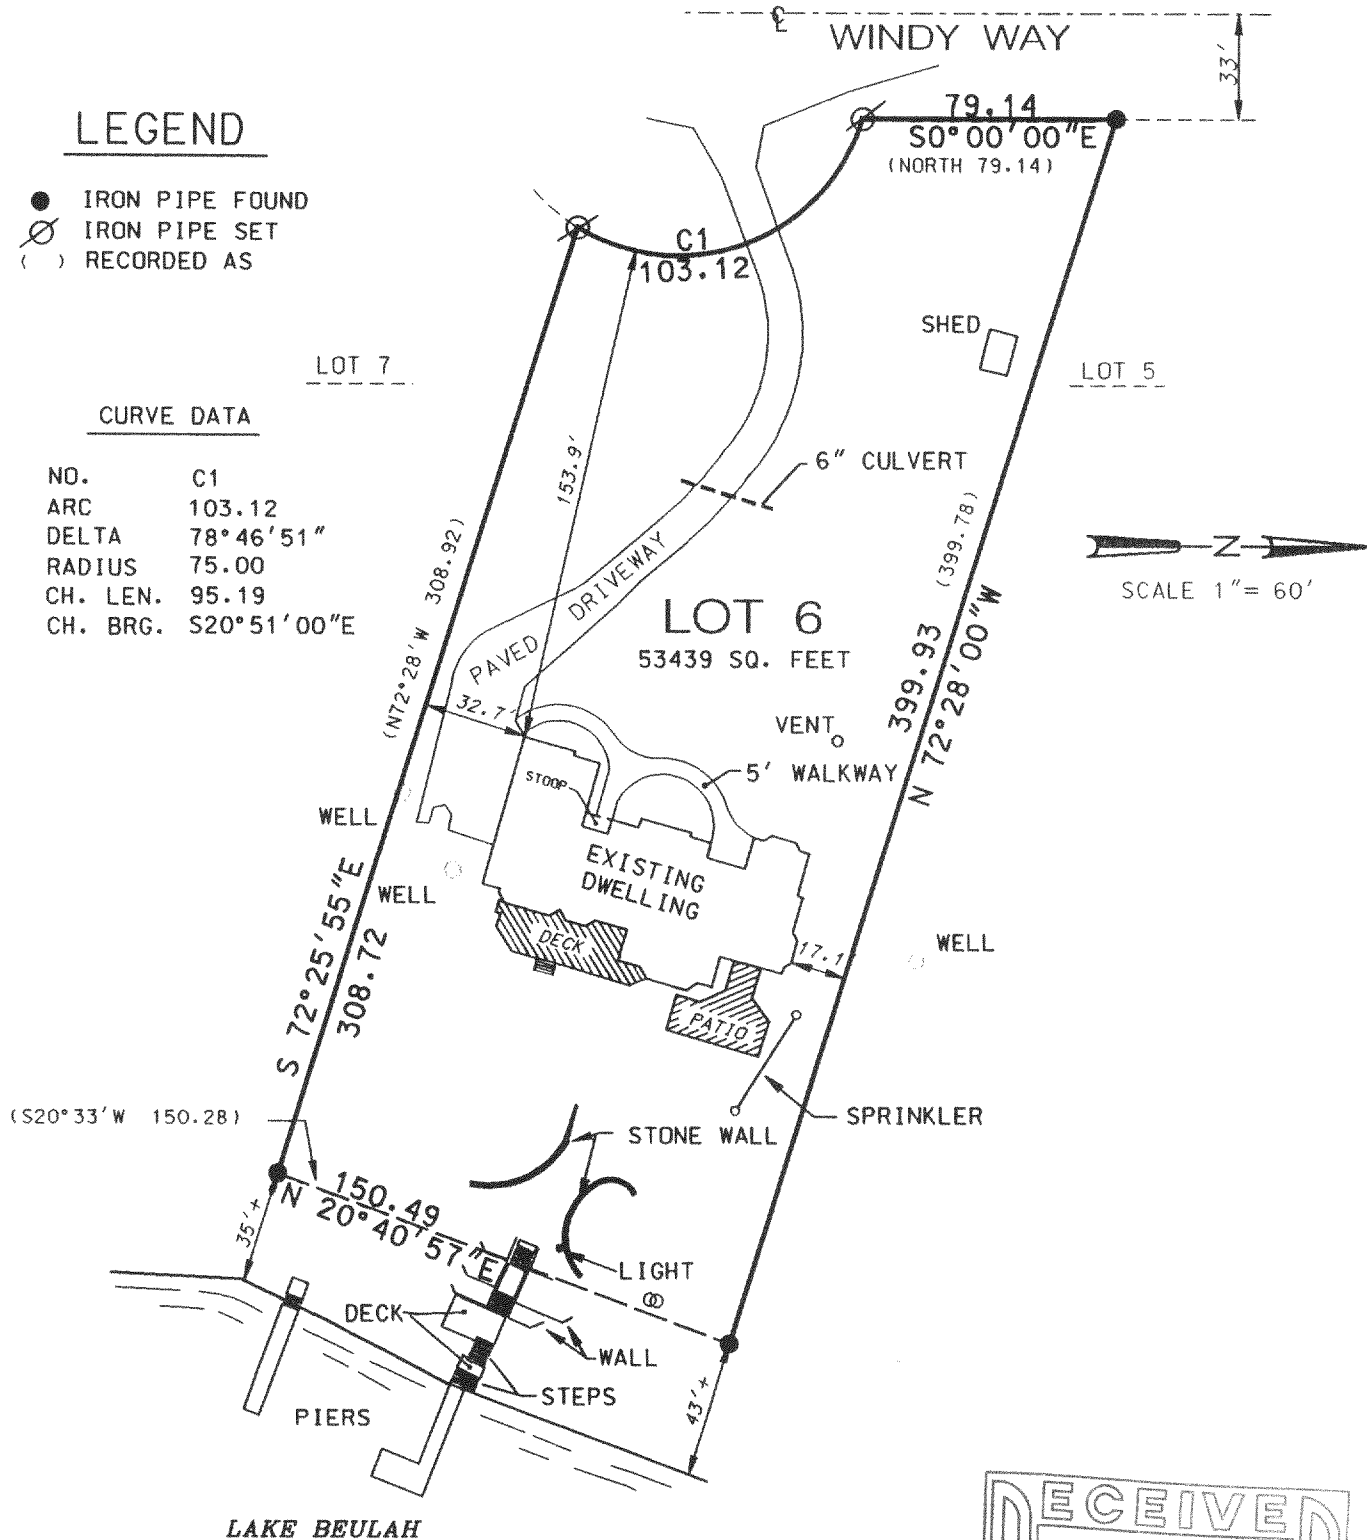

THE ABOVE MAP IS A TRUE REPRESENTATION THEREOF AND SHOWS THE SIZE AND LOCATION OF ALL THE PROPERTY, EXTERIOR BOUNDARIES, THE LOCATION OF ALL VISIBLE BOUNDARY FENCES, APPARENT EASEMENTS, ROADWAYS AND VISIBLE ENCROACHMENTS, IF ANY.

THIS SURVEY IS MADE FOR THE USE OF THE PRESENT OWNERS OF THE PROPERTY, AND ALSO THOSE WHO PURCHASE, MORTGAGE OR GUARANTEE TITLE THEREIN WITHIN ONE (1) YEAR FROM DATE HERETO.

THIS IS ORIGINAL
PRINT ONLY IF
SEAL IS IMPRINTED
IN RED



BRADFORD L. SPENCER, R.L.S. 2069
RSV#97157.DGN

PLBE-6

418-1220