


PLAT OF SURVEY



FOR: CLAIR TIEDE

DATE: 12-10-97

DESCRIPTION: LOTS 6, 7, 8 AND PART OF 9 OF OAKWOOD PARK, A SUBDIVISION LOCATED IN PART OF GOVERNMENT LOT 2 IN THE NE 1/4 OF SECTION 8, TOWN 4 NORTH, RANGE 18 EAST, TOWN OF EAST TROY, WALWORTH COUNTY, WISCONSIN, MORE PARTICULARLY DESCRIBED AS FOLLOWS: BEGINNING AT THE NORTHEAST CORNER OF SAID LOT 6, THENCE S49°34'52"E, A DISTANCE OF 169.13'; THENCE S00°00'32"W, A DISTANCE OF 231.32' TO A POINT MEANDERING THE SHORE OF LAKE BEULAH; THENCE WITH THE FOLLOWING BEARINGS AND DISTANCES ALONG A MEANDER LINE: S67°18'31"W, 52.74'; THENCE N51°04'34"W, 25.26'; THENCE N50°52'25"W, 77.88' TO A MEANDER POINT ON THE WEST LINE OF SAID LOT 6; THENCE N00°00'00"E, 296.31' TO THE POINT OF BEGINNING. ALSO INCLUDING LANDS BETWEEN THE MEANDER LINE AND THE HIGH WATER LINE OF LAKE BEULAH. SAID PARCEL CONTAINING 0.835 ACRES, MORE OR LESS.

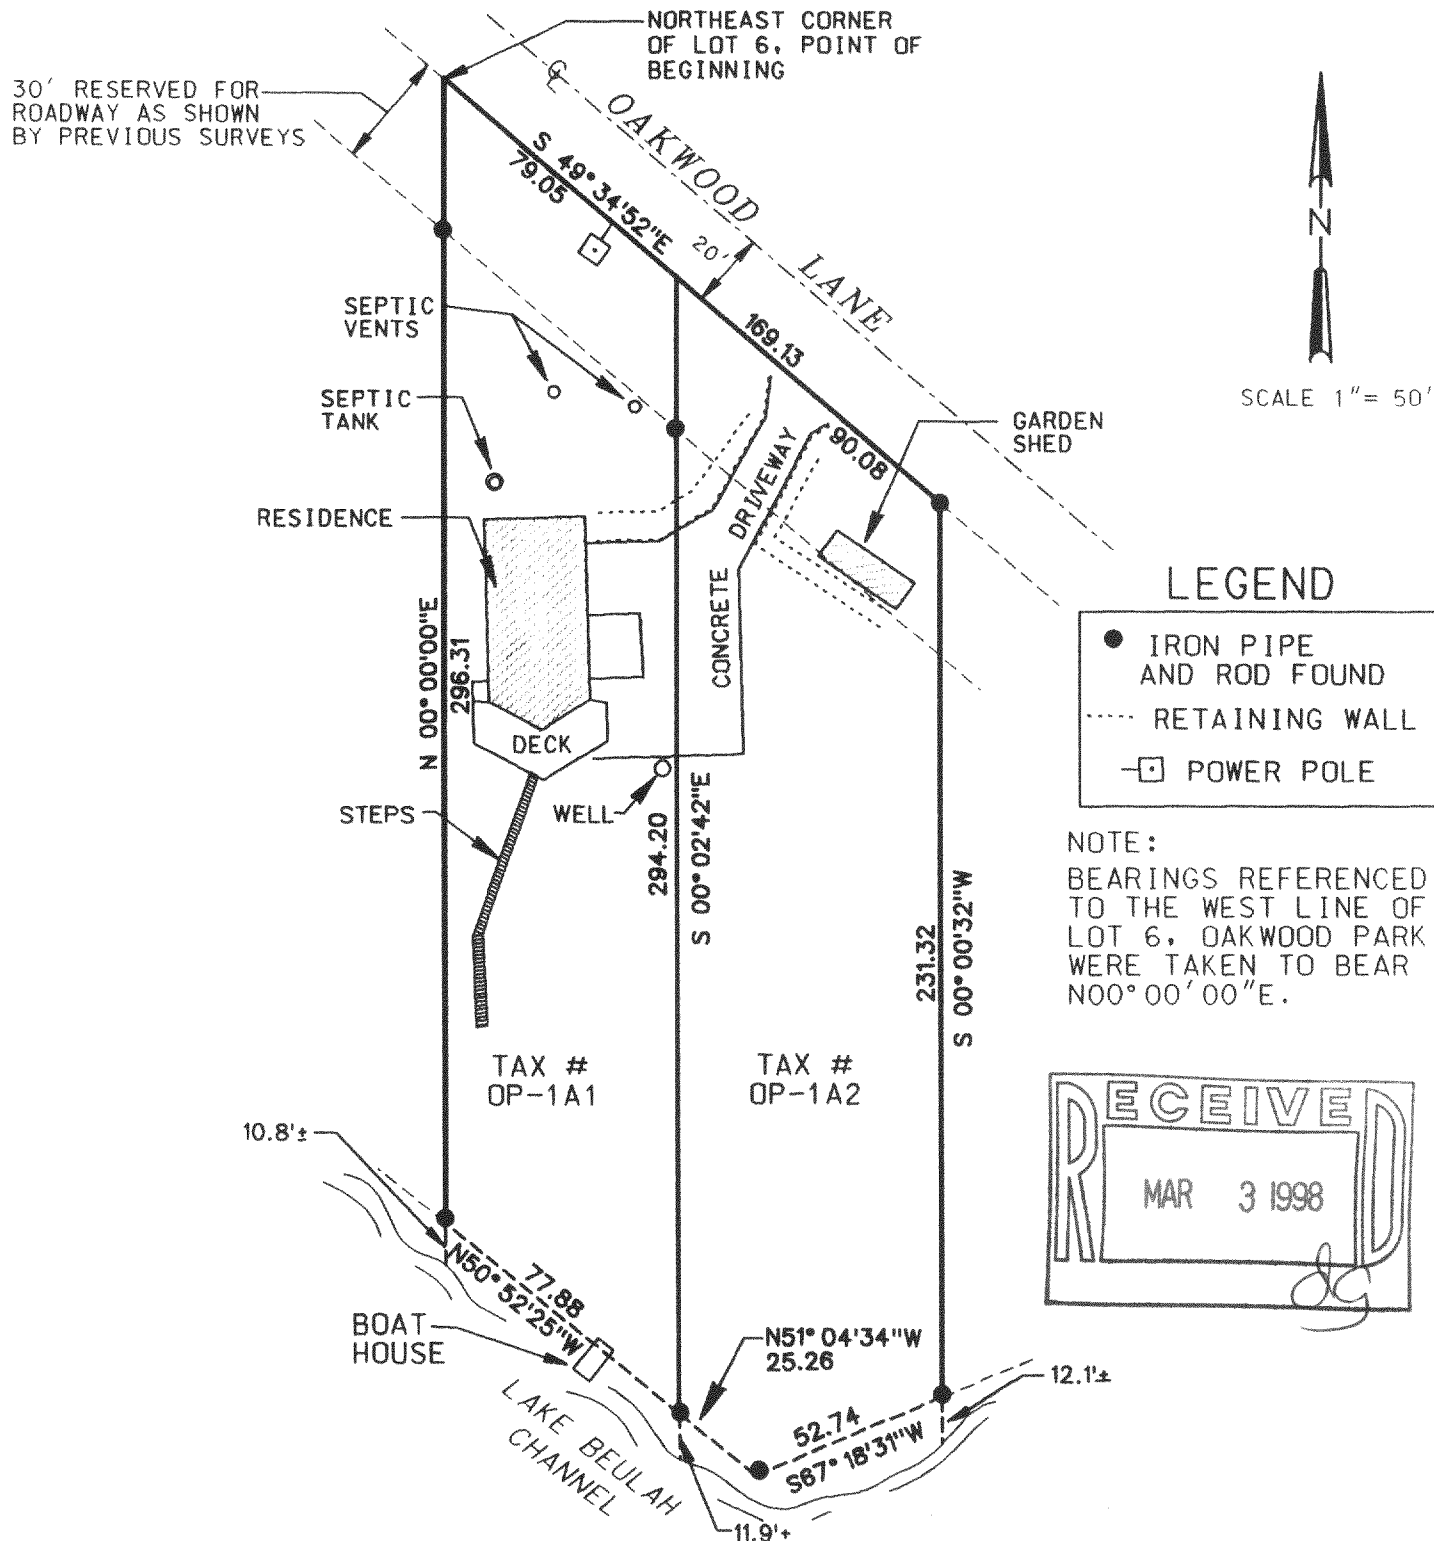

THE ABOVE MAP IS A TRUE REPRESENTATION THEREOF AND SHOWS THE SIZE AND LOCATION OF ALL THE PROPERTY, EXTERIOR BOUNDARIES, THE LOCATION OF ALL VISIBLE BOUNDARY FENCES, APPARENT EASEMENTS, ROADWAYS AND VISIBLE ENCROACHMENTS, IF ANY.

THIS SURVEY IS MADE FOR THE USE OF THE PRESENT OWNERS OF THE PROPERTY, AND ALSO THOSE WHO PURCHASE, MORTGAGE OR GUARANTEE TITLE THEREIN WITHIN ONE (1) YEAR FROM DATE HERETO.

THIS IS ORIGINAL
PRINT ONLY IF
SEAL IS IMPRINTED
IN RED

BRADFORD L. SPENCER, R.L.S. 2069
RSV#97382



OP-1A1 OP-1A2

418-1221